

HARRISON and WALKER.

PROPERTY LINE

DRIFT NOS.

AIR SHAF

NO 8. ENTRANCE ELEV. 1407.8

N

D.D.H. NO 152.
1919 CAMPBELL
SUR. 1491.9
BOT. CLAY 1461.9
2' 0" COAL
8' 0" CLAY
BURNED CORE SHOWS 2' 0" GOOD CLAY

D.D.H. NO 151.
1919 CAMPBELL
SUR. 1473.8
BOT. CLAY 1454.8
1' 0" COAL
8' 10" CLAY
BURNED CORE SHOWS 3' 0" FAIRLY GOOD CLAY

D.D.H. NO 207.
1919 CAMPBELL
SUR. 1477.8
BOT. CLAY 1433.8

D.D.H. NO 168.
1919 CAMPBELL.
SUR. 1479.7
BOT. CLAY 1449.7
CLAY 2' 0"
BURNED CORE SHOWS 3' 0" FAIRLY GOOD CLAY

D.D.H. NO 177.
1919 CAMPBELL
SUR. 1472.8

D.D.H. NO 178.
1919 CAMPBELL
SUR. 1476.7
BOT. CLAY 1442.7
BURNED CORE SHOWS
GOOD CLAY

D.D.H. NO 214.
1919 CAMPBELL
SUR. 1463.6
BOT. CLAY 1439.4
CLAY 2' 0"
BURNED CORE SHOWS
CLAY 3' 0" BURNED CLAY
CLAY 2' 0" GOOD CLAY
CLAY 3' 0" NOT GOOD

D.D.H. NO 194.
1919 CAMPBELL
SUR. 1470.1

D.D.H. NO 227.
1919 CAMPBELL.

D.D.H. NO 74.
1919 CHAPMAN
CLAY NOT GOOD.

D.D.H. NO 139.
1919 CAMPBELL
BURNED CORE SHOWS
NOT GOOD.
3' 0" COAL
5' 0" CLAY

D.D.H. NO 64.
1919 CHAPMAN
CLAY NOT GOOD.

D.D.H. NO 129.
1919 CAMPBELL.
BURNED CORE SHOWS
3' 0" FAIRLY GOOD CLAY
3' 0" COAL
5' 0" CLAY

D.D.H. NO 94.
1919 CHAPMAN


D.D.H. NO 114.
1919 CAMPBELL
BURNED CORE
SHOWS 3' 0" GOOD CLAY
COAL 0' 0"
CLAY 10' 0"

D.D.H. NO 202.
1919 CAMPBELL
BURNED CORE SHOWS NOT GOOD
3' 0" COAL
7' 0" CLAY

D.D.H. NO 108.
1919 CAMPBELL
BURNED CORE SHOWS 2' 0" GOOD CLAY
3' 0" COAL

OLD DRILL HOLE
NO 6.
7' 0" SOFT CLAY

NO 6. DRIFT

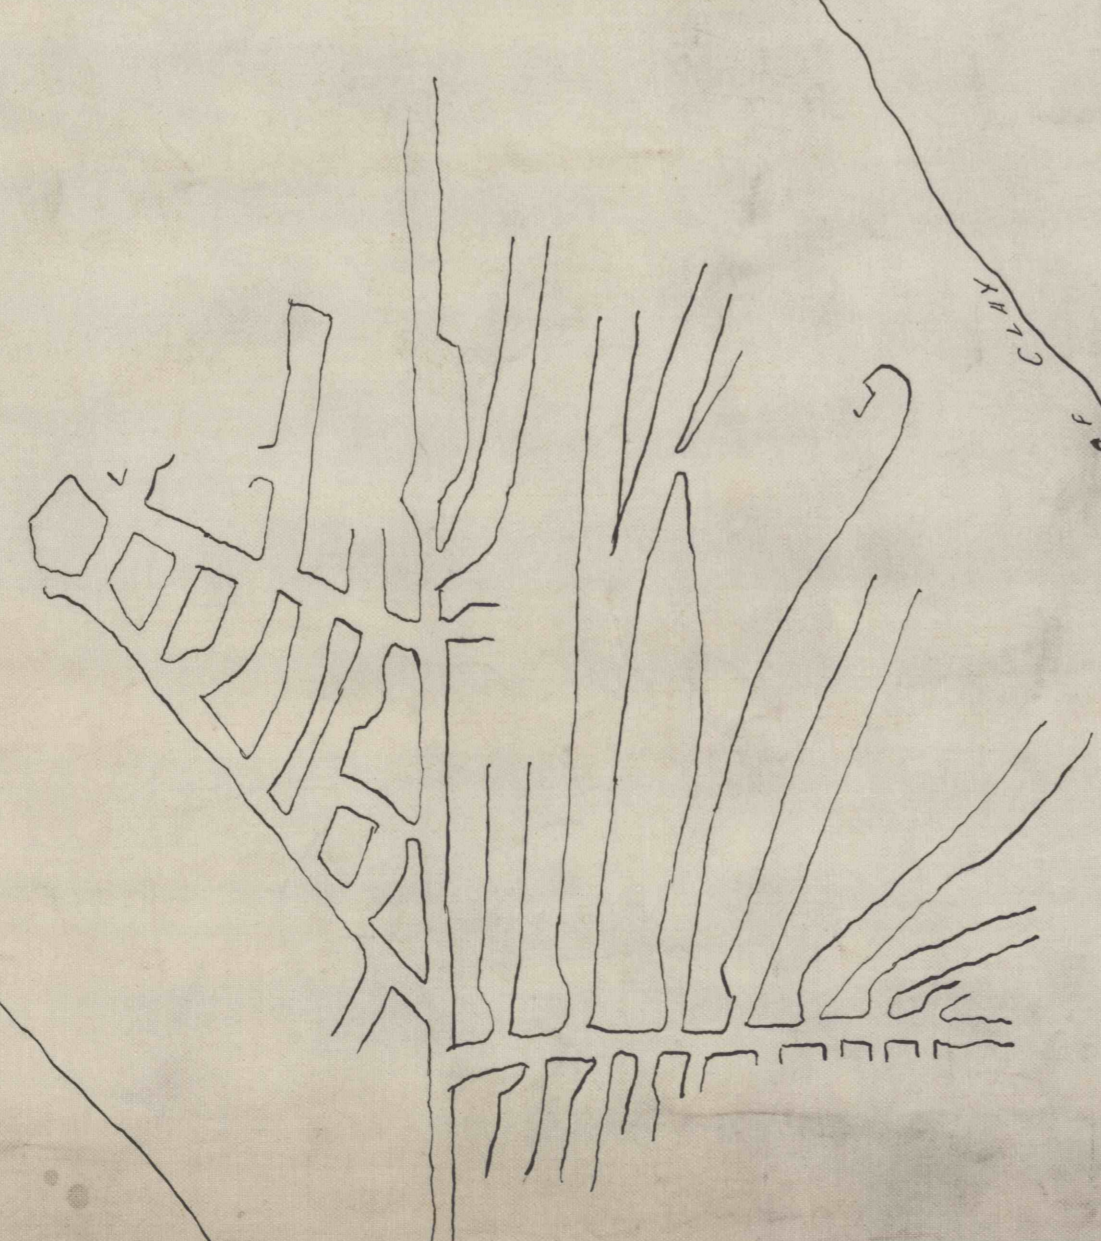

MAP
Showing Drill Holes drilled in 1919
Nos. 152, 151, 207, 168, 177, 178, 214, 194, 227,
River Hill
QUEENS RUN FIRE BRICK CO.,
SCALE 100' TO 1" INCH.