



M^{rs} GALL TRACT


NEW SHAWMUT MINING CO.

NEW SHAWMUT MINING CO.

WORKED OUT BY NEW SHAWMUT MINING CO.

-TO GRAY FARM

NOTE:
 EXISTING MINE DRAINAGE PERMIT NO. 266 MO 39
 APPROX. OLD WORK AREA OUTLINED IN RED
 OWENS PROPOSED MINING OUTLINED IN YELLOW

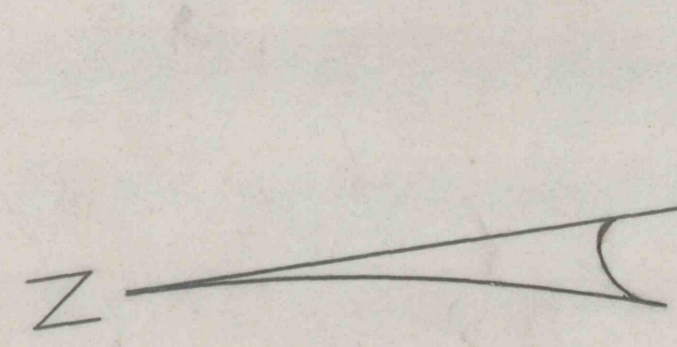

NEW SHAWMUT MINING CO.

MAP SHOWING L. KITTANNING DEEP MINE WORKINGS
 OPERATED BY JOSEPH OWENS
 JAY TOWNSHIP ELK COUNTY PENNSYLVANIA
 SCALE 1 1/2" = 100' - JULY 25, 1968
 BERNARD LUCAS ASSOCIATES

C.D. 633

2201