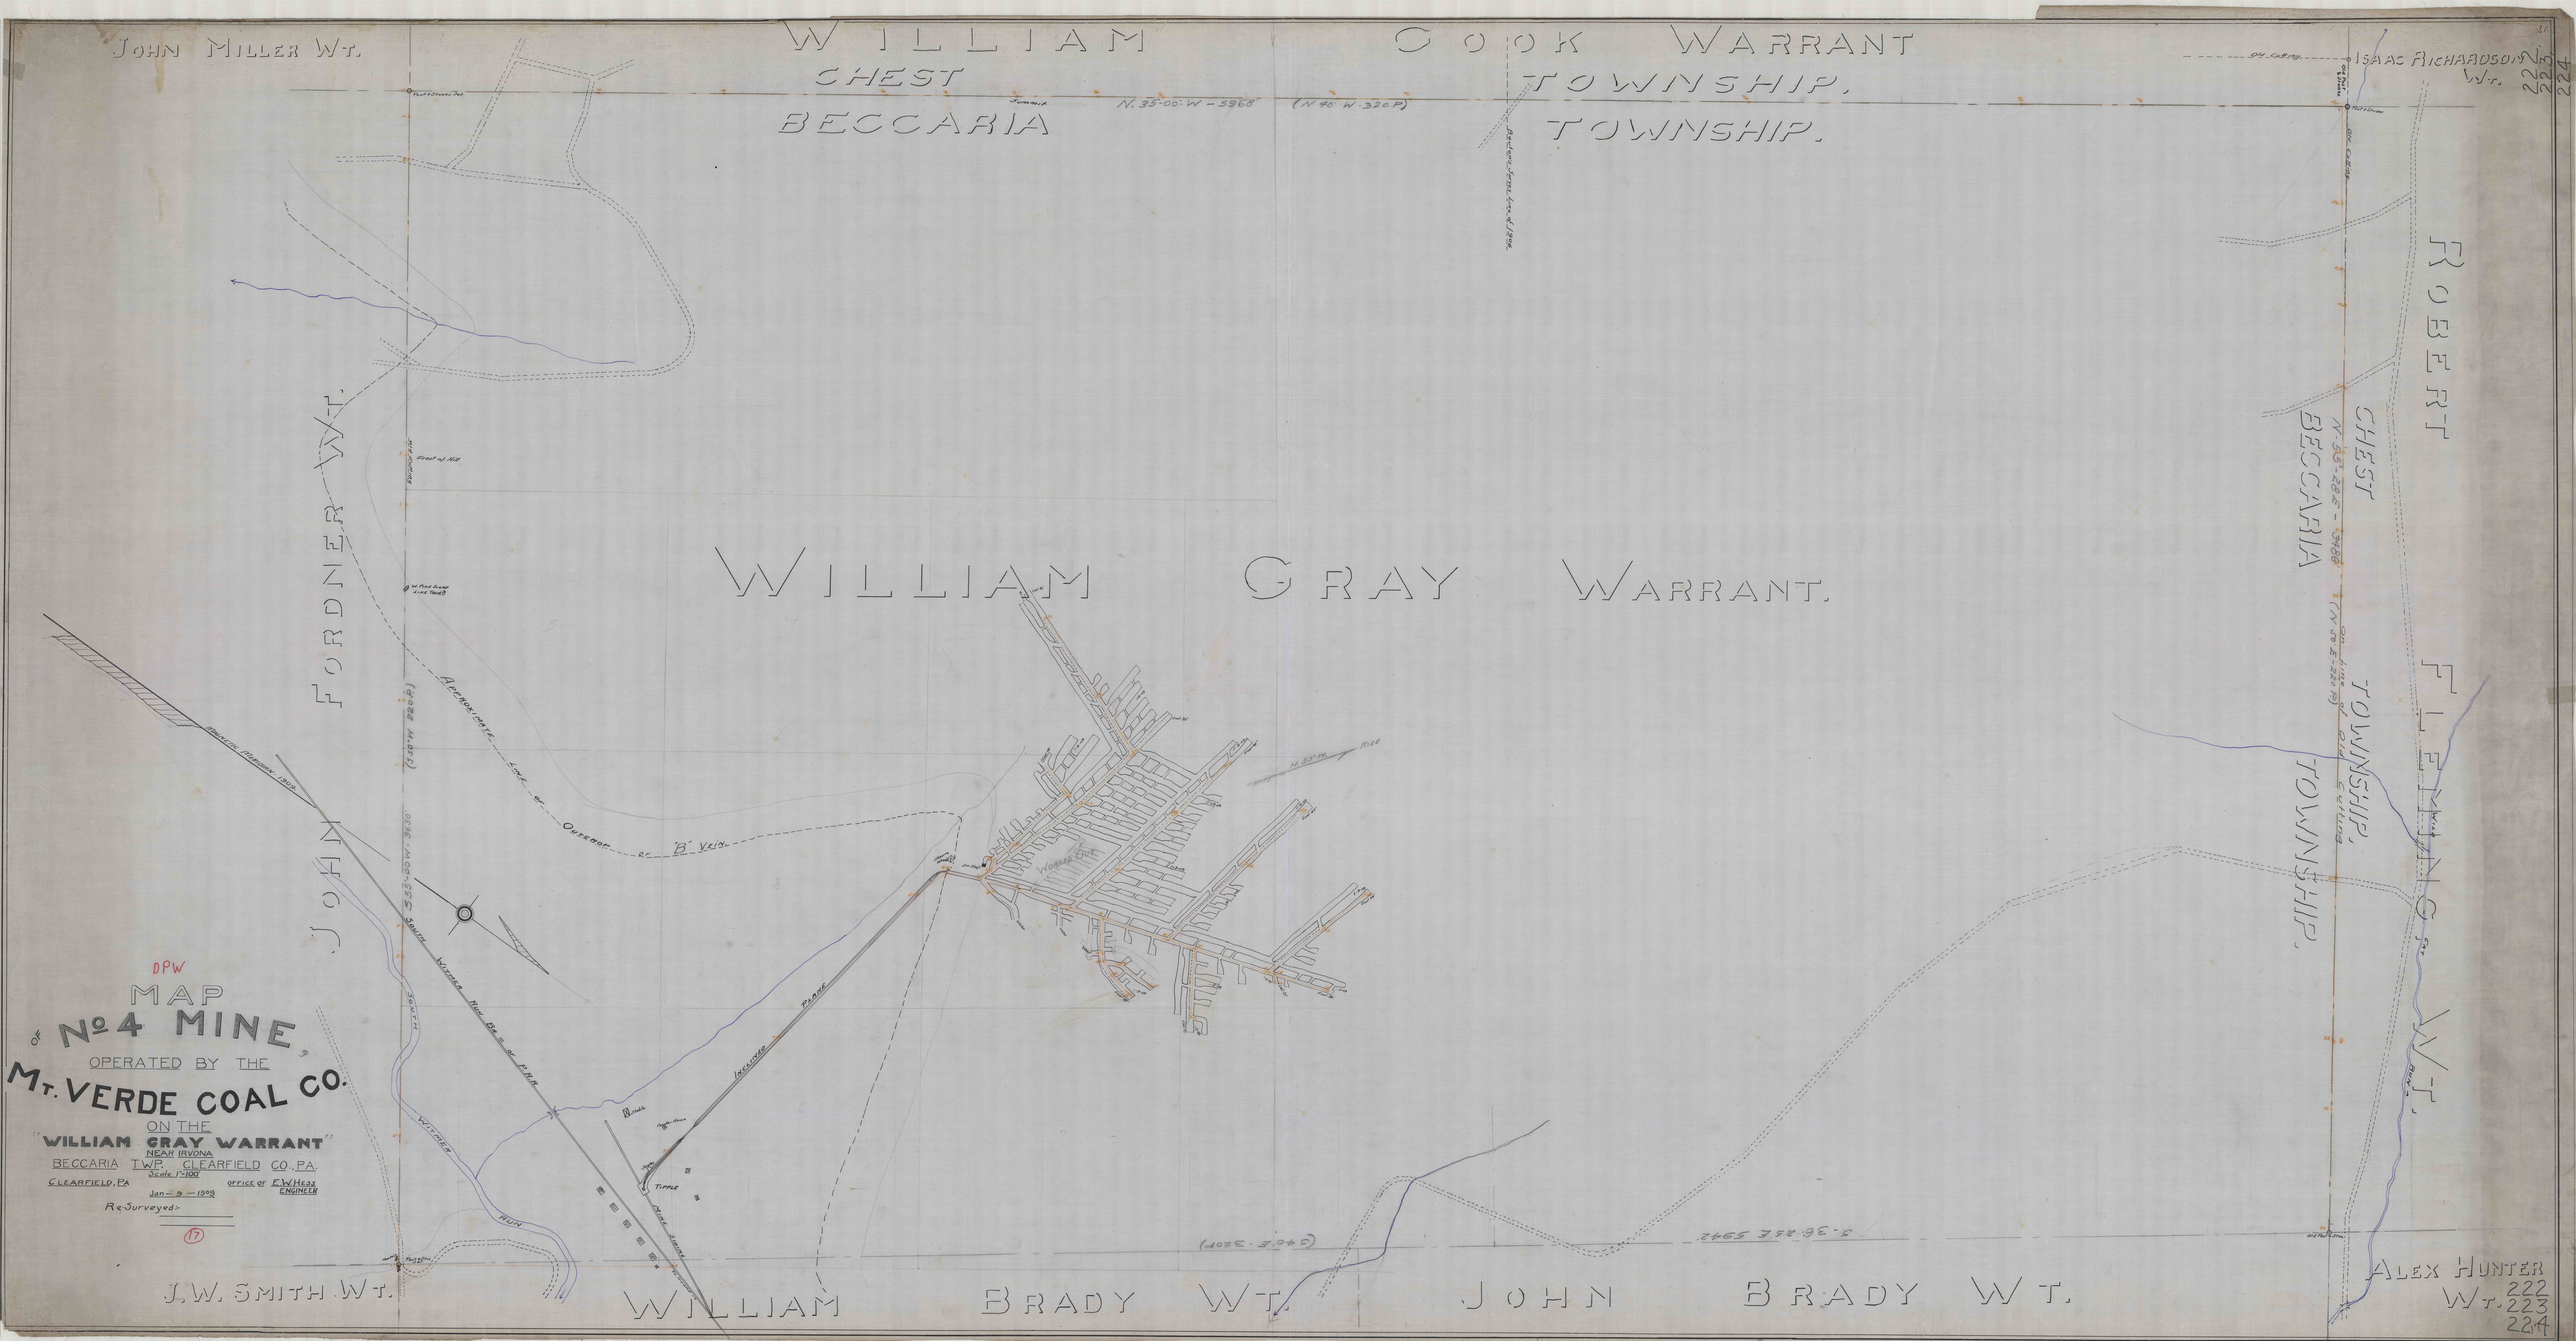
JOHN MILLER WT.
WILLIAM COOK WARRANT
CHEST
TOWNSHIP.
BECCARIA
TOWNSHIP.
ISAAC RICHARDSON WT. 222 223 224
WILLIAM GRAY WARRANT.
FORDNER WT.
JOHN
ROBERT FLEMING WT.
CHEST
TOWNSHIP.
BECCARIA
TOWNSHIP.
N. 35°-00'-W - 59.68
(N 40° W - 320 P)
Irvona
Beccaria Twp.
Clearfield Co.
Pa.
Scale 1"=100'
Re-Surveyed
(17)
DPW
MAP
OF
No 4 MINE,
OPERATED BY THE
MT. VERDE COAL CO.
ON THE
"WILLIAM GRAY WARRANT"
NEAR IRVONA
BECCARIA T.WP. CLEARFIELD CO. PA.
CLEARFIELD, PA
office of F.W. HESS ENGINEER
Approximate Property Line
Acreage Mark - Line of Outcrop of "B" Vein
Incline Plane
Tipple
Worked Out
WITMER RUN
SOUTH
J.W. SMITH WT.
WILLIAM BRADY WT.
JOHN BRADY WT.
ALEX HUNTER WT. 222 223 224