


226
222

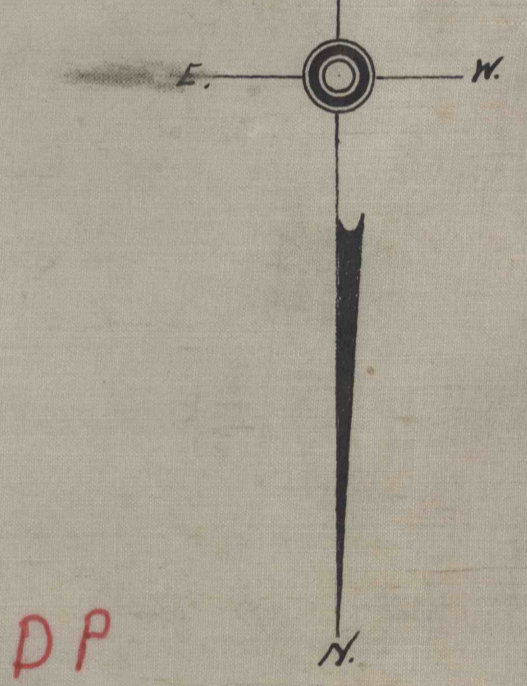

A.E. WOOLBIDGE & G.B. SHIVERY
WOODLAND CANNEL COAL CO.
 MAP OF CANNEL COAL MINES,
 BRADFORD TWP. CLEARFIELD CO., PA.

SCALE 1"=100'

CLEARFIELD PA. Part 1 ① OFFICE OF E.W. HESS,
 ENGINEER.

Dec. 17 1912
 Surveyed Dec. 3-4-1912
 " July 31-1913
 " January 10-11-1916
 " February 12-13-1917
 " February 26-27-1918
 " November 25-27-1918
 " August 10-13, 1920.

A.B. LANDSBERY

JEROME B. WILSON
 4933 AS

SAMUEL B. WILSON
 100 AS

516 AS