

5555

5555

now or formerly Riemer

D

MAP SHOWING
REITER BROS. COAL CO.
 OPERATIONS ON THE
COLBY TRACT
 HUSTON TWP., CLEARFIELD CO., PA.
SCALE - 1 in = 100 ft.
 November 18, 1947 Engineering Offices
 Clearfield, Penna. Yost, Bromfield & Hess
 264/41

1263

J. A. & Mary Colby
90 Acres ±


Penna State Forest

10 Acre Tract

Forest

State #2001

Penna. Warrant

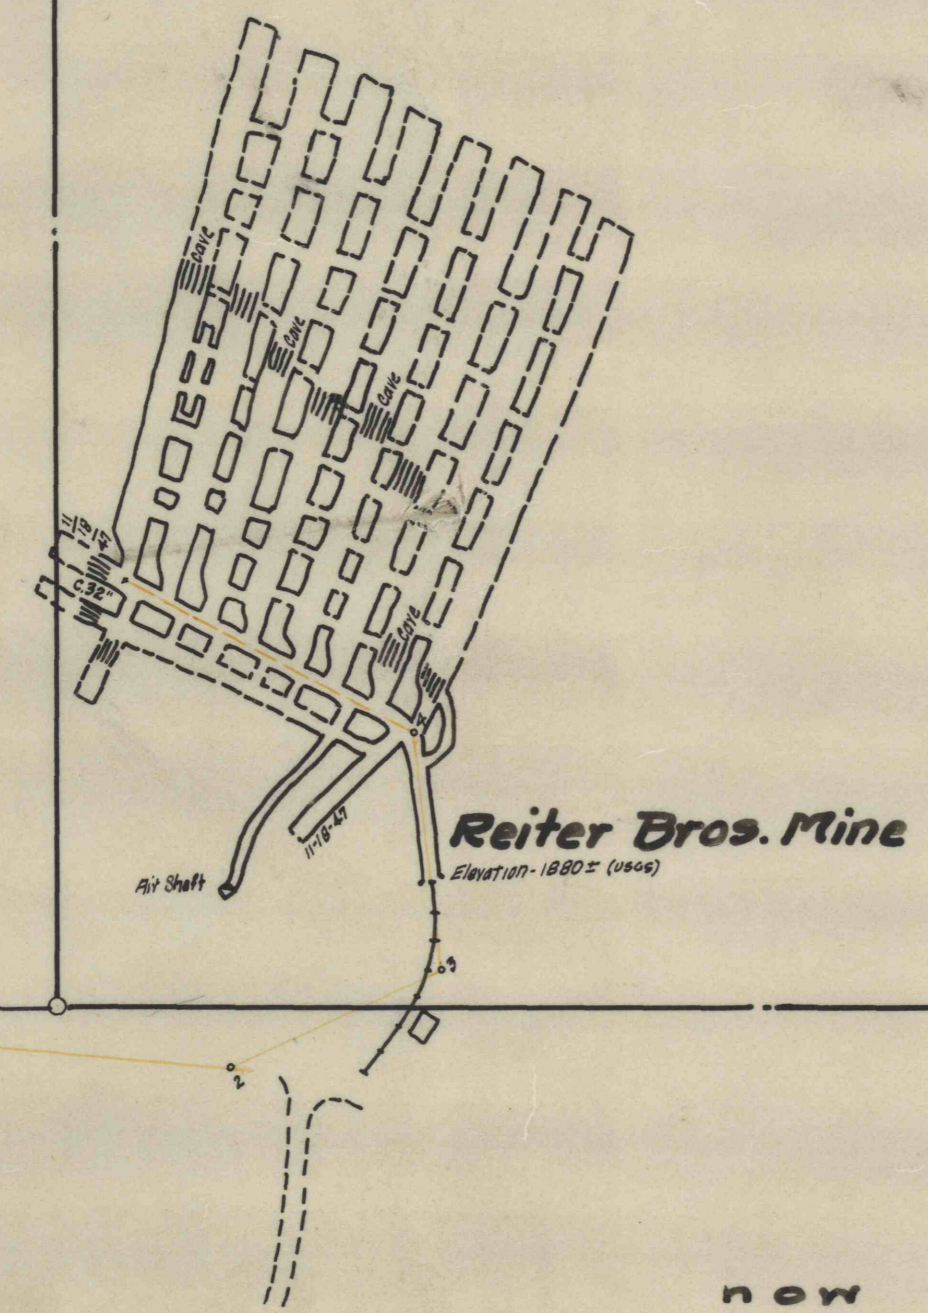

now or formerly Harry F. Owens

2267

1503