

MD

CATHCART COAL CO.


MAP OF  
"D" Seam Coal Mine  
Knox Township, Clearfield Co., Pa.

SCALE - 1 in. = 100 FT.

July 2, 1951  
Clearfield, Pa.

Engineering Offices  

1324-A

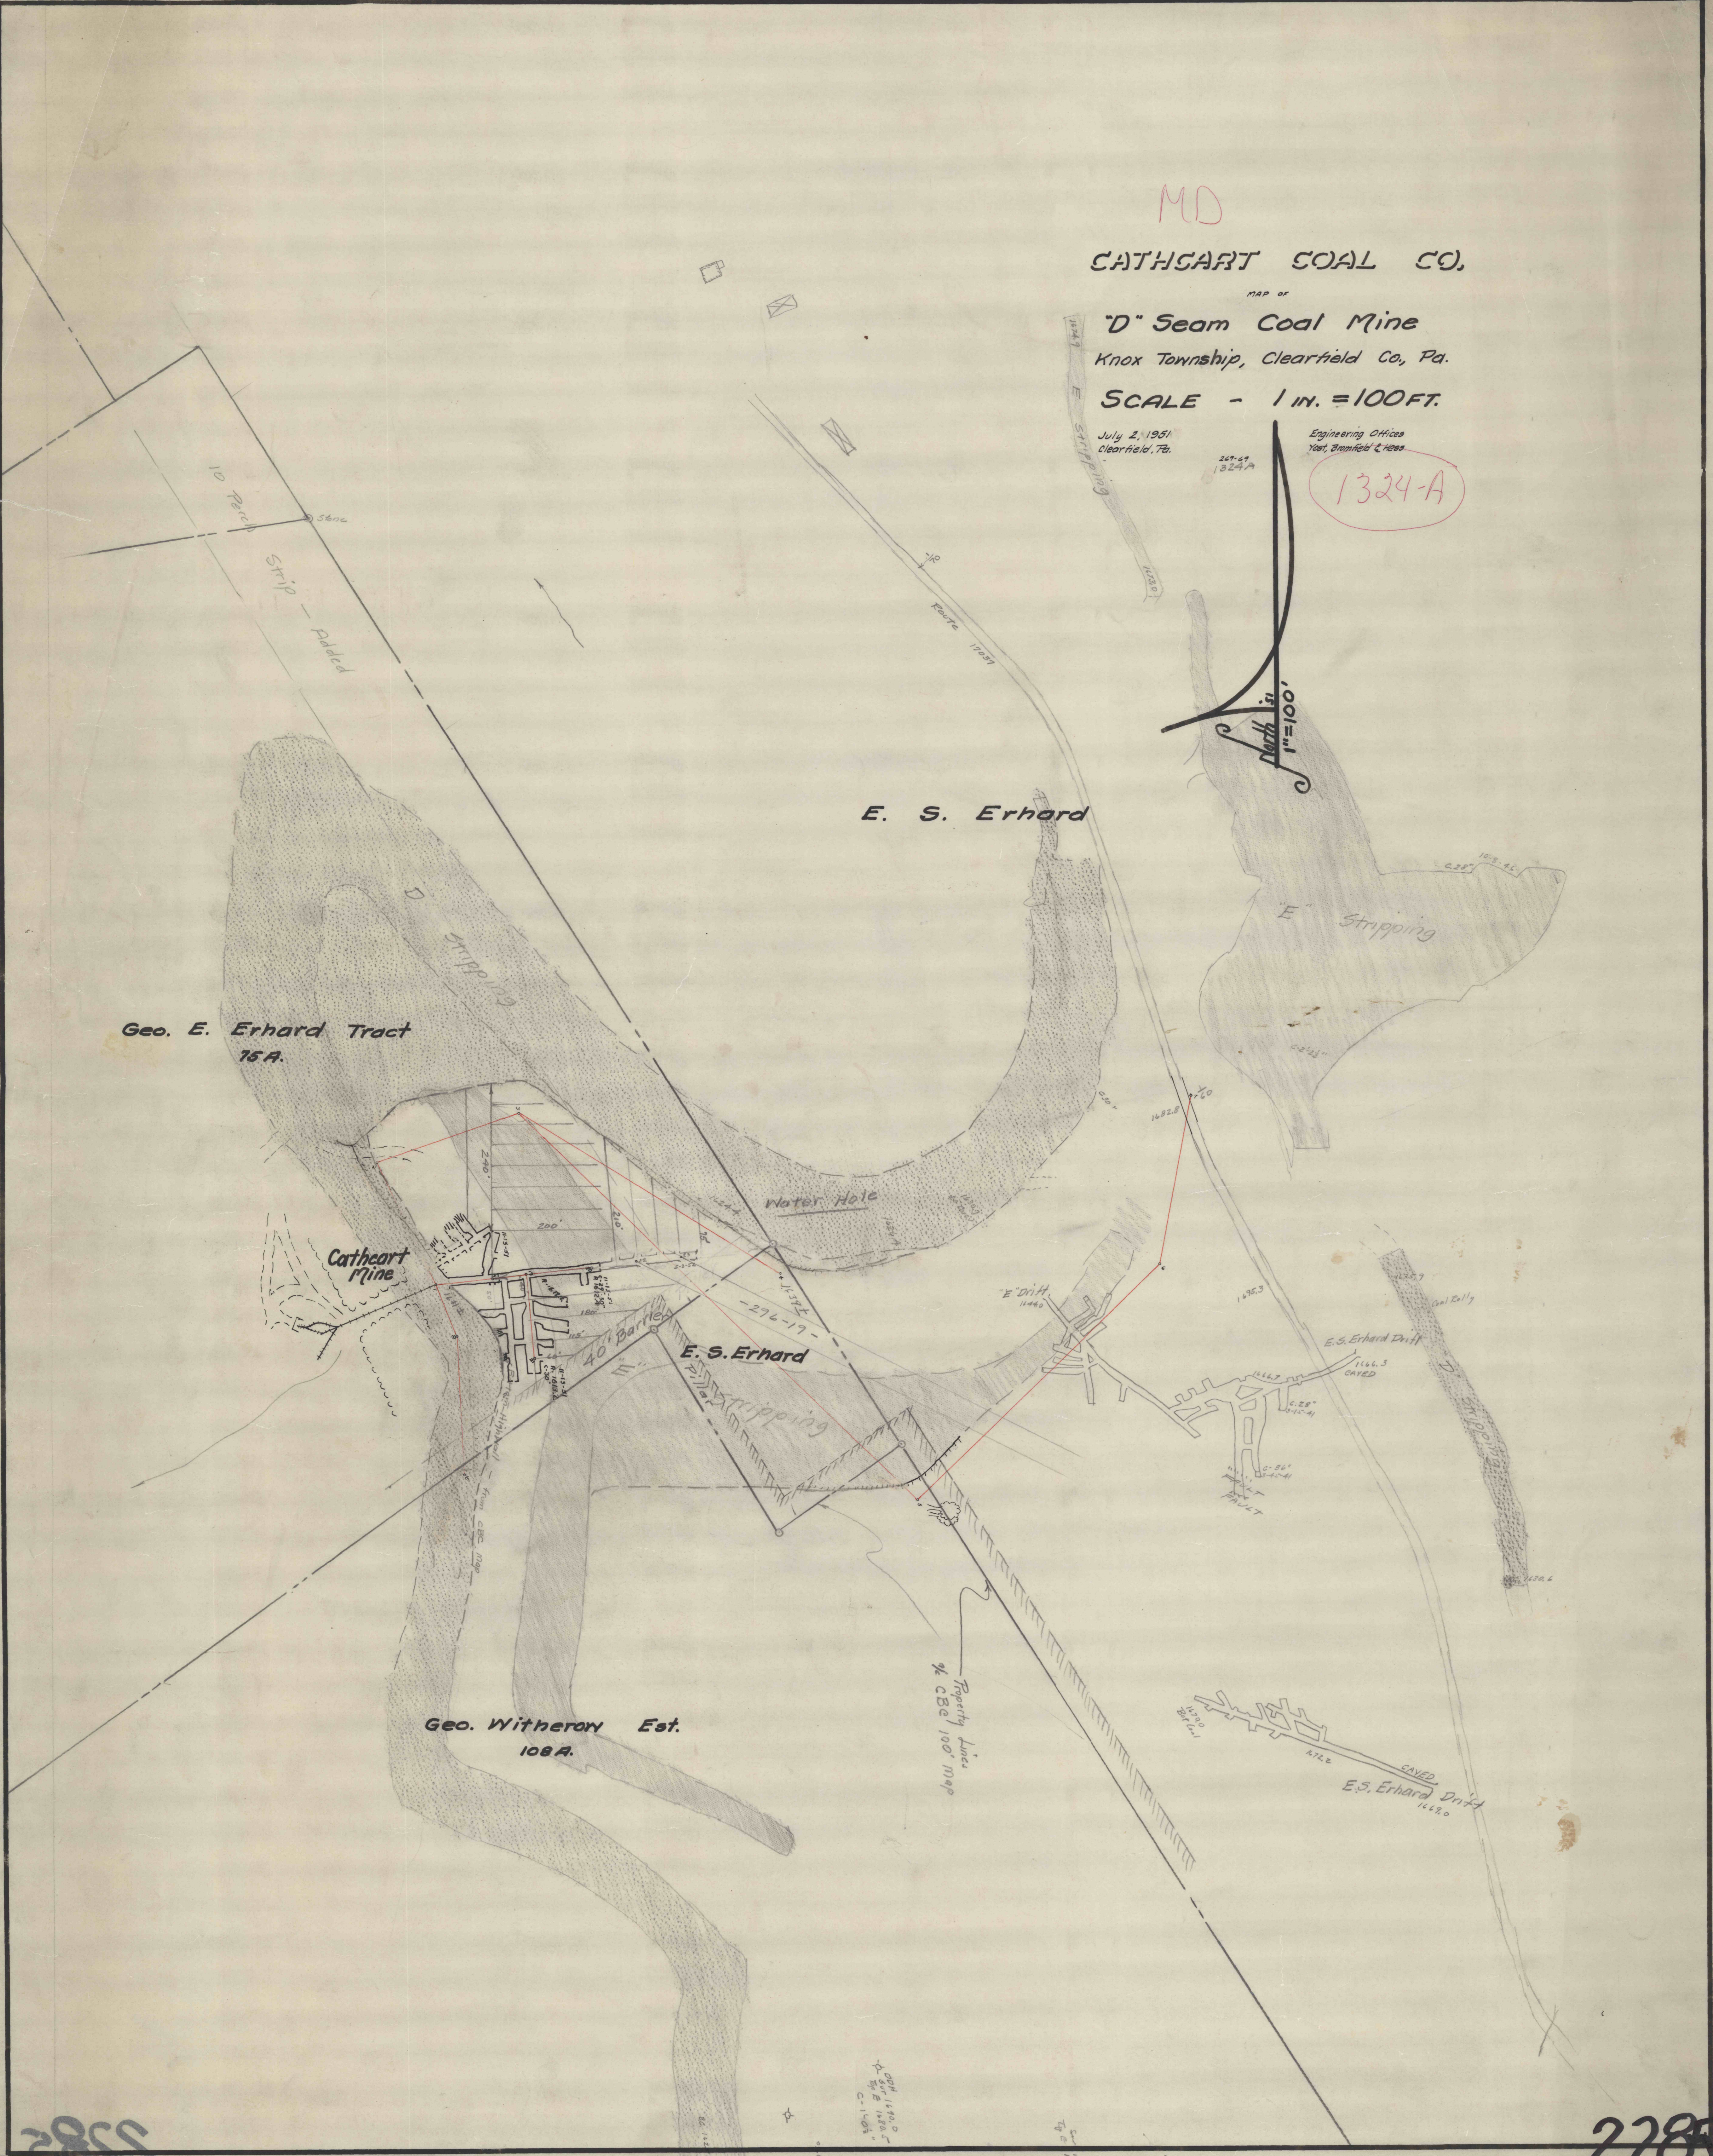

5582

2285