

8955

GRAHAM BROS.

R. W. MAINS TRACT

JOHN E JURY TRACT

FANNIE SMITH TRACT

WM. JURY TRACT

ASHLEY KYLER TRACT

JOSEPH BORON
10.50 A. "IN FEE"


STEWART
HEIRS

JOHN F JURY TRACT

— MAP SHOWING "D" SEAM MINE —
— OPERATED BY BORON BROS. COAL CO. —
— GIRARD TWP. CLEARFIELD COUNTY PA. —
— SCALE 1" = 100' — JULY 20 1955 —
— BERNARD LUCAS ASSOC'S. ENGR. —

C.D. 459

ORVIS SMITH TRACT

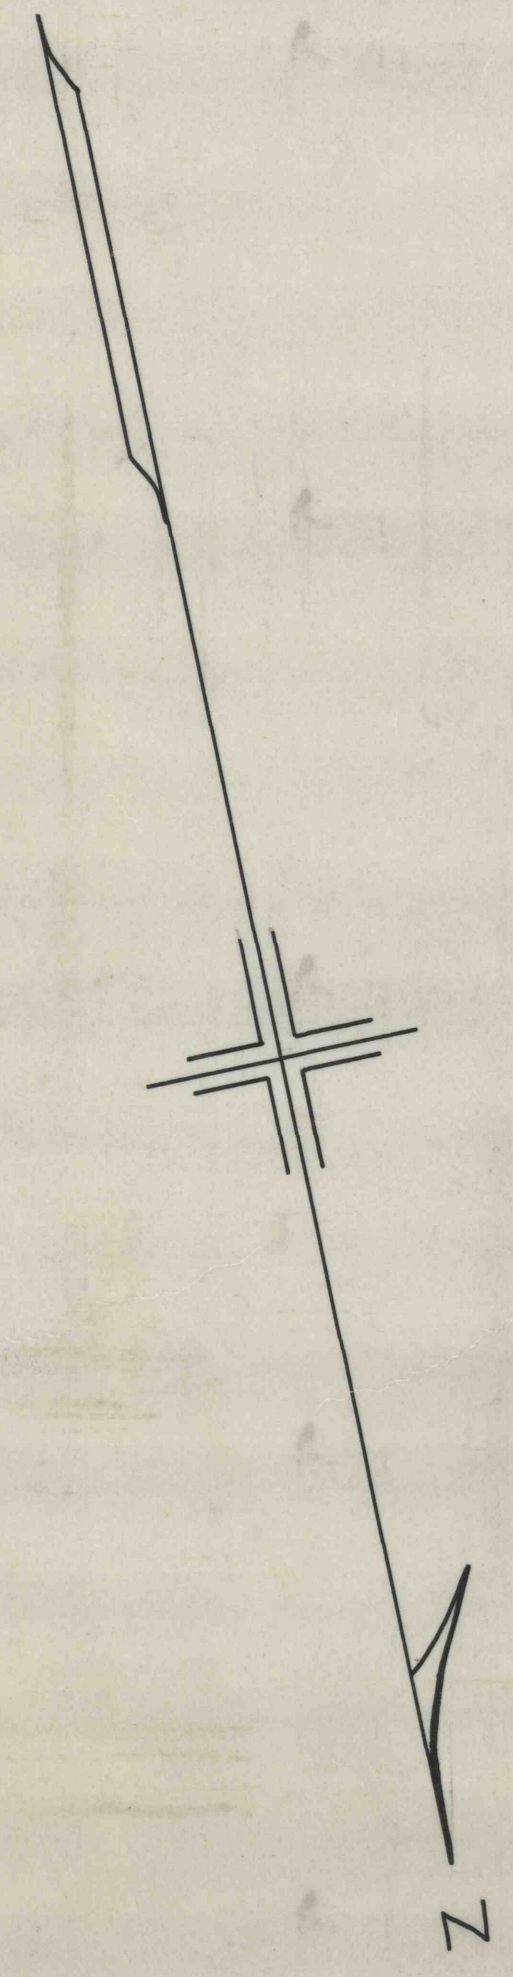

2298