


ESTATE OF WILLIAM M. POTTS

ESTATE WILLIAM M. POTTS

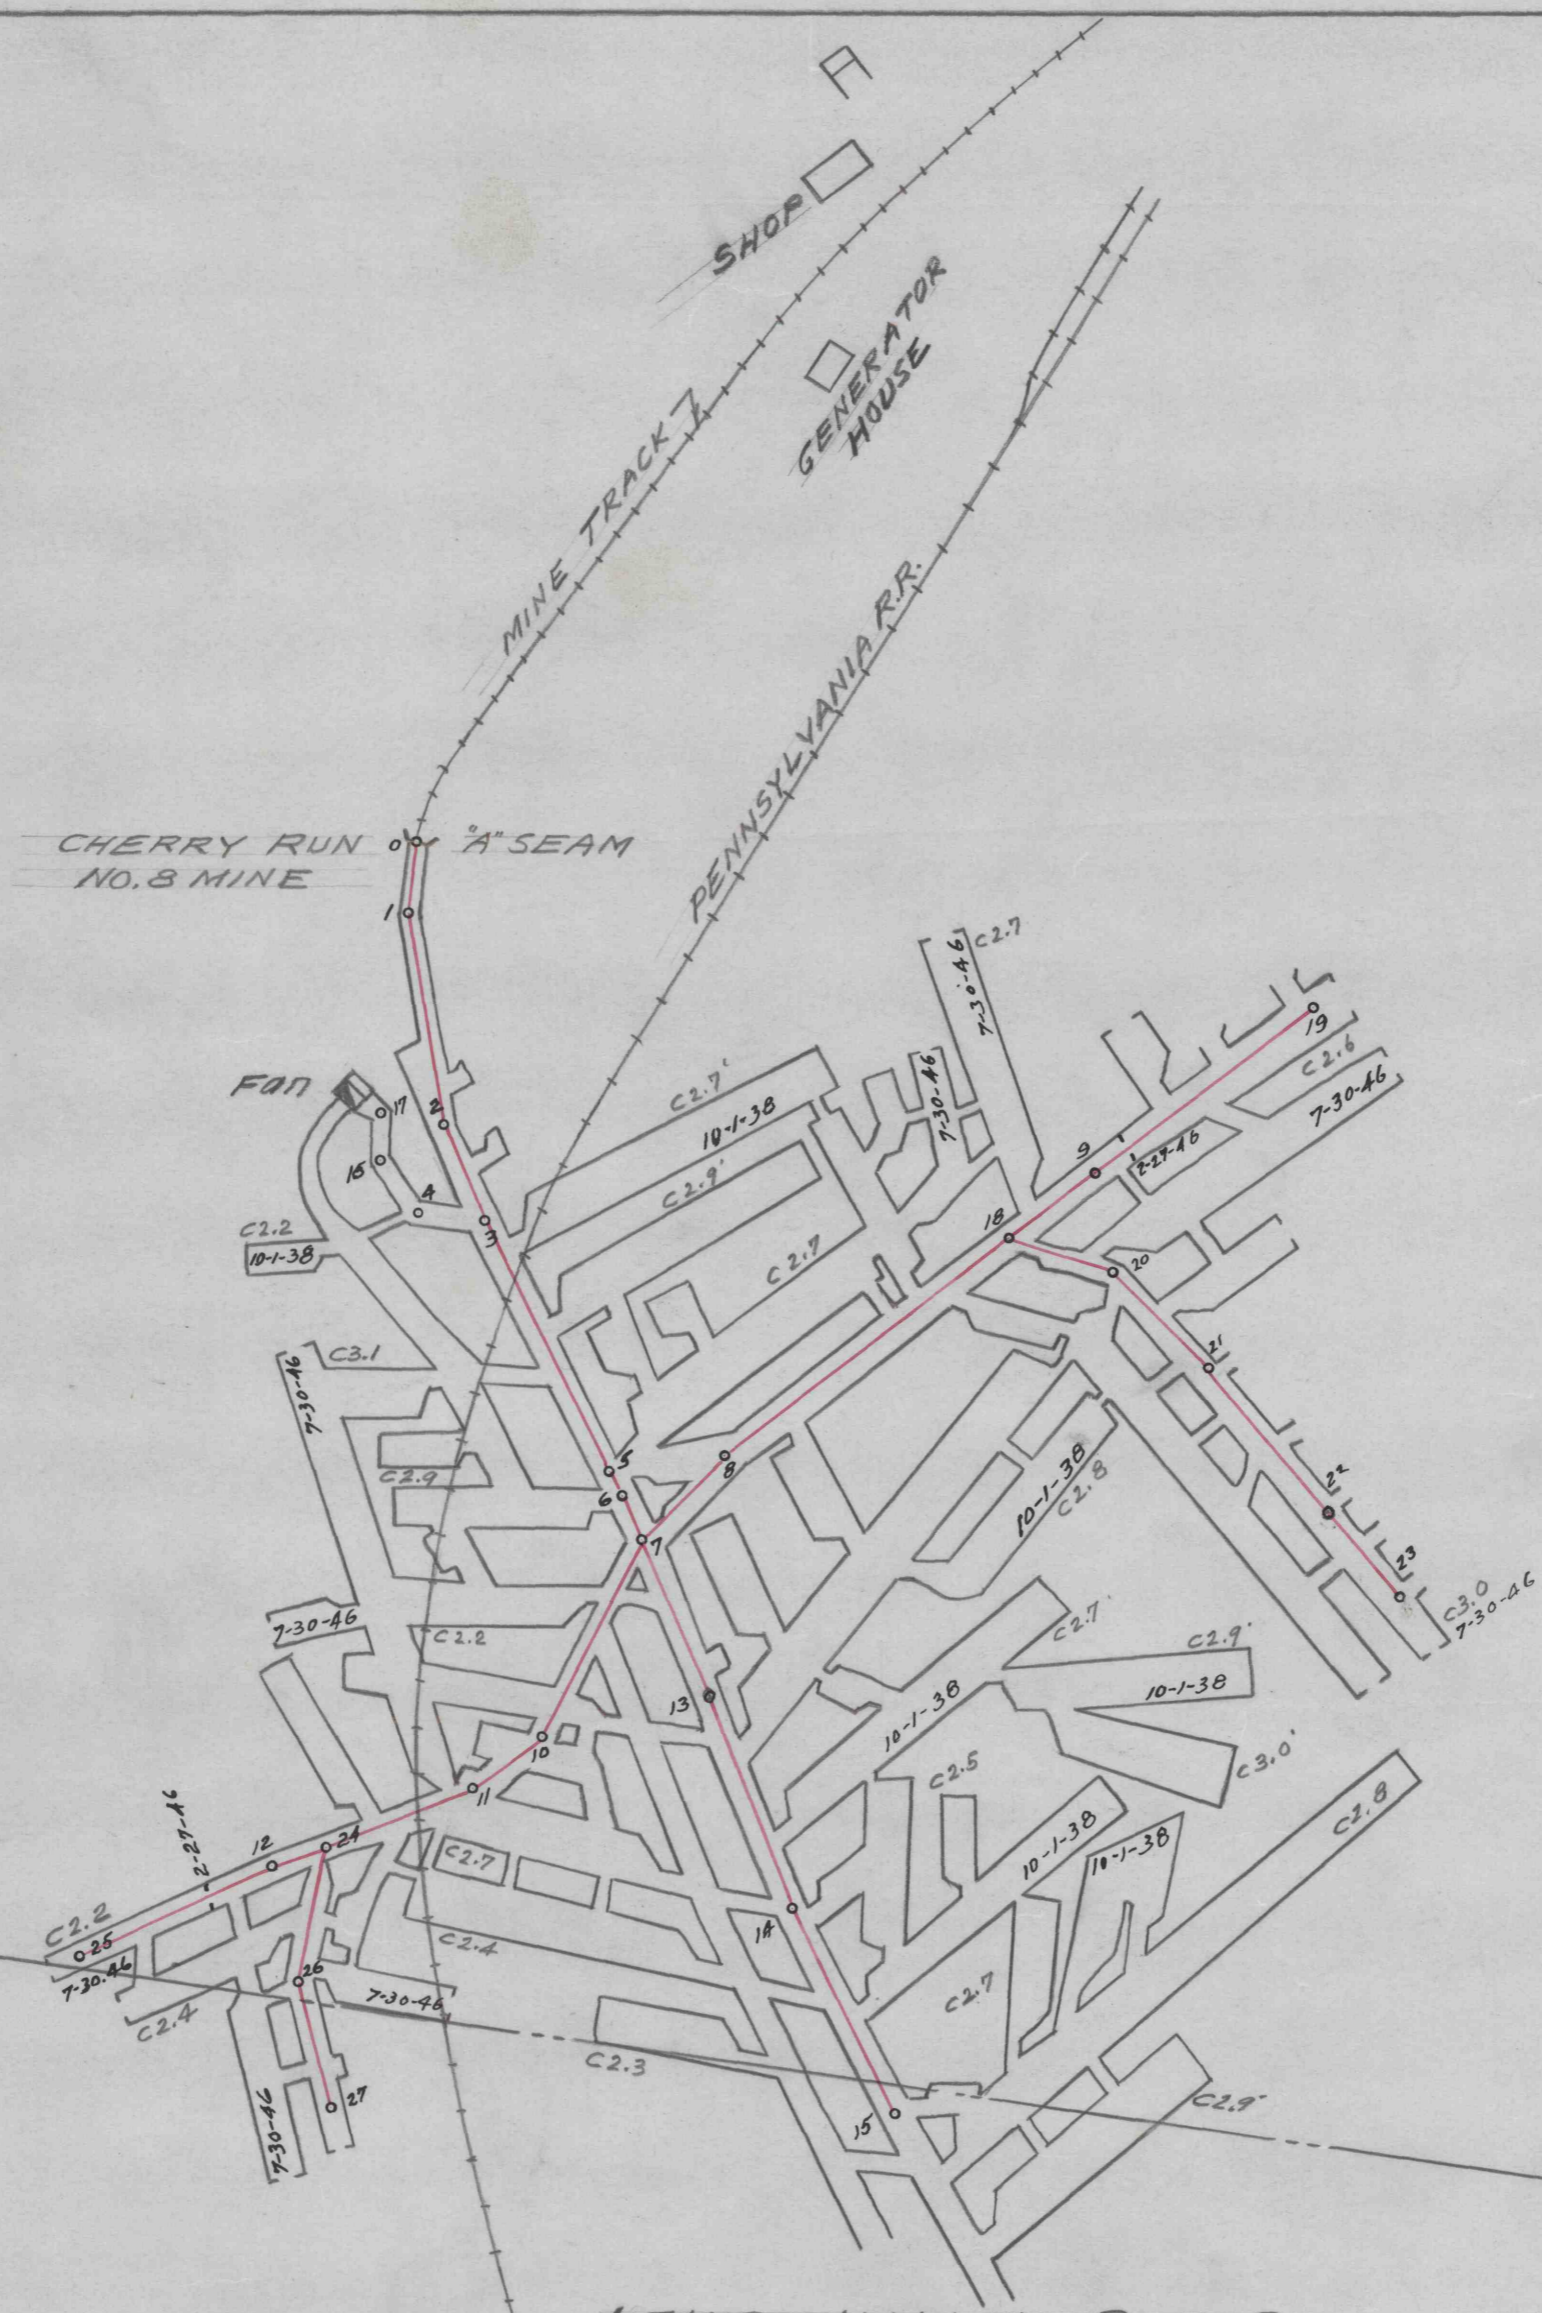

LEHIGH VALLEY COAL CO.

D

MAP SHOWING COAL REMOVED FROM
PROPERTY OF THE ESTATE OF WILLIAM M. POTTS
SNOW SHOE TOWNSHIP CENTRE CO. PA.
PRIOR TO OPERATION BY CLARENCE COAL MINING CO.
SCALE 1"=100'

AUG. 17, 1946.

C.D. 246

Bernard Lucas Engrs.
Thos. F. Morgan

8025

2308