
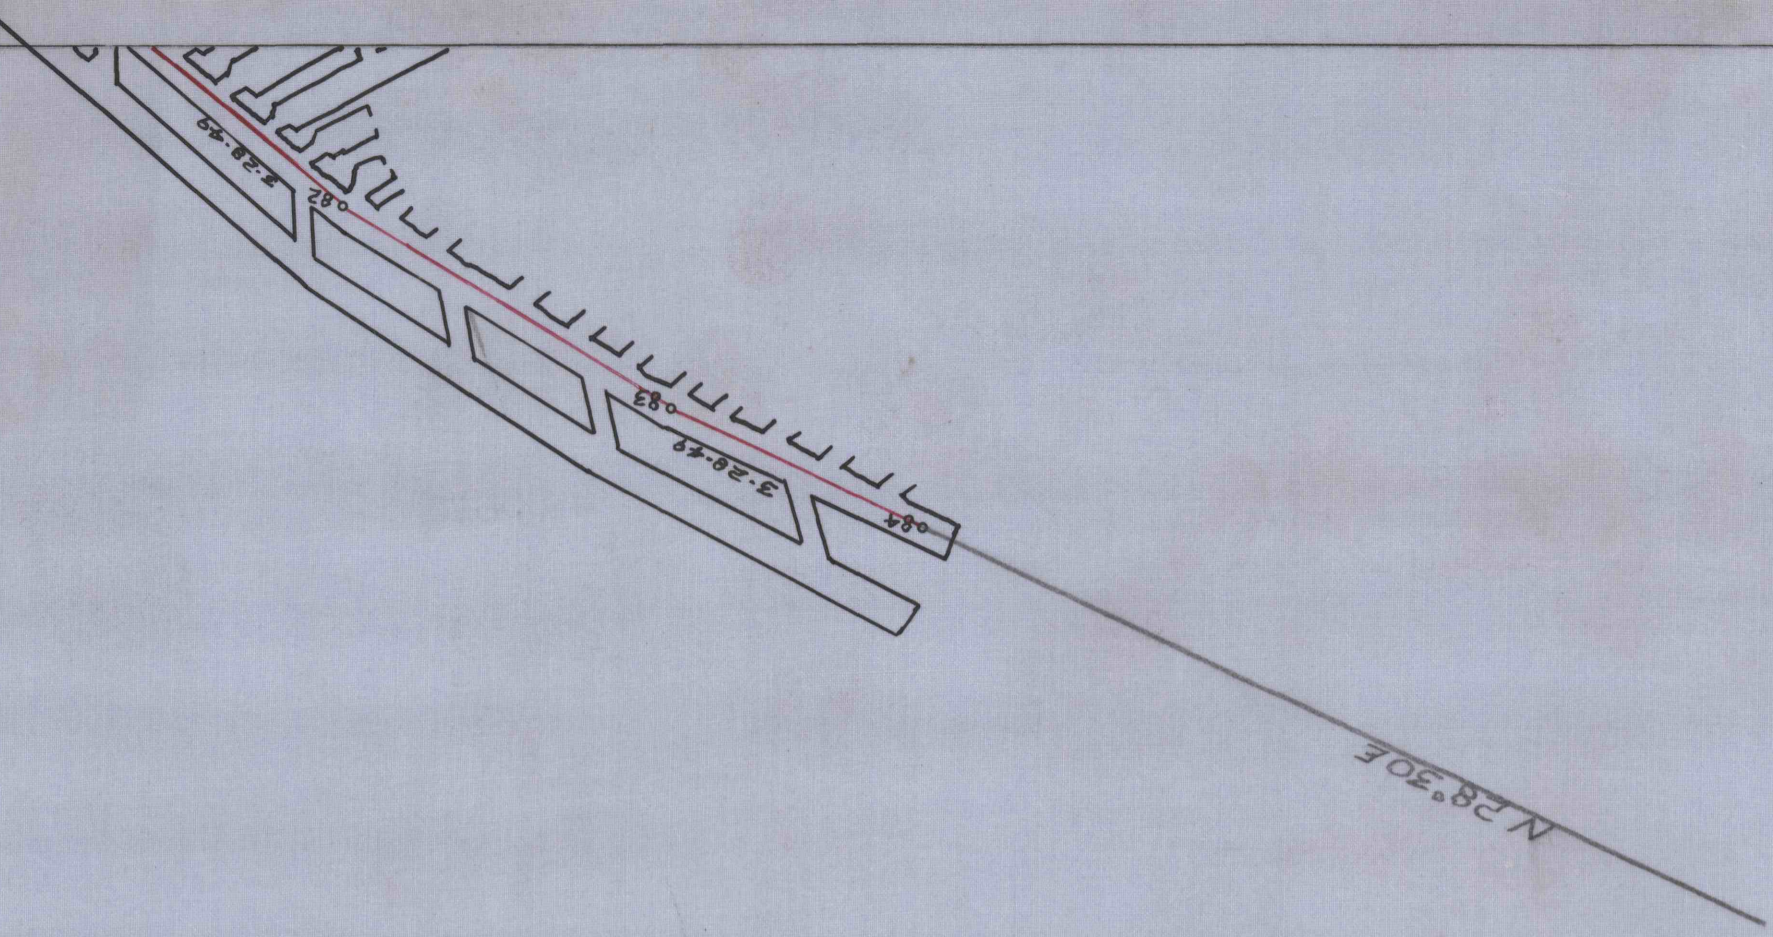


POES

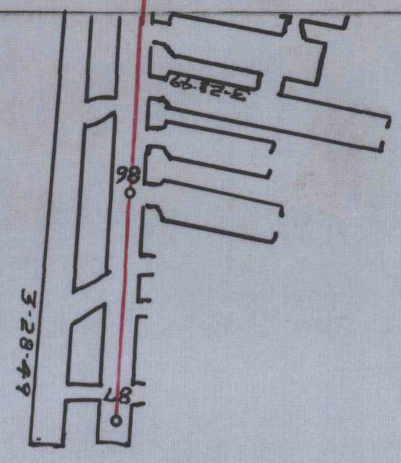

D
G.D. 246

2309
B