


2326

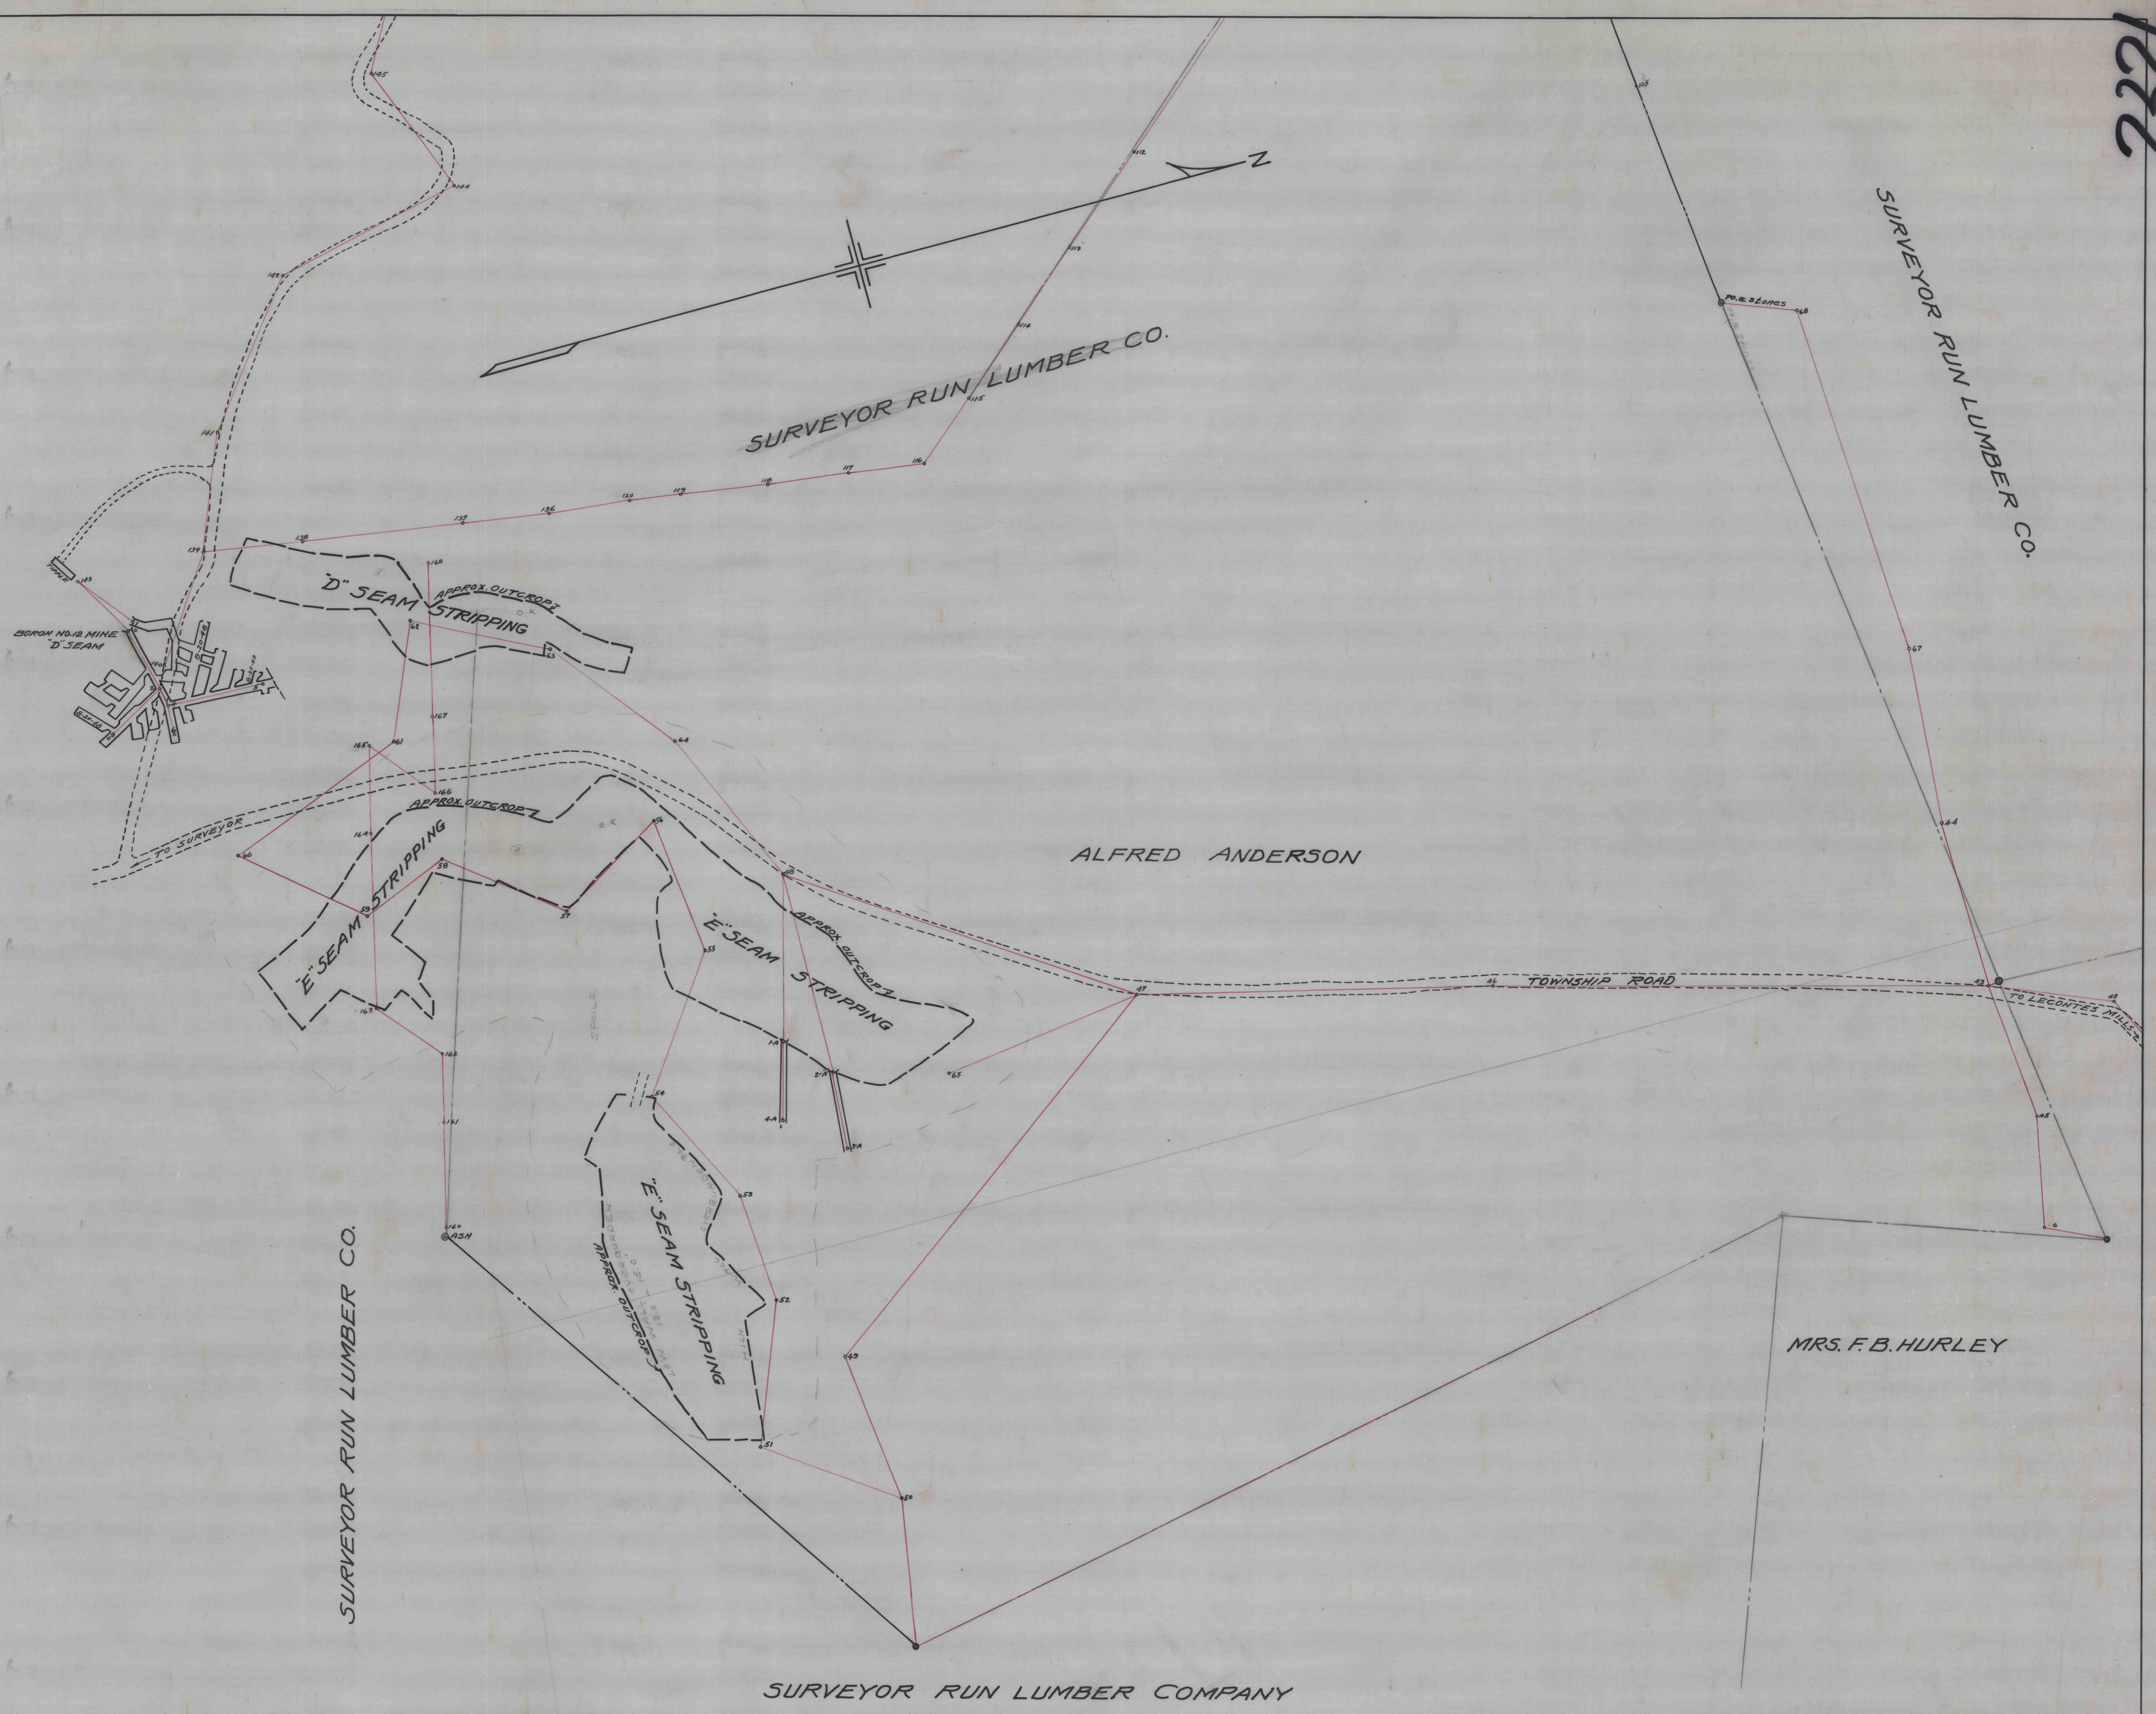

MD
 — BORON BROTHERS COAL COMPANY —
 — MAP SHOWING —
 — ALFRED ANDERSON TRACT STRIPPINGS —
 — GIRARD TWP. CLEARFIELD CO. PA. —
 — SCALE 1" = 100' — JULY 7, 1947 —
 POSTED TO AUG. 10, 1948 C.D. 230
 Bernard Lucas
 Thos. F. Morgan ENGRS.

5359