


2332

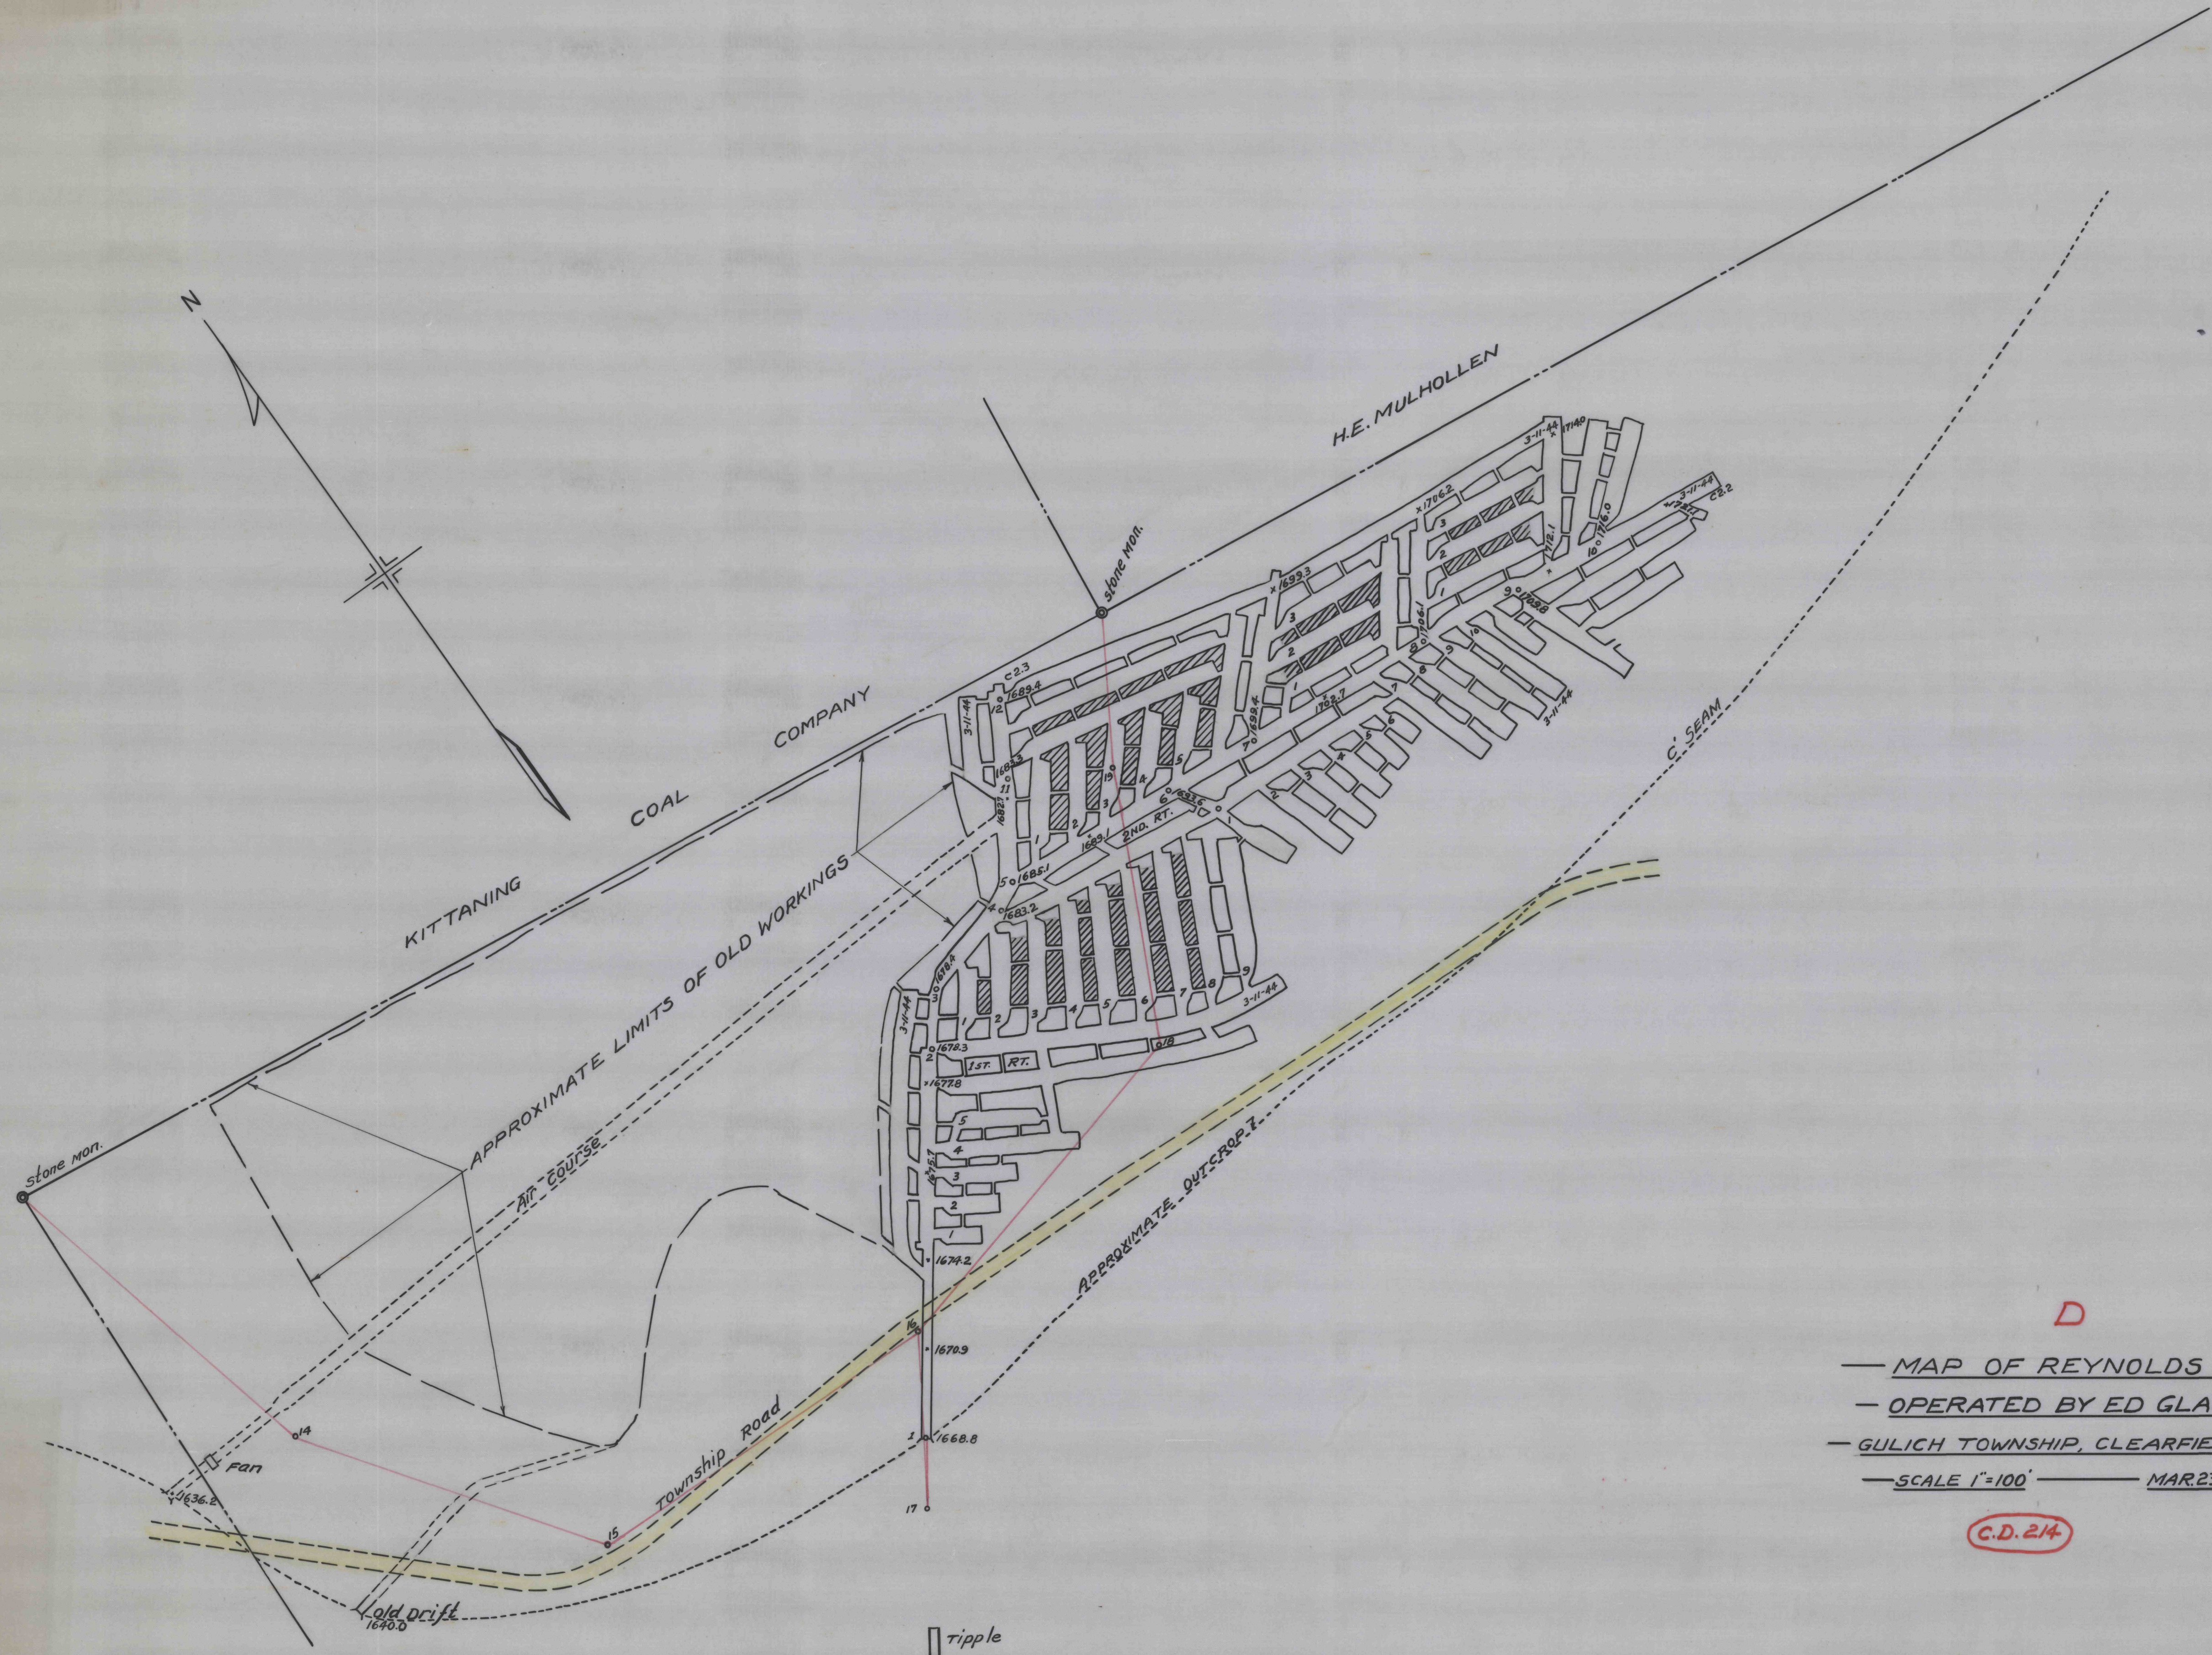

D

— MAP OF REYNOLDS MINE —
 — OPERATED BY ED GLASGOW —
 — GULICH TOWNSHIP, CLEARFIELD CO. PA. —
 — SCALE 1"=100' — MAR. 23, 1944 —

C.D. 214

THOS. J. MORGAN
BERNARD LUCAS
ENGINEERS

Handwritten signature or initials in the bottom right corner.