


2334

Meeker Drift


MARTIN MEEKER

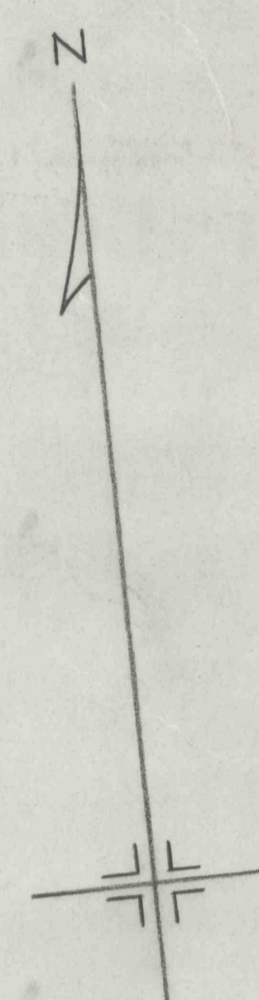

House

House

Barn

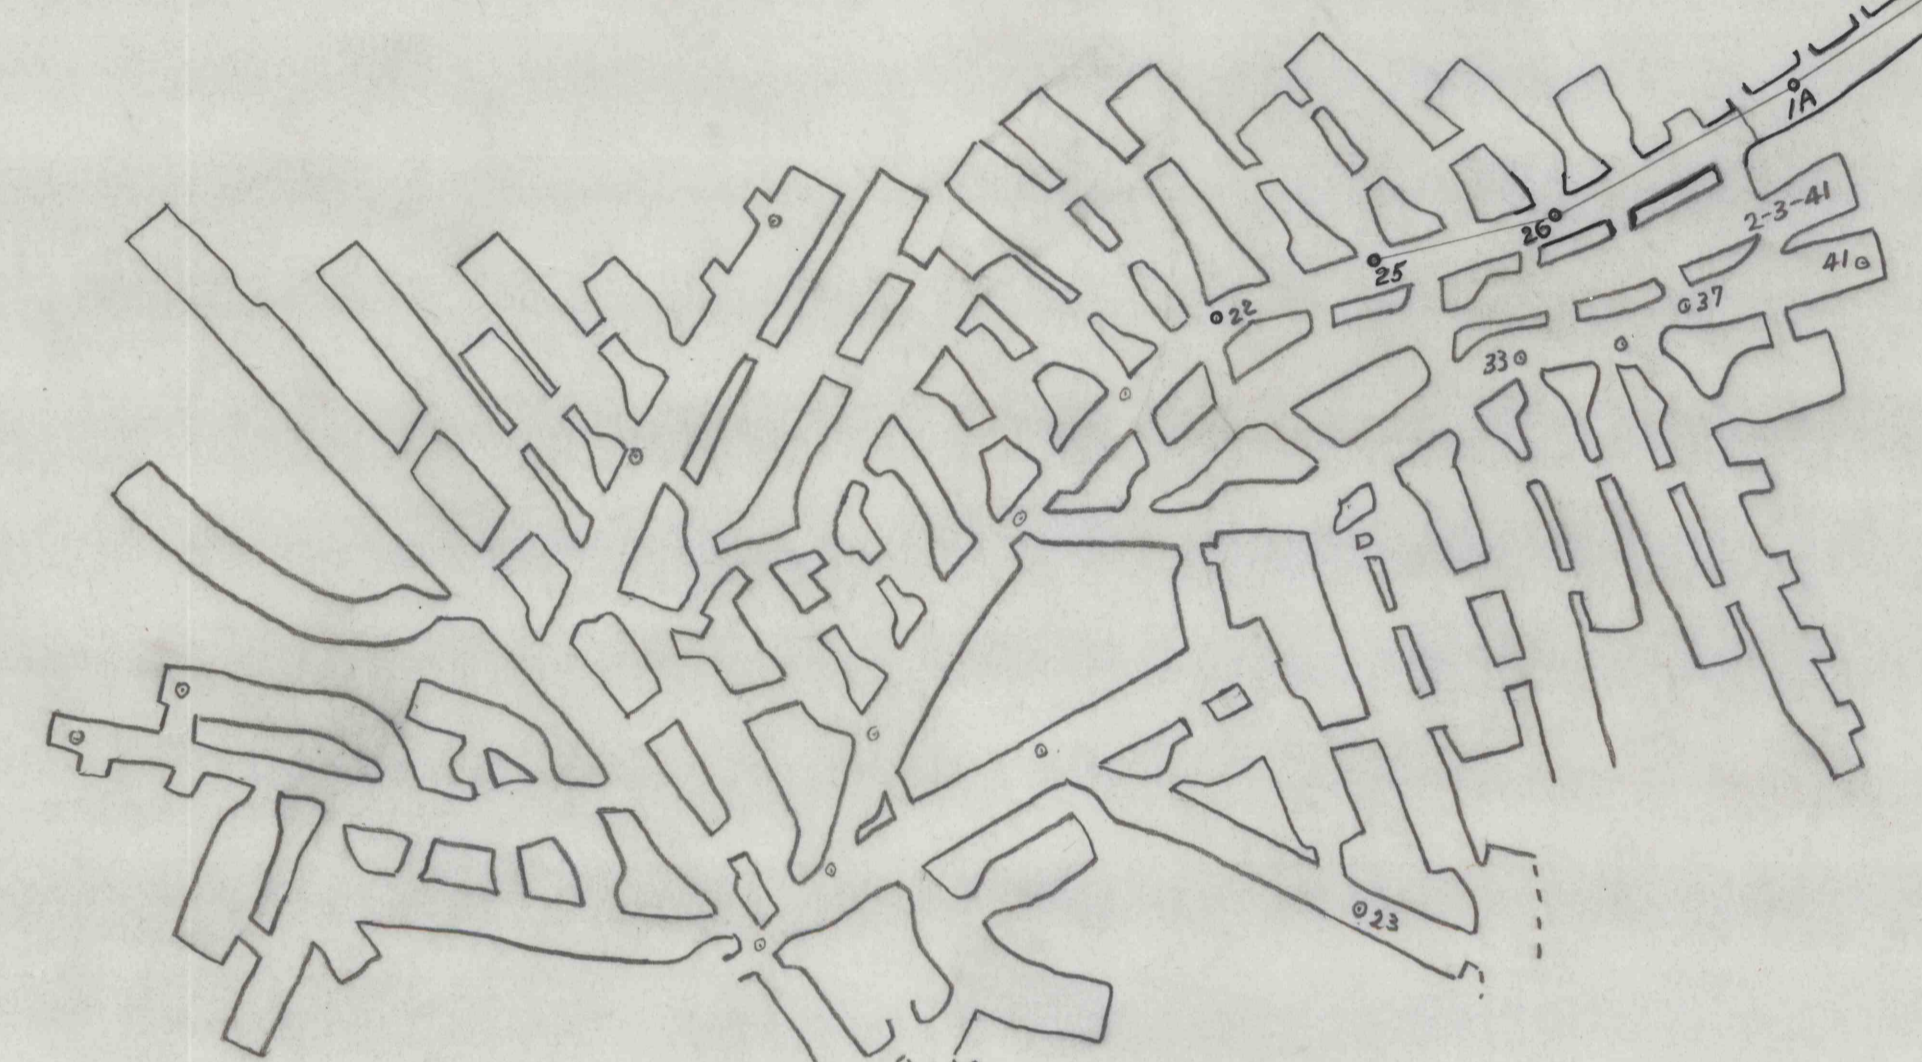

SHAFT ROAD

GROVE DRIFT

stream

SAMUEL LINN

J.H. WALLIN TRACT

D

MINE MAP

CHERRY RUN COAL COMPANY

BURNSIDE TWP. CENTRE CO. PA.

SCALE 1"=100'      MAR. 22, 44

G.D. & M.

THOS. MORGAN ENGRS.

BERNARD LUCAS

TO NOSHAMON →

2334