

PHILIPSBURG COAL & LAND CO.

M. M. KOLESAR

MEKOFKY ESTATE

BEAVER ESTATE

C SEAM STRIPPING

B SEAM STRIPPING 336 ACRES

VAIL ESTATE


B SEAM STRIPPING

B SEAM STRIPPING 8.94 ACRES

C SEAM STRIPPING 19.30 ACRES

COAL IN PLACE 0.46 ACRES

STEINER ESTATE

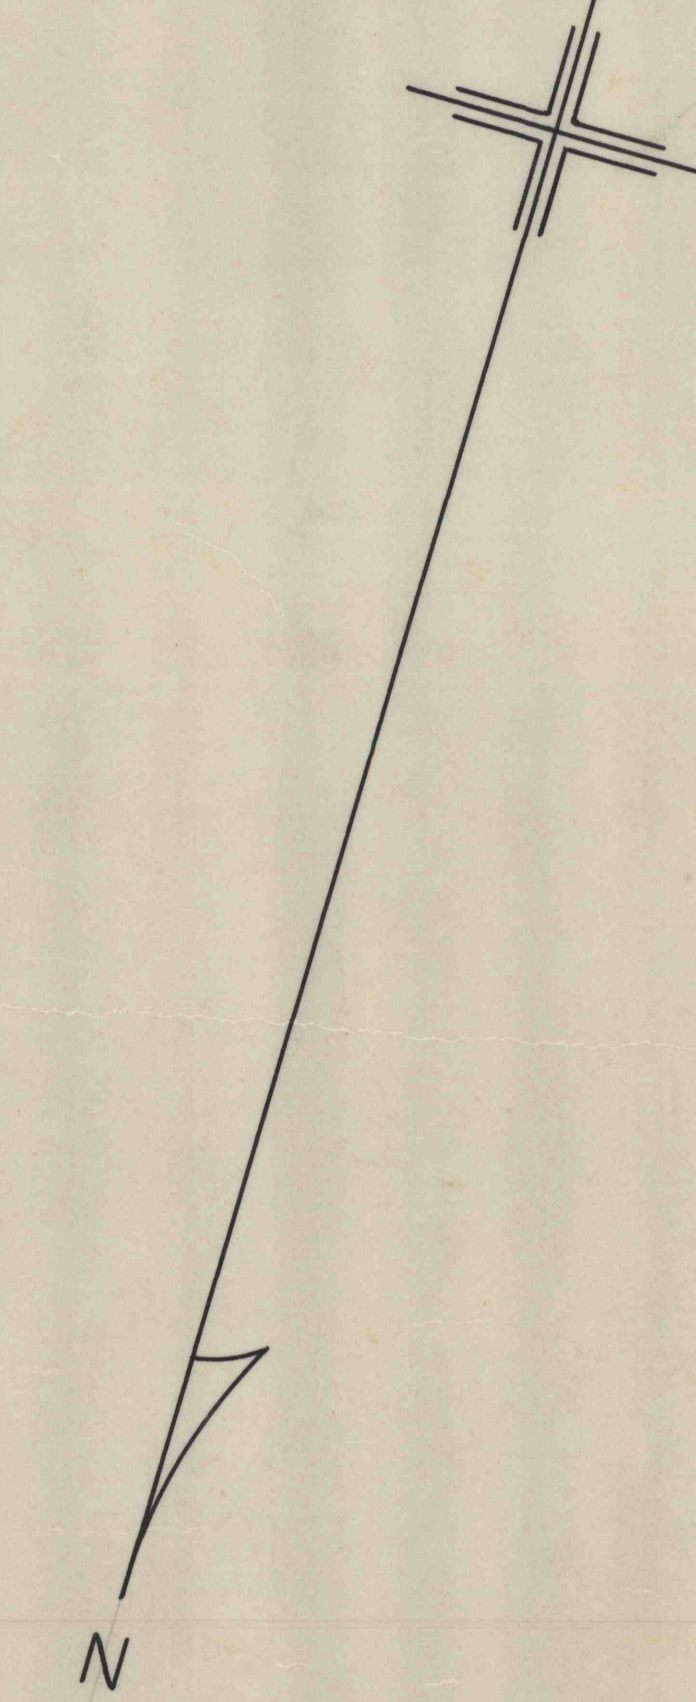

M

— ELLIOT COAL MINING COMPANY —
 — MAP OF B & C SEAMS STRIPPINGS —
 — ON THE VAIL TRACT —
 — RUSH TWP. CENTRE COUNTY PA. —
 — SCALE 1" = 100' — MARCH 6, 1950 —

C.D. 333