

PCES

PHILIPSBURG COAL & LAND CO.

BEAVER ESTATE


TRACT

VAIL

ESTATE

STEINER

— *M* —
 — ELLIOT COAL MINING COMPANY —
 — MAP OF "B" SEAM STRIPPINGS —
 — ON THE BEAVER TRACT —
 — RUSH TWP. CENTRE COUNTY PA. —
 — SCALE 1"=100' — MARCH 13 1950 —
 — BERNARD LUCAS ENGR. —
 — C.D. 333 —

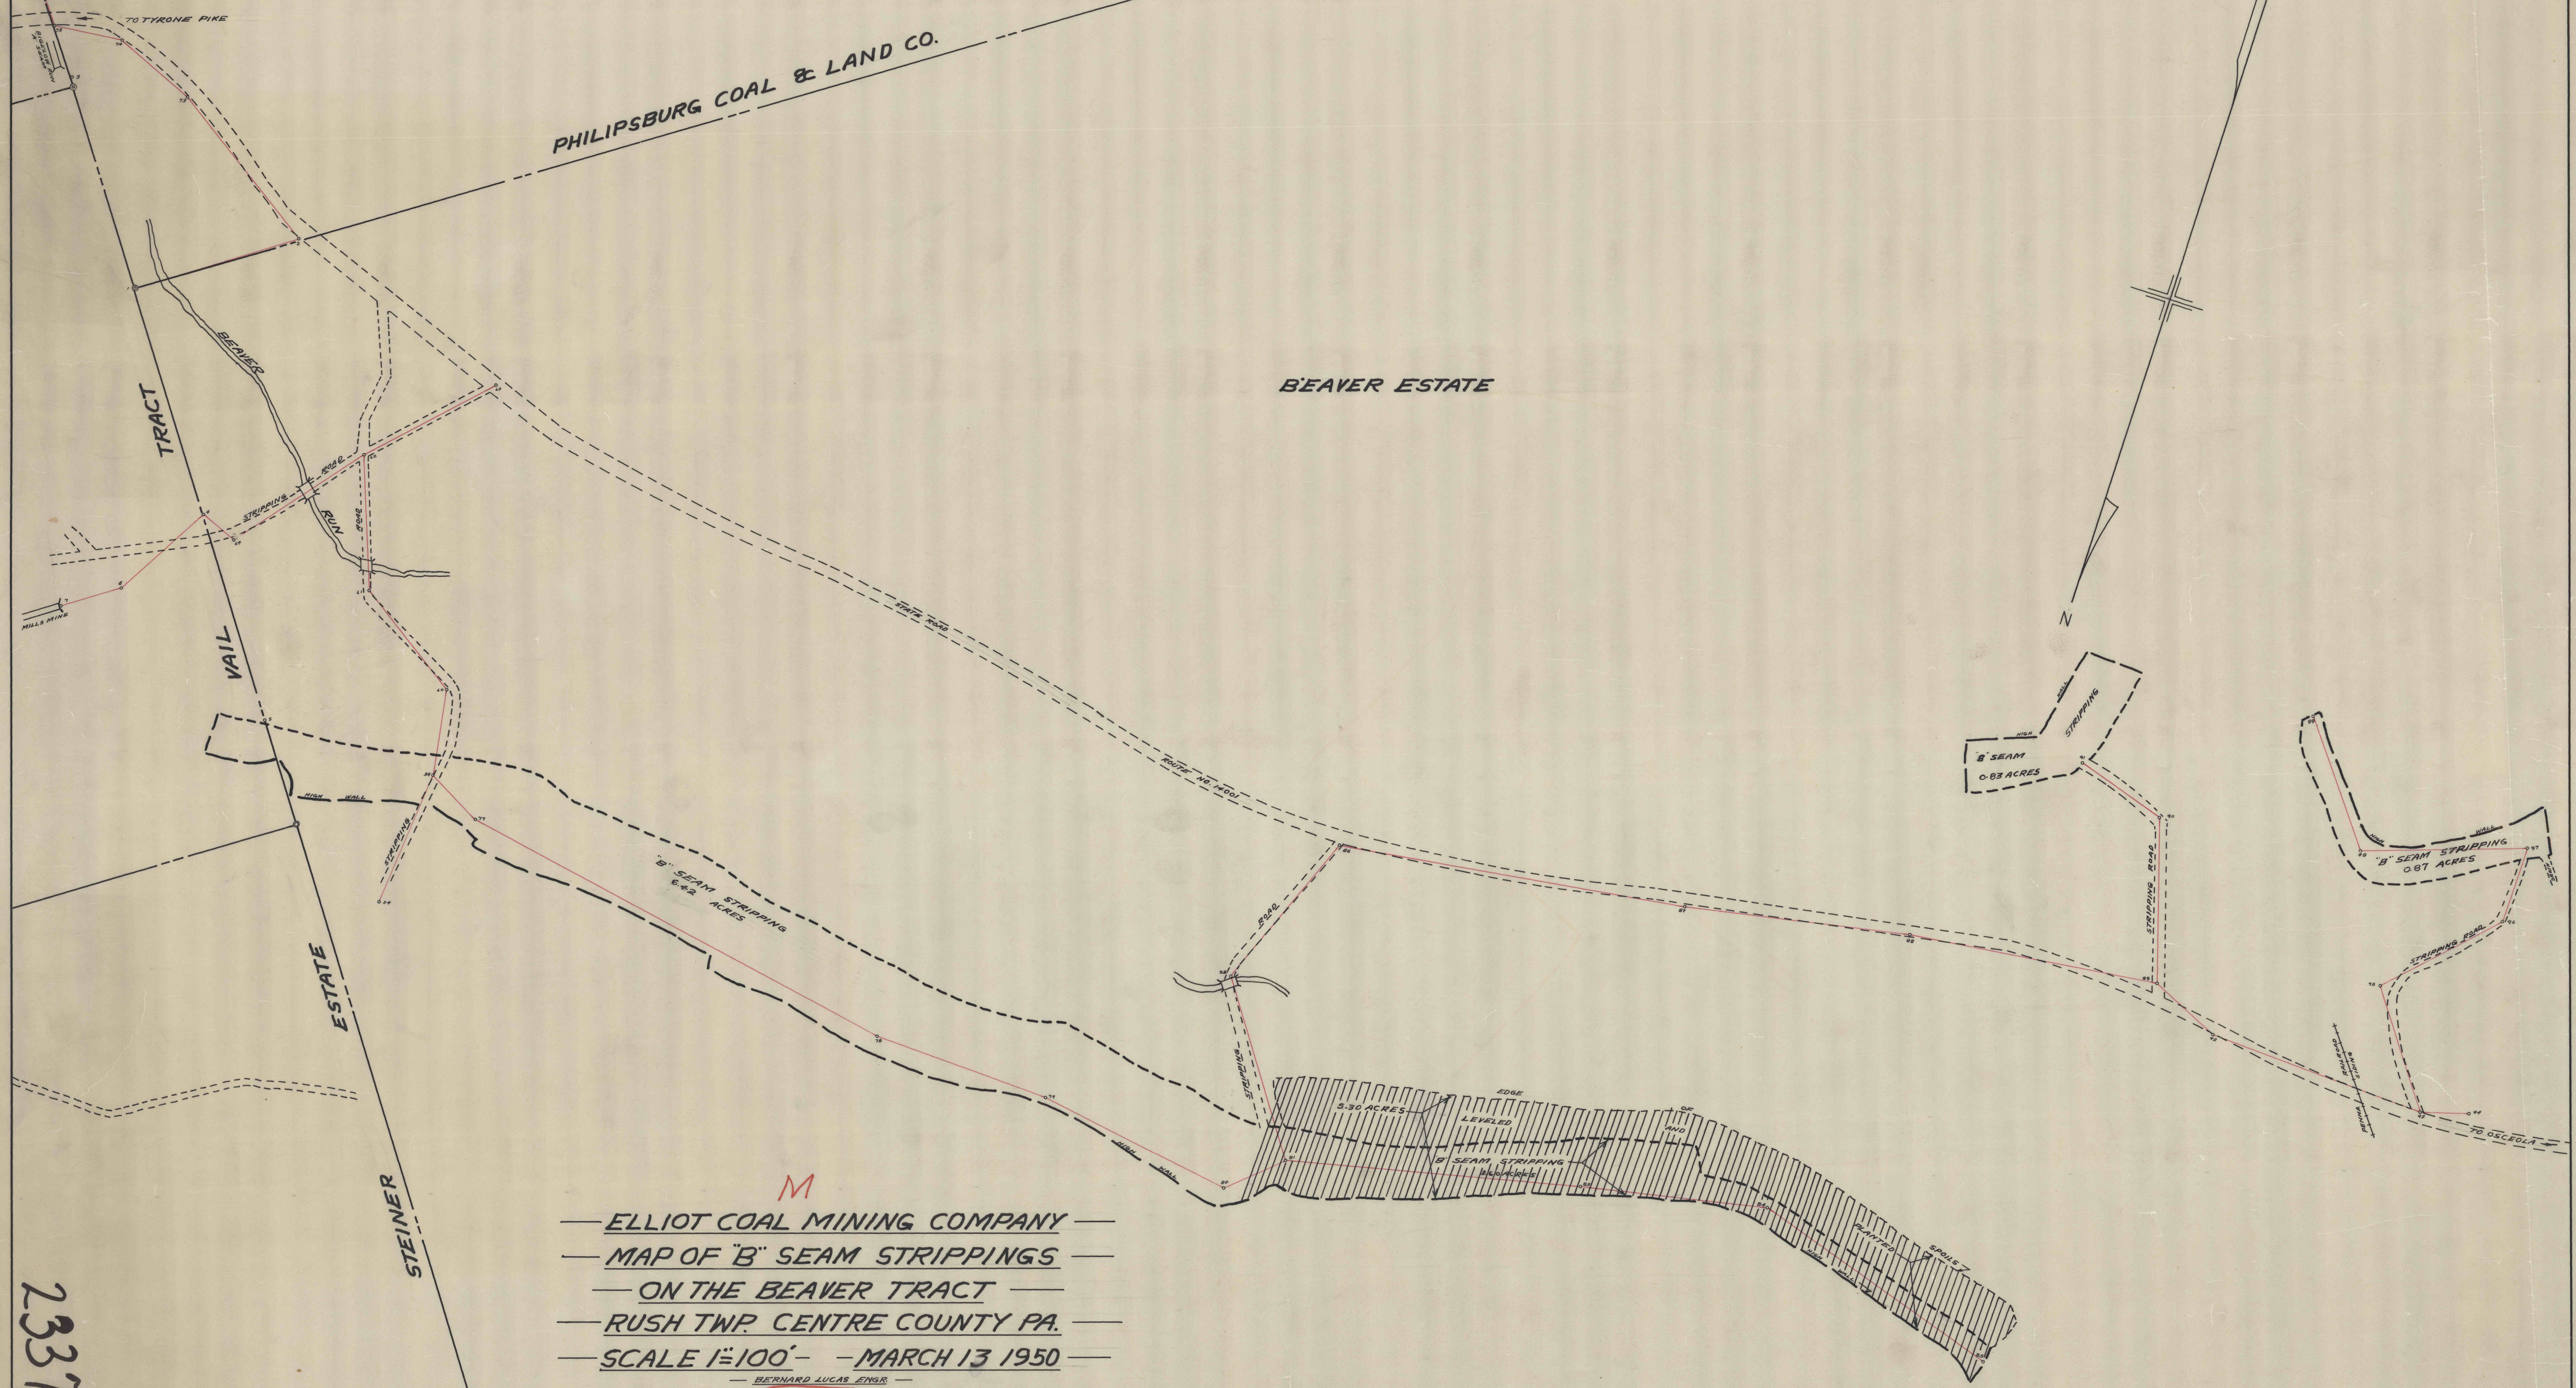

2337