


507CS

2372

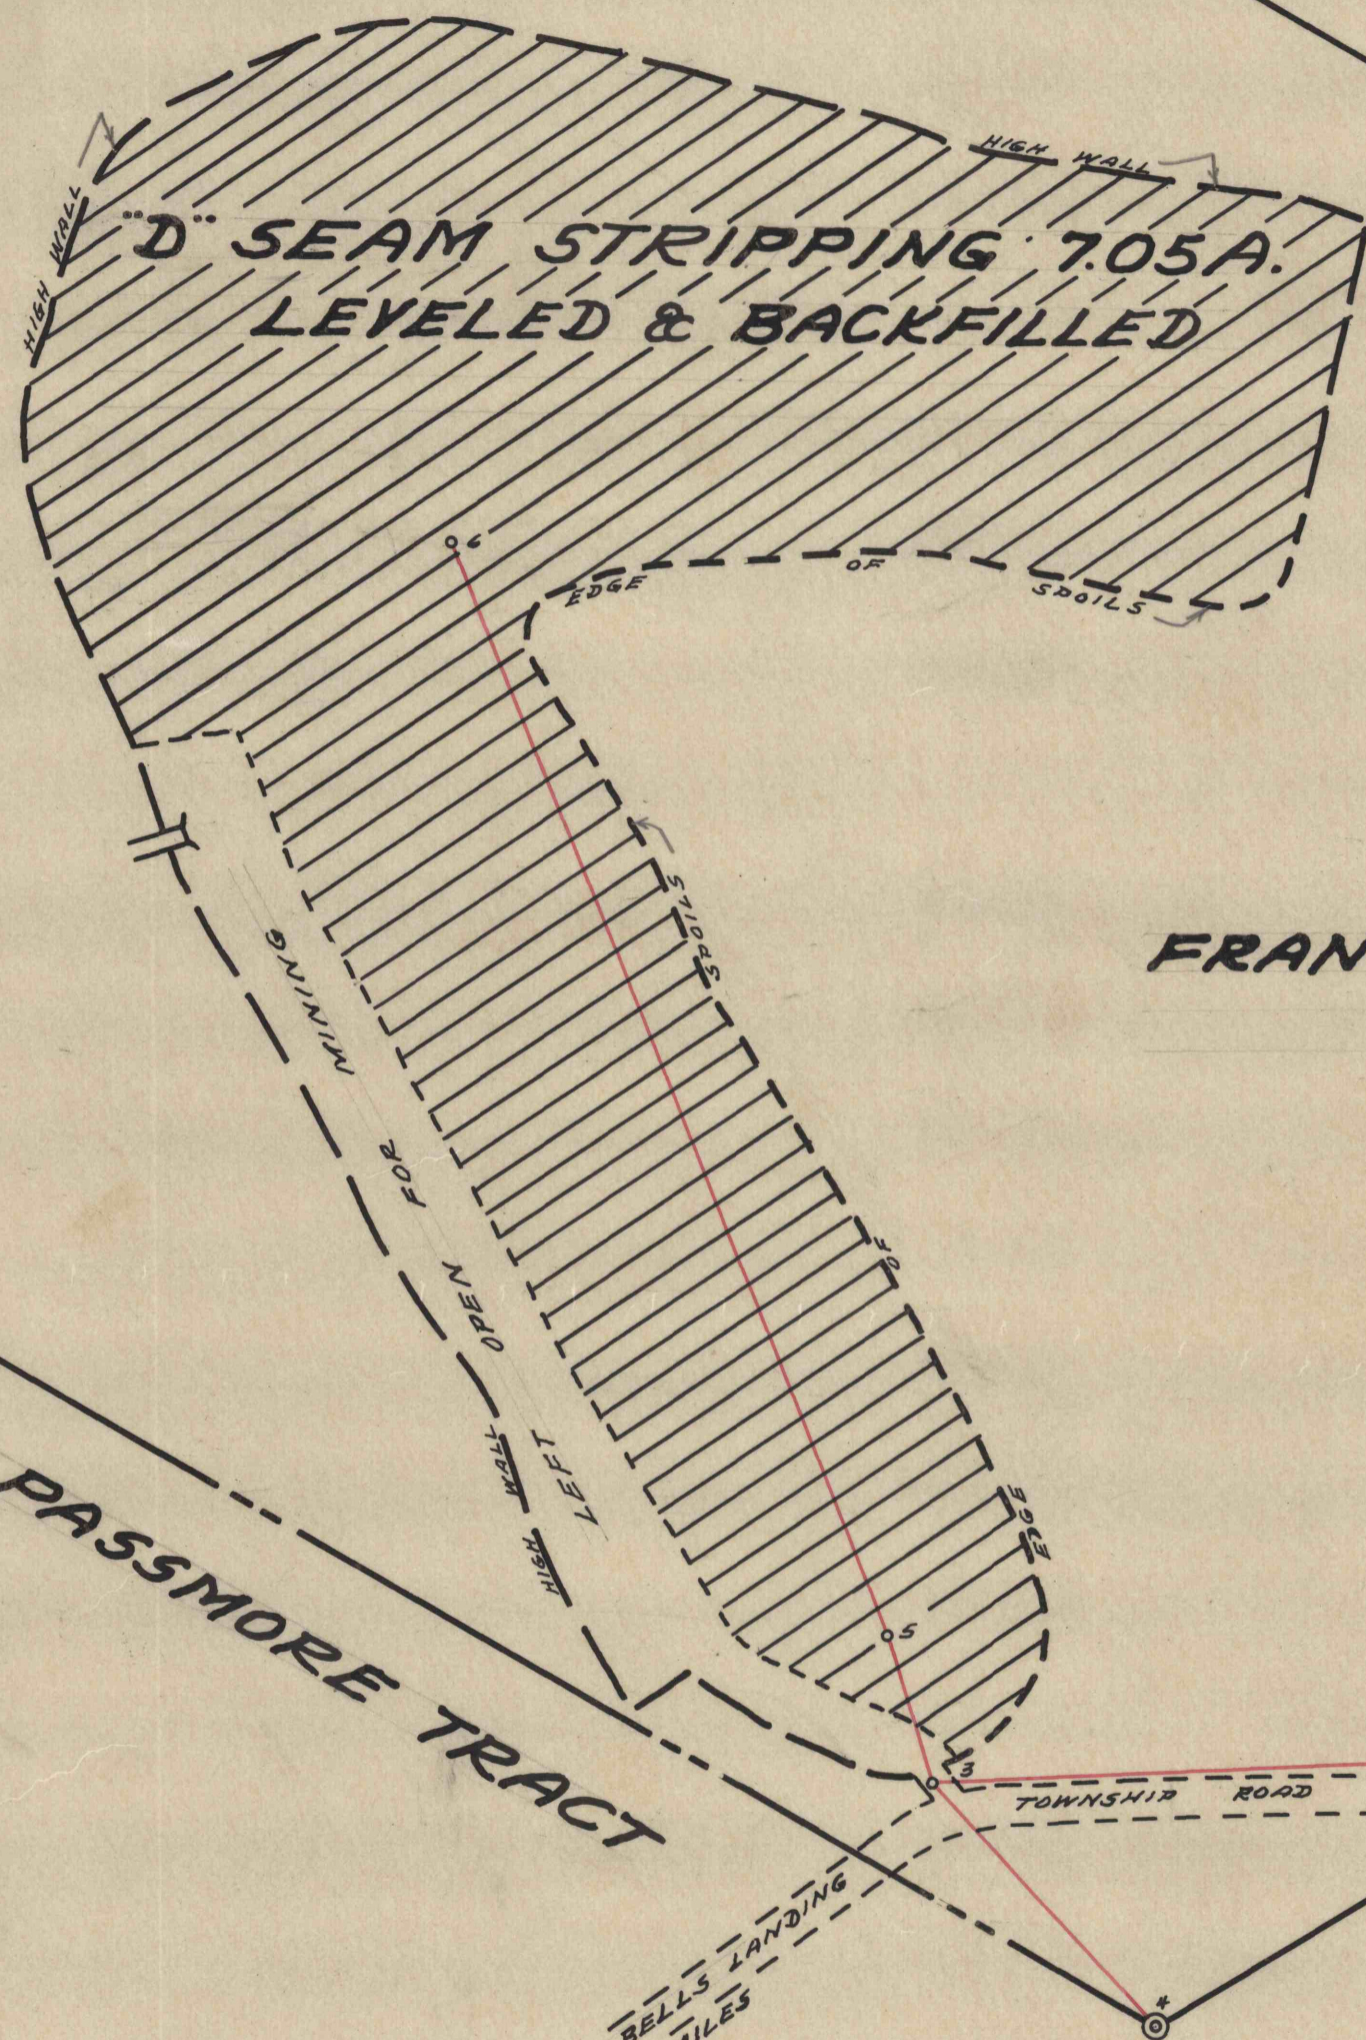

FRANK SKONIER TRACT
100 ACRES

ROBBINS TRACT

BELL TRACT

PASSMORE TRACT

M

— MAP SHOWING "D" SEAM STRIPPING —
 — OPERATED BY SPRING VALLEY COAL CO. —
 — GREENWOOD TWP. CLEARFIELD COUNTY PENNA. —
 — SCALE 1"=100' —
 (C.D. 378) JULY 30, 1952
 Bernard Lucas Engr.

N