


ALTON

525

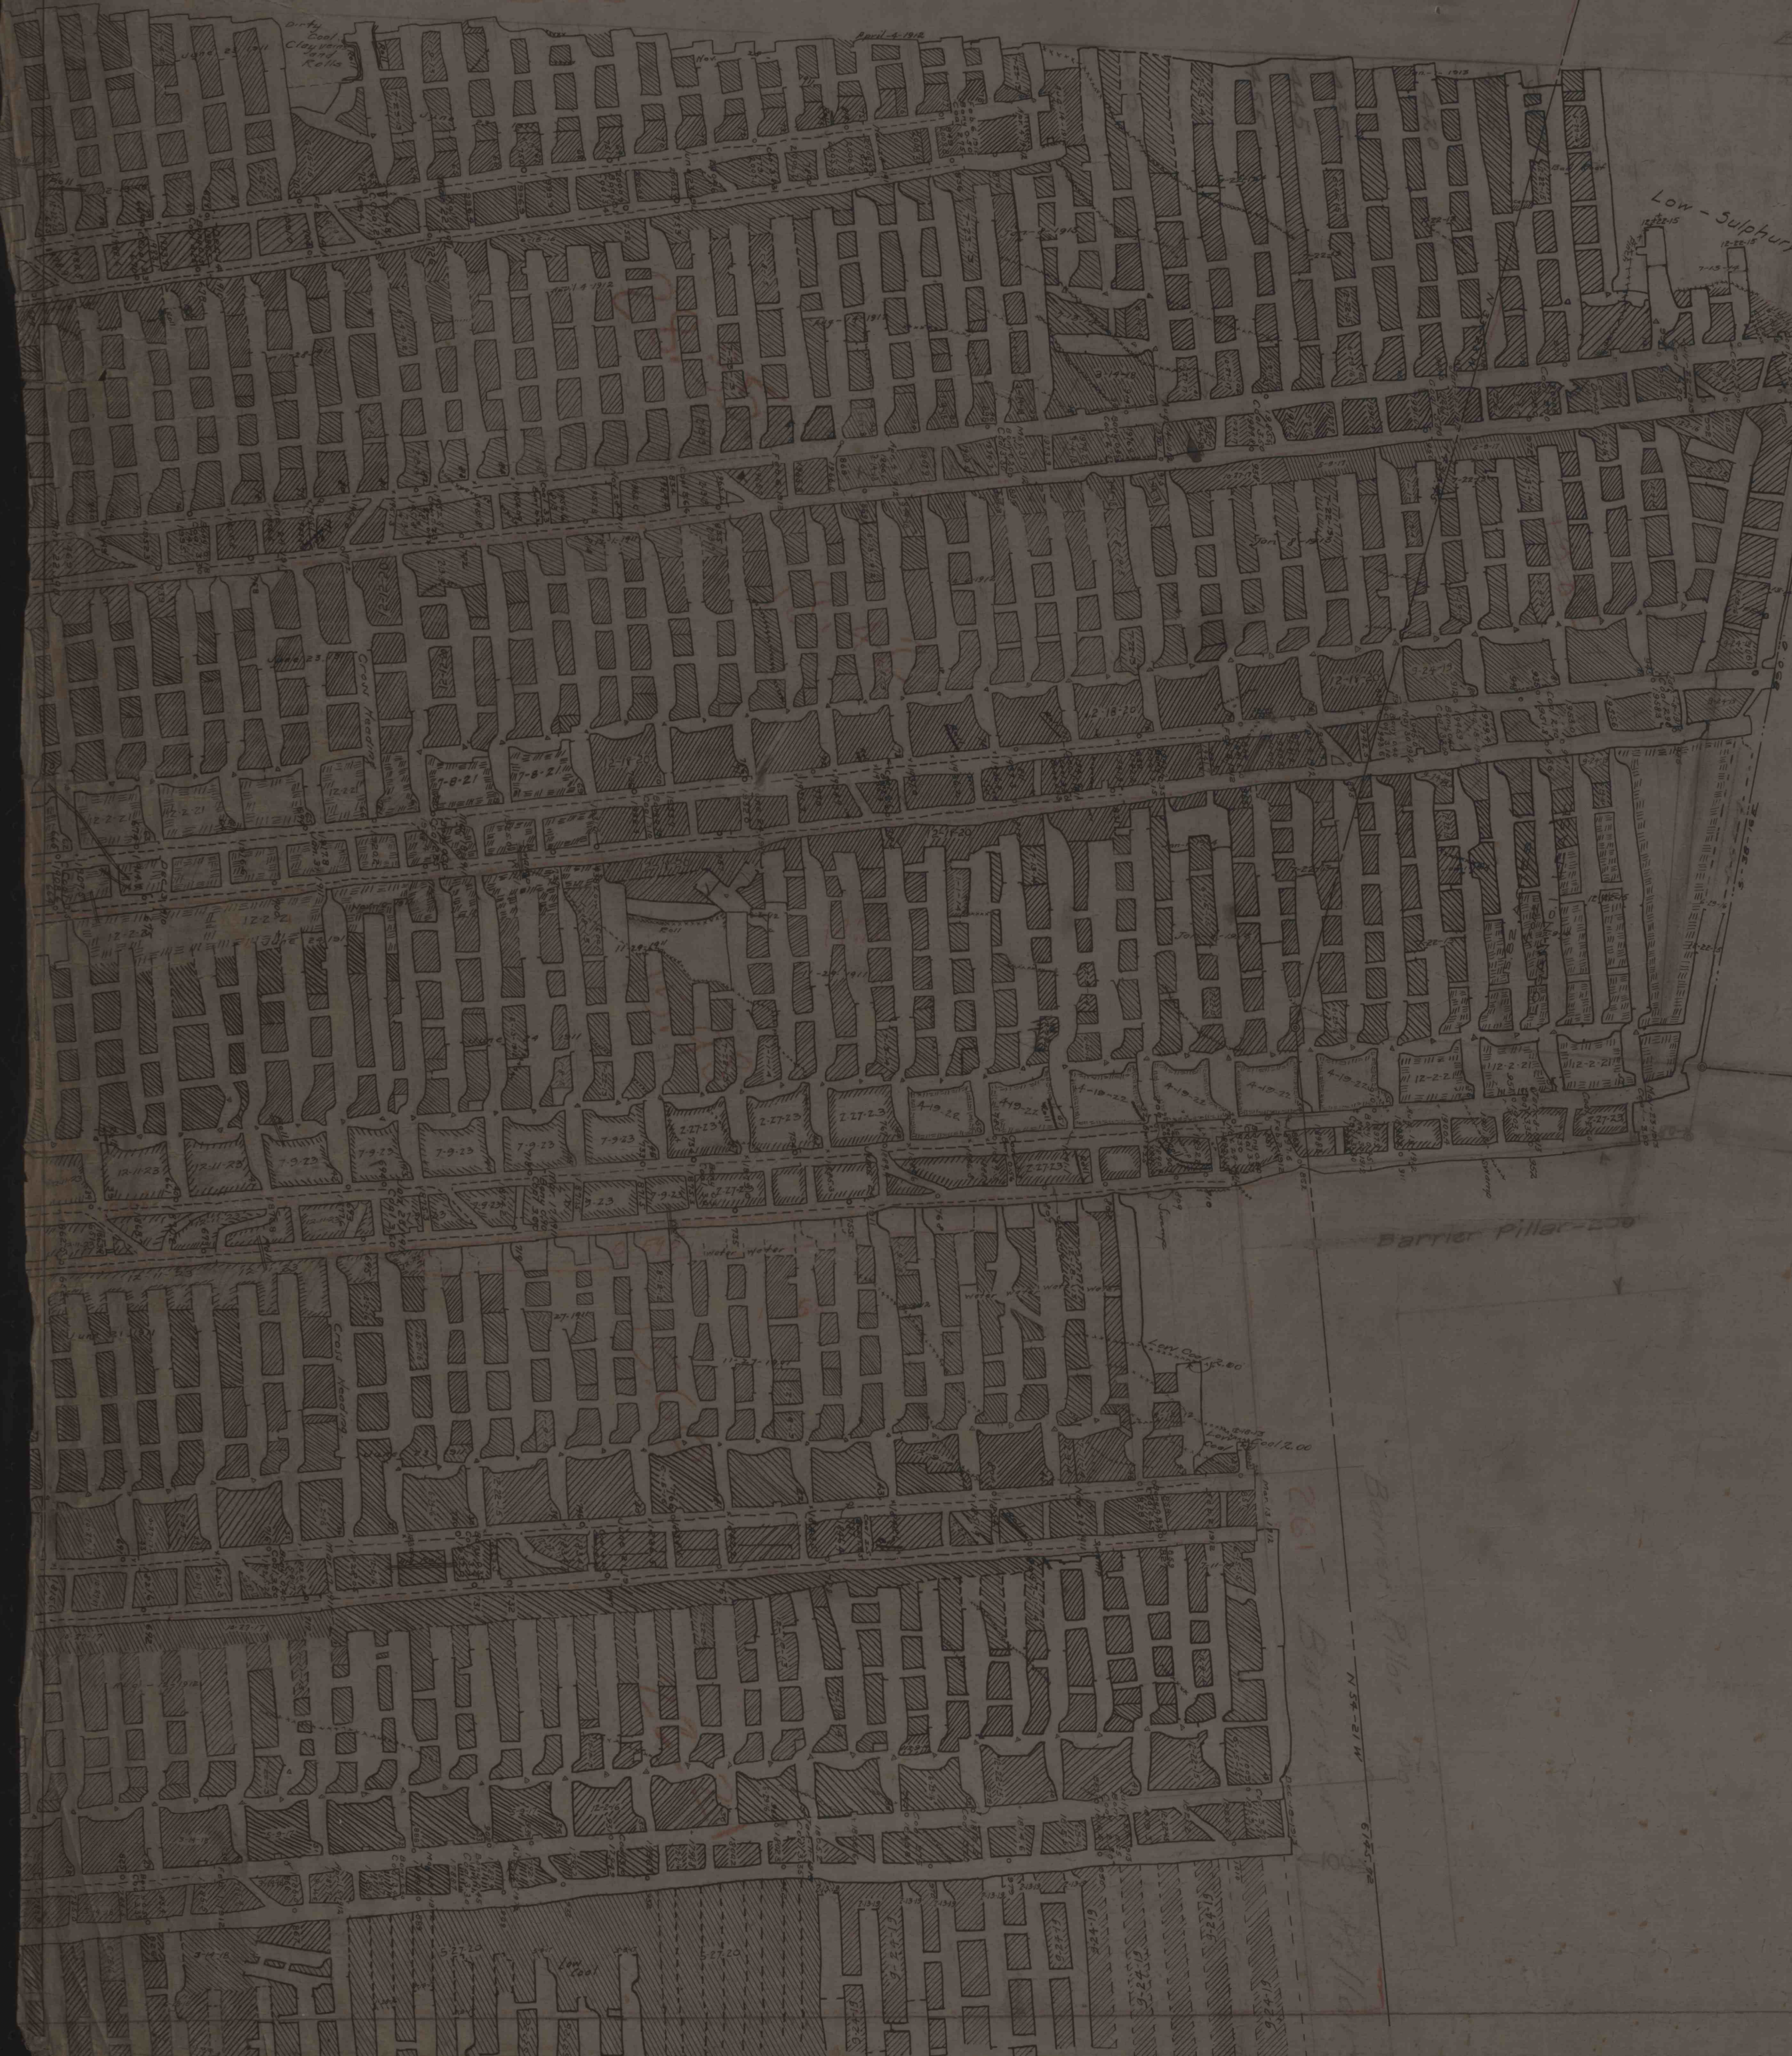

Barrier Pillar

Low-Sulphur Coal - Unmarketable

Barrier Pillar

Barrier Pillar