


ELMER
(PENN - MARY LEASEHOLD) HAAGEN

(PENN - MARY LEASEHOLD)

HAAGEN

N 43.25 W

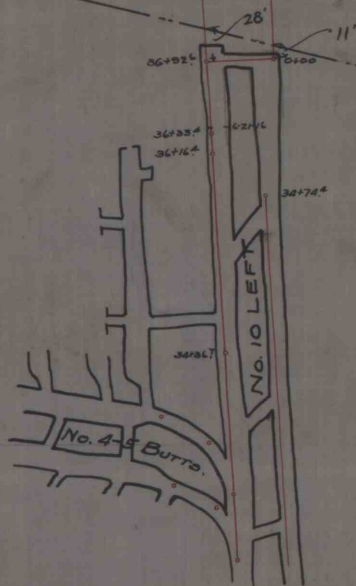

FRANK WILLIAMS
(A. J. GLENN HEIRS TRACT)

(A. J. GLENN HEIRS TRACT)

SCALE: 1 in. = 100
JUNE 4, 1917

— GREENWICH No. 3 MINE —
PLAN SHOWING DISTANCES ON NO. 10
LEFT TO PENN-MARY LEASEHOLD LINE

SCALE: 1 in. = 100 FT.
JUNE 4TH, 1917

JUNE 4TH, 1917