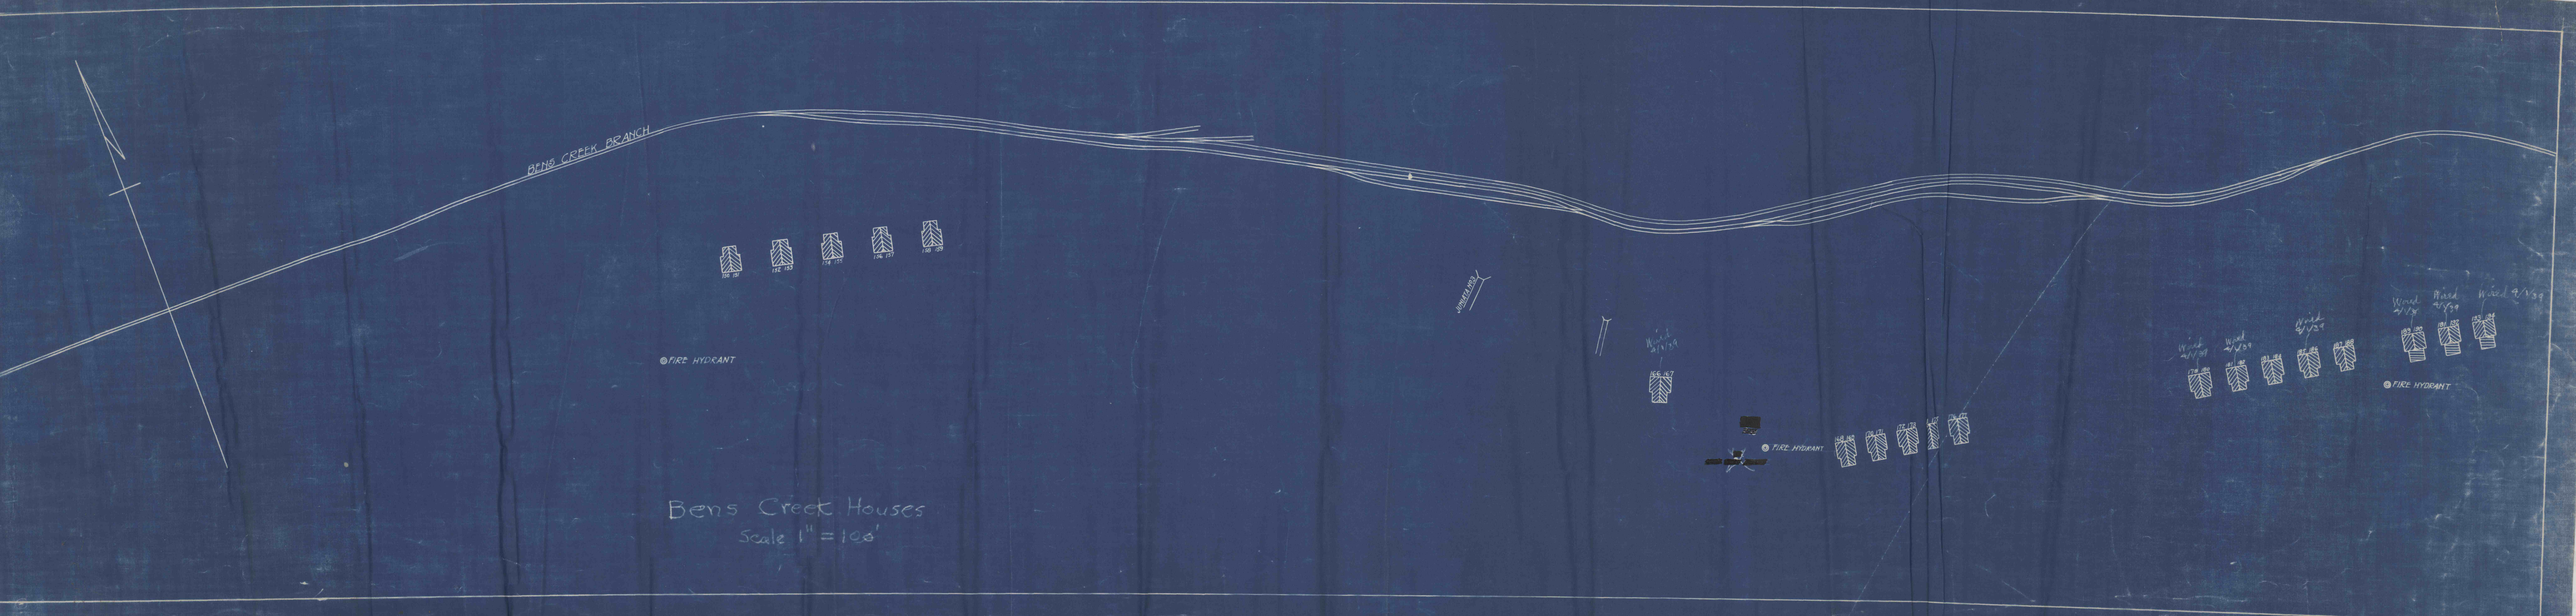
BENS CREEK BRANCH
FIRE HYDRANT
FIRE HYDRANT
FIRE HYDRANT
Bens Creek Houses
Scale 1" = 100'