



REED

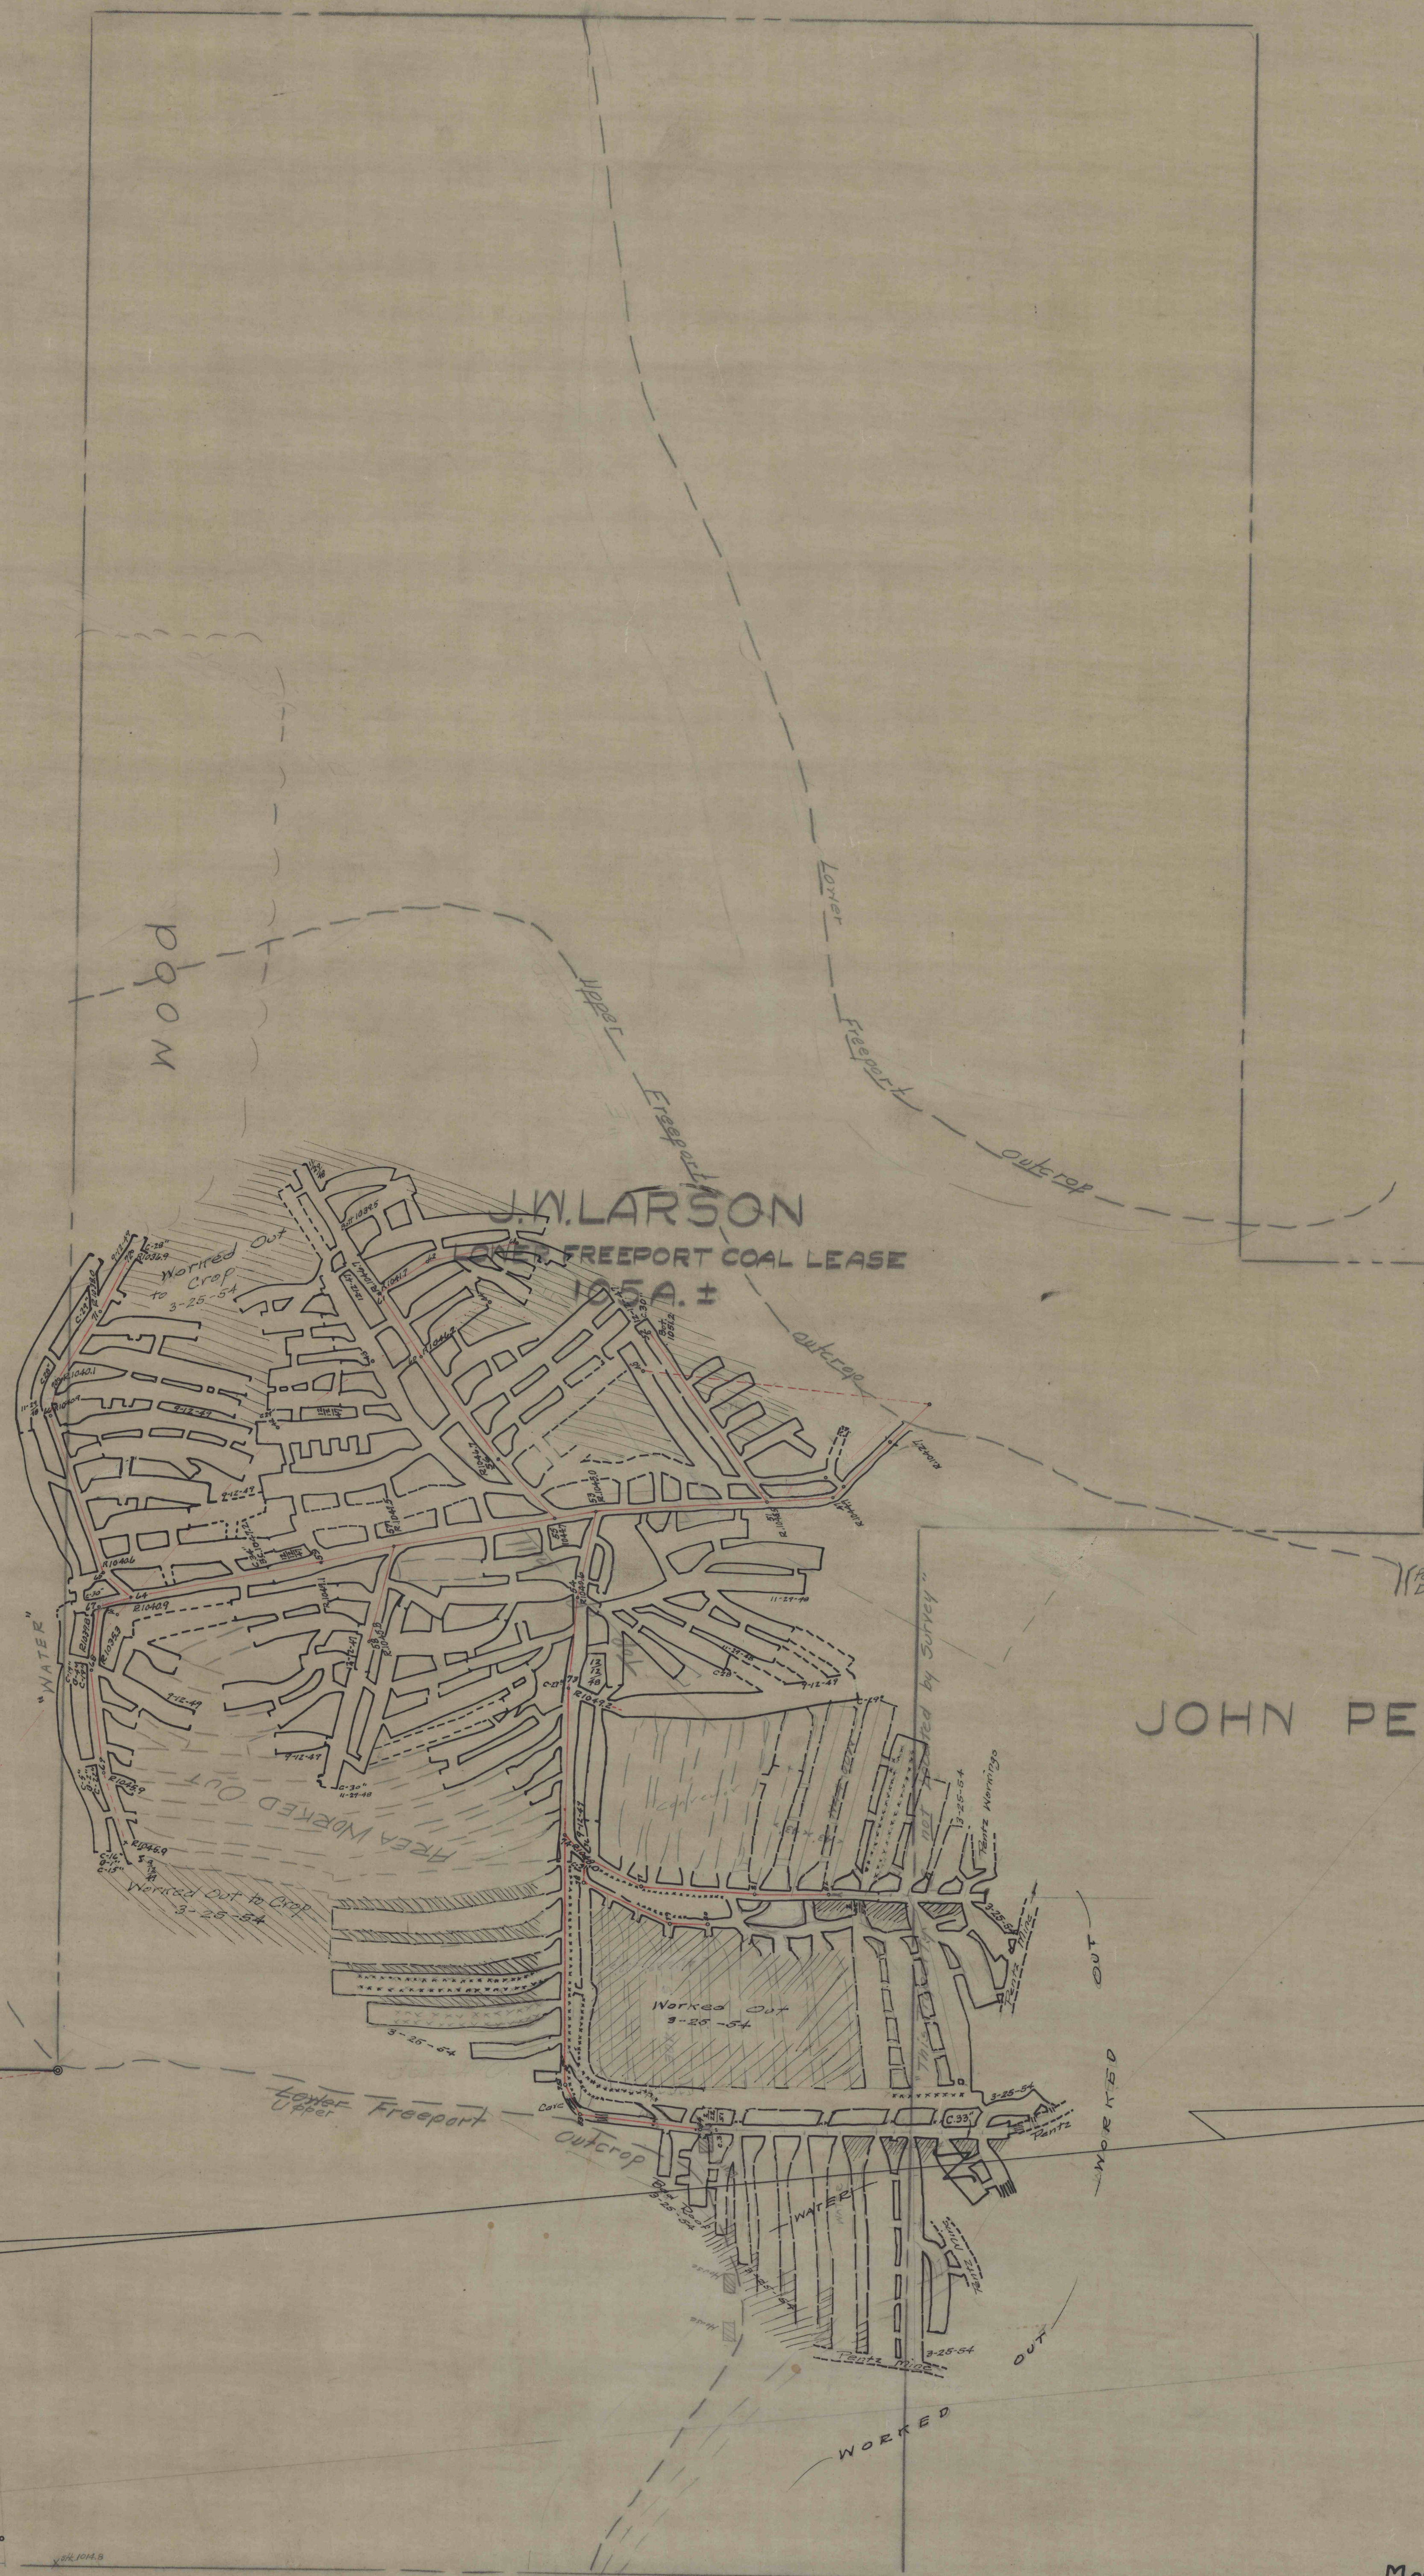

A.K. WRIGHT (COAL)

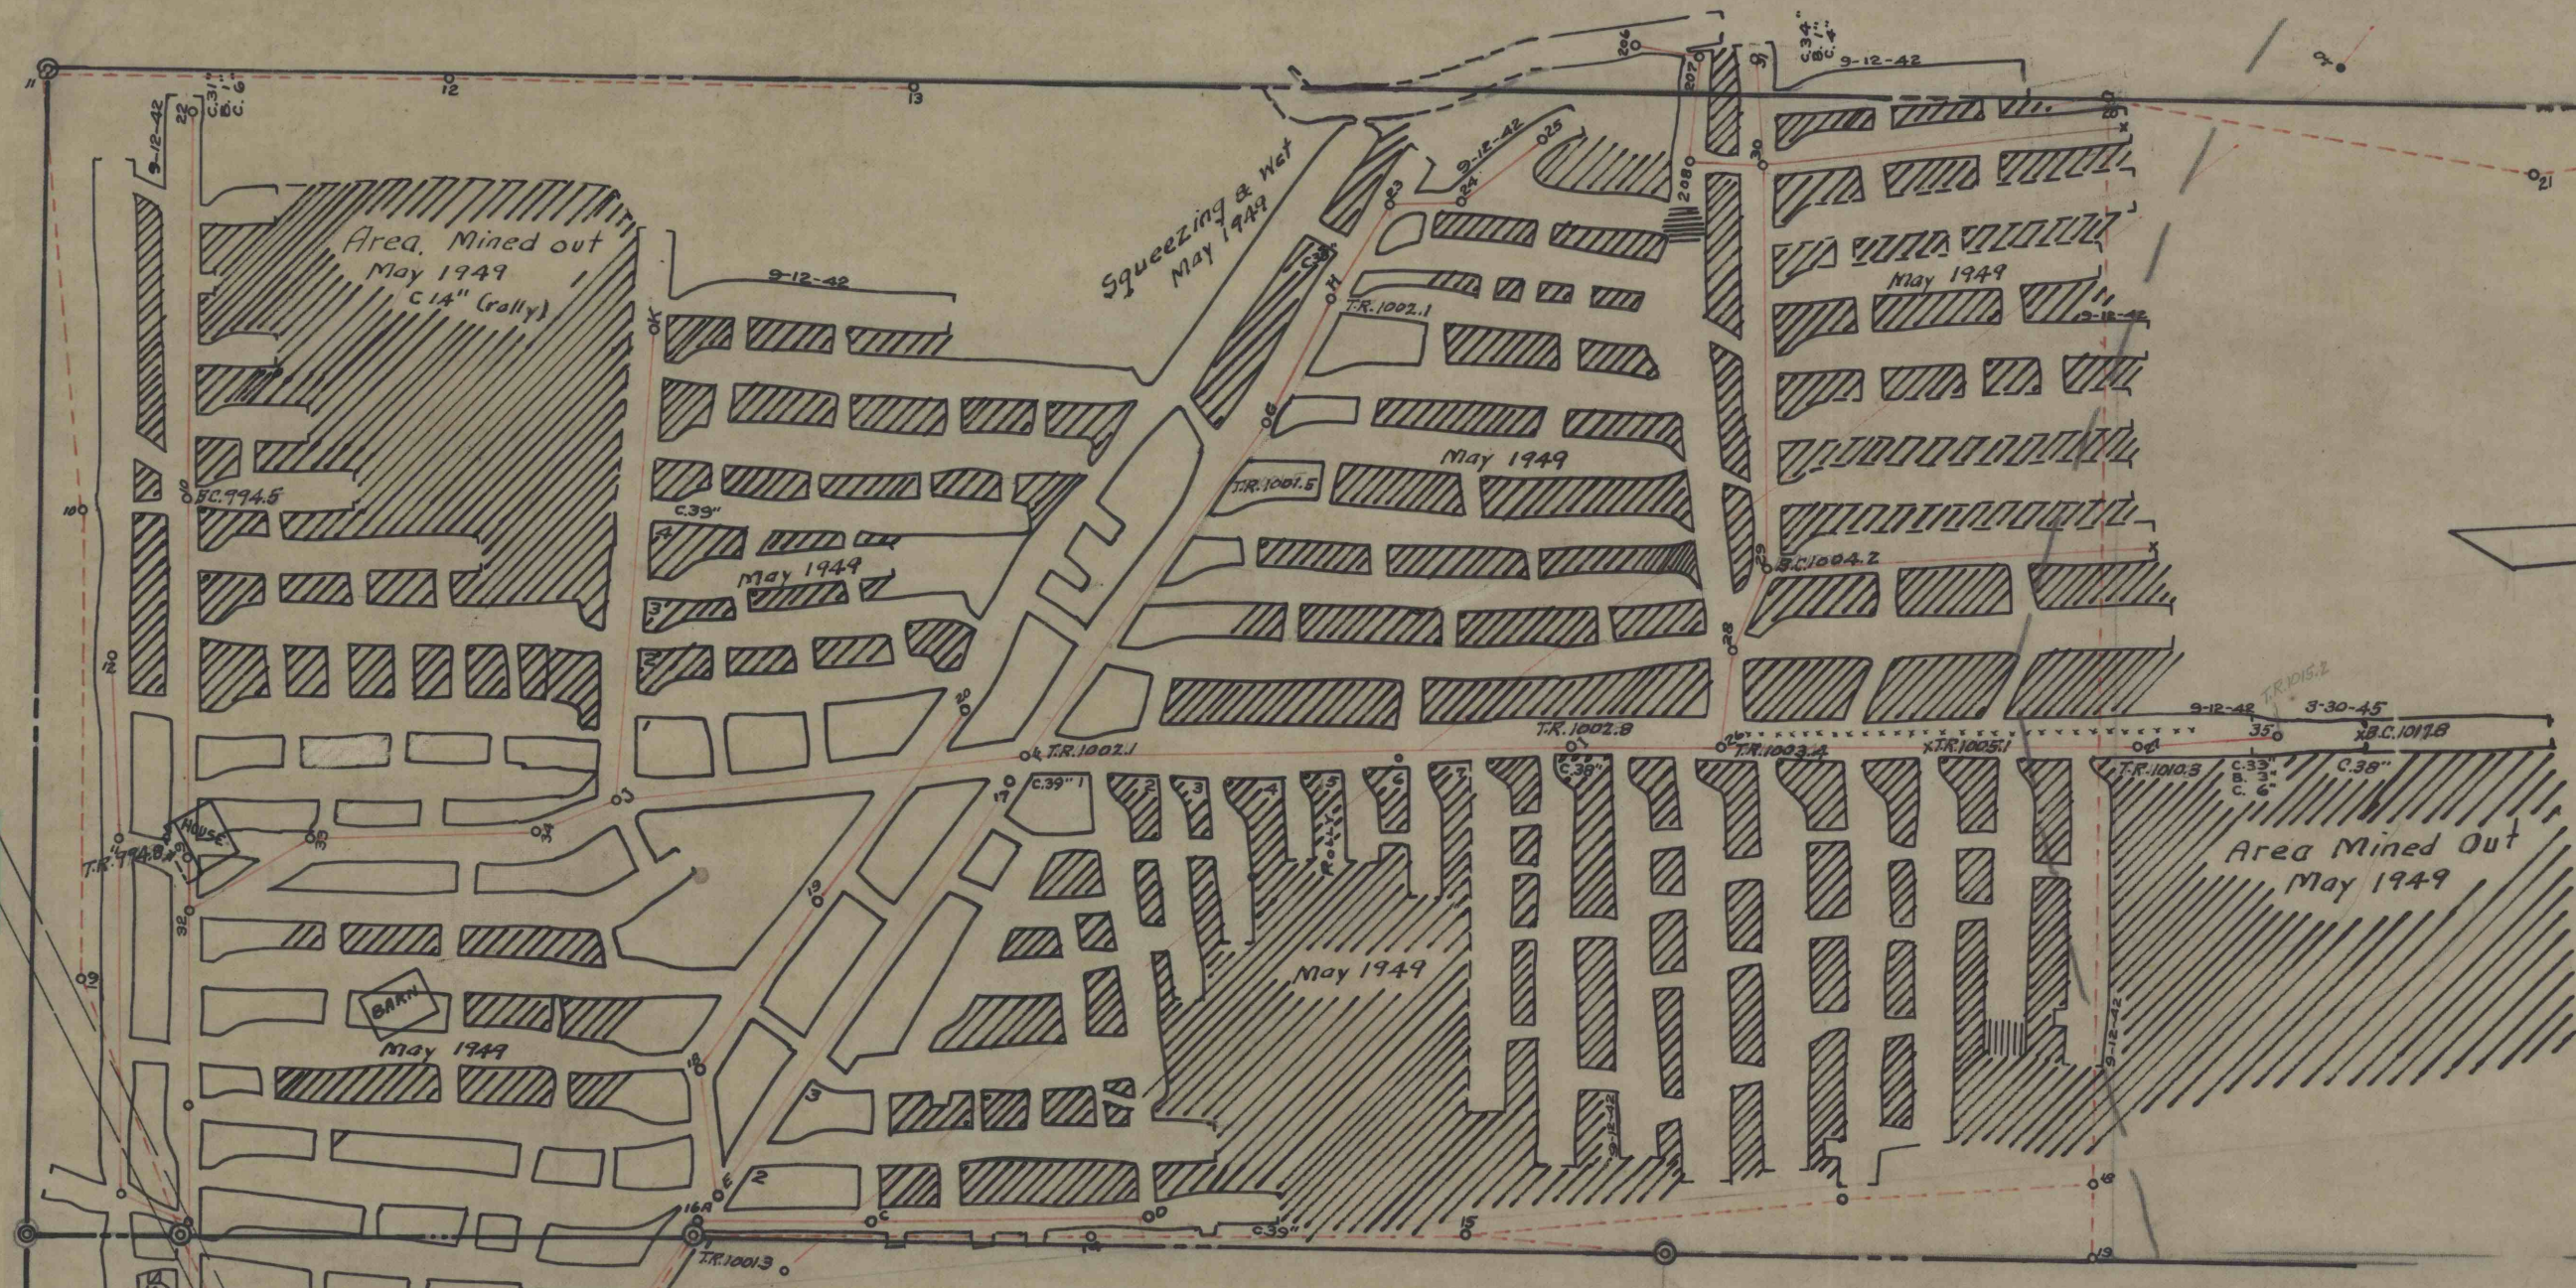

MAP SHOWING MINE OF  
**J.W. LARSON**

S.W. OF GRAMPIAN, PA.  
PENN TWP, CLFD. CO., PA.  
SCALE 1"=100'

CLEARFIELD, PA. NEW YORK  
SEPTEMBER 12, 1942 N.E.L. 5017128

Map has showing  
MINING OPERATIONS OF  
**THE A.P. COAL COMPANY**  
Clearfield Co.  
PENN TWP. Clearfield Co.  
SCALE 1"=100'

THE ENGINEERING OFFICES - YOST BRONFIELD & HESS  
- CLEARFIELD, PENN.  
DECEMBER 12, 1942

Surveys To:-  

12  
N.E.L. 5017128

245  
246

245  
246