


Junction Line

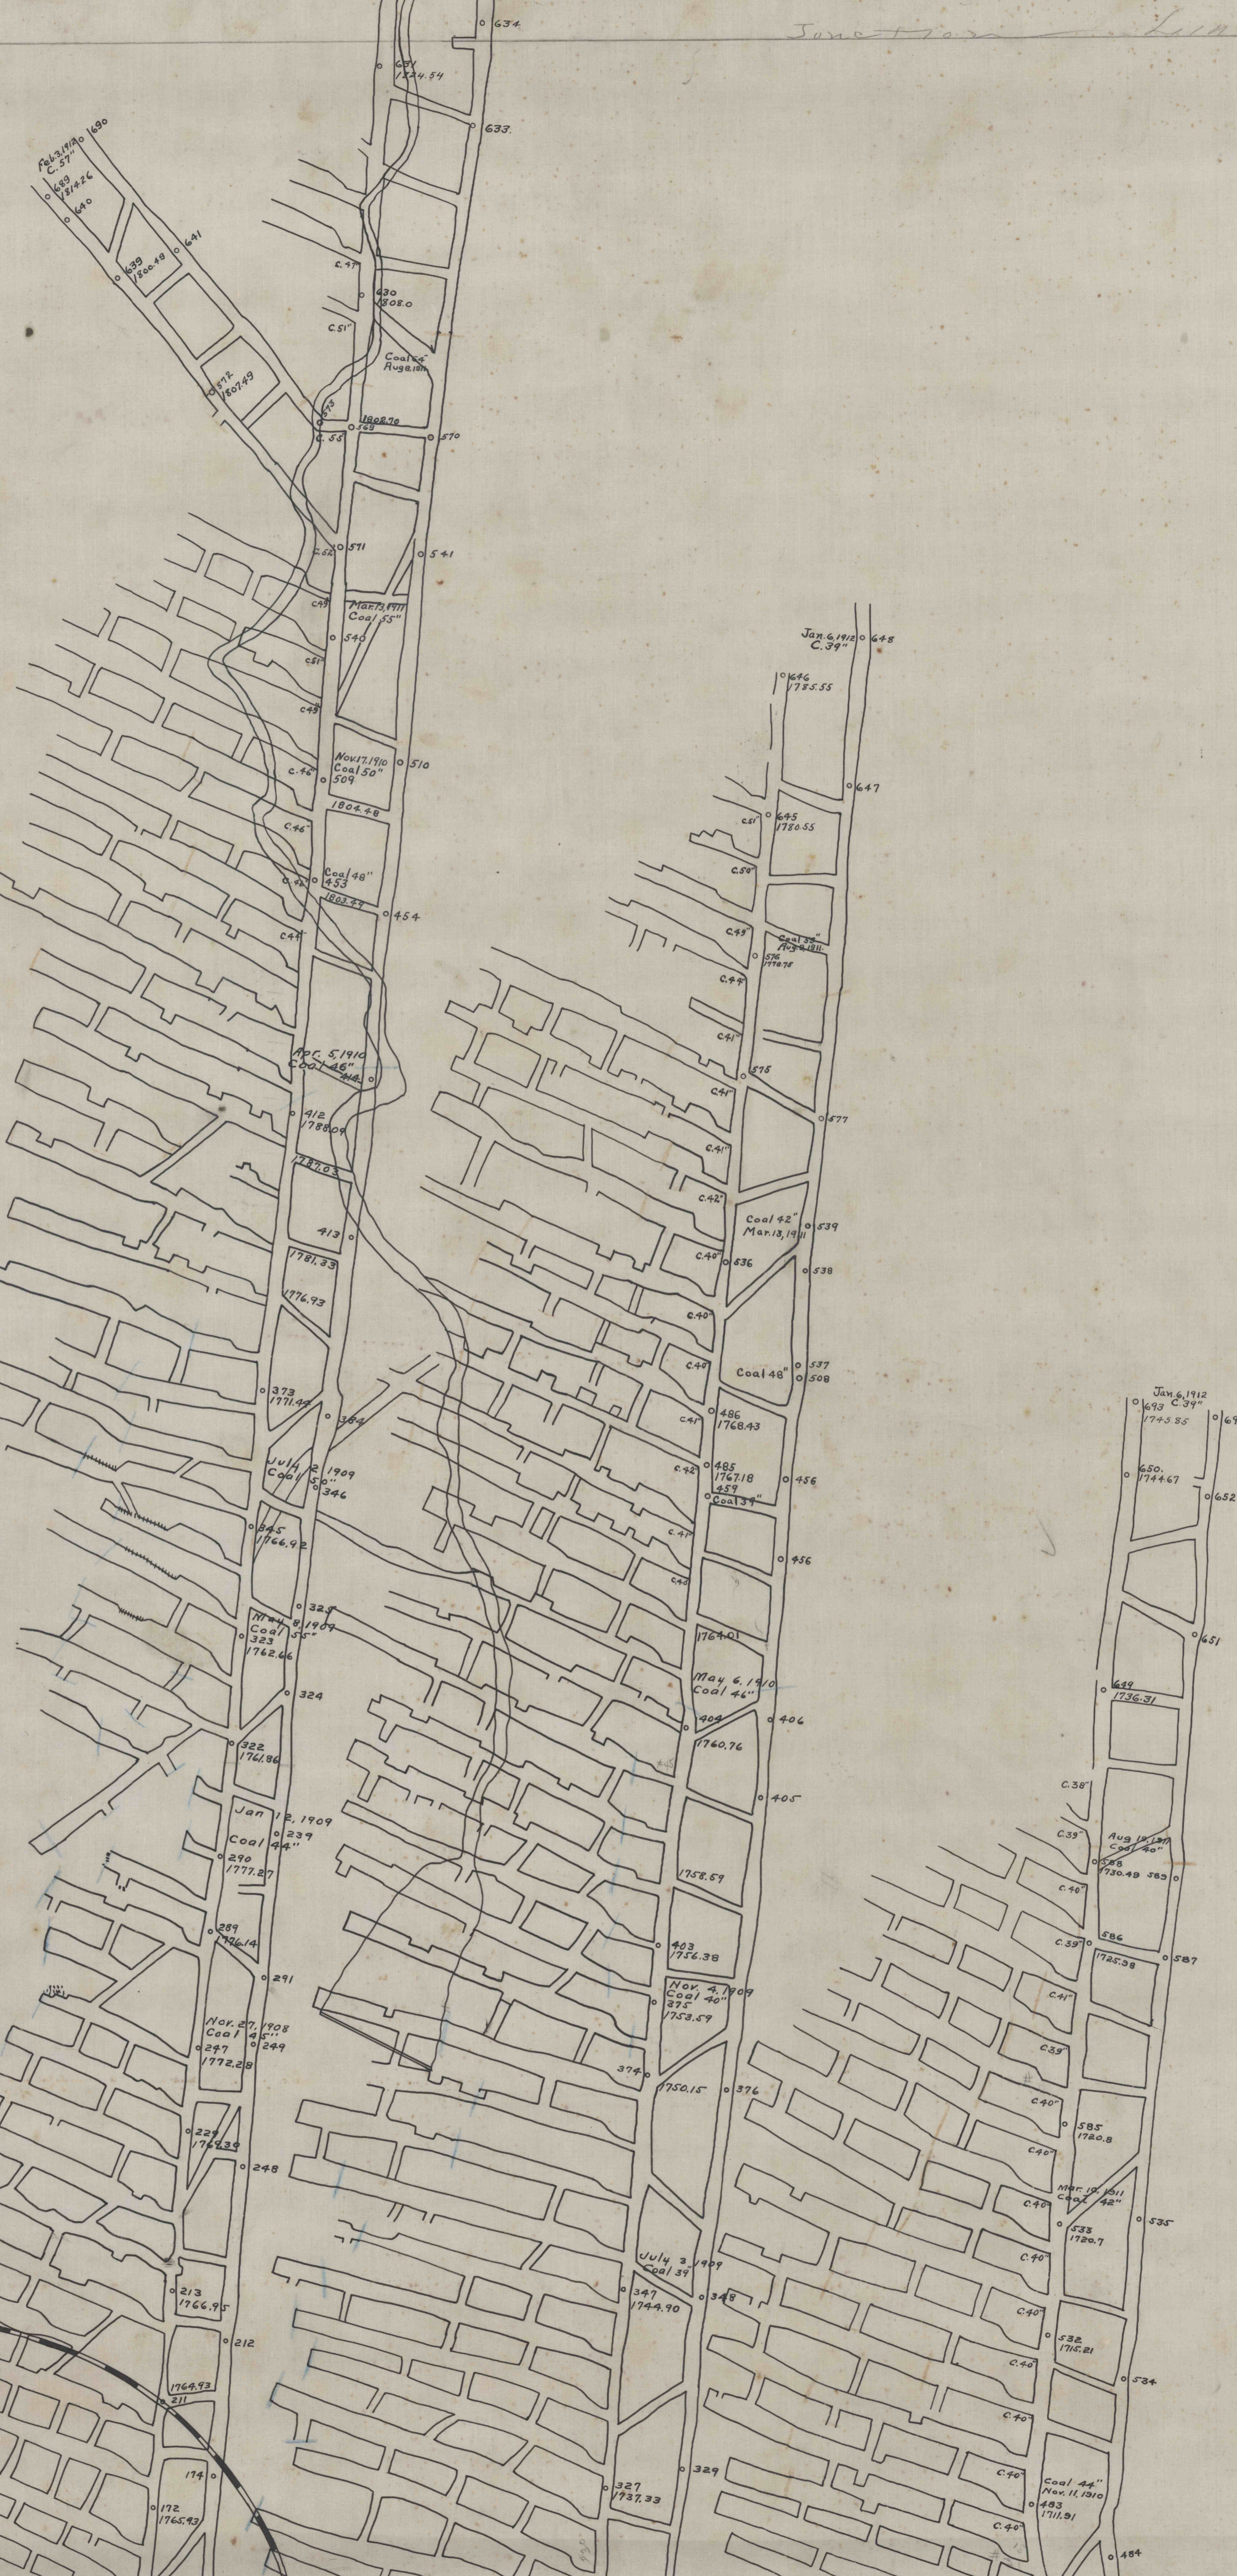

Summit Water Supply Co
Reservoir

PORTAGE 2 and works

Junction Line
Portage Coal Mining Co
Nos 2 & 4.