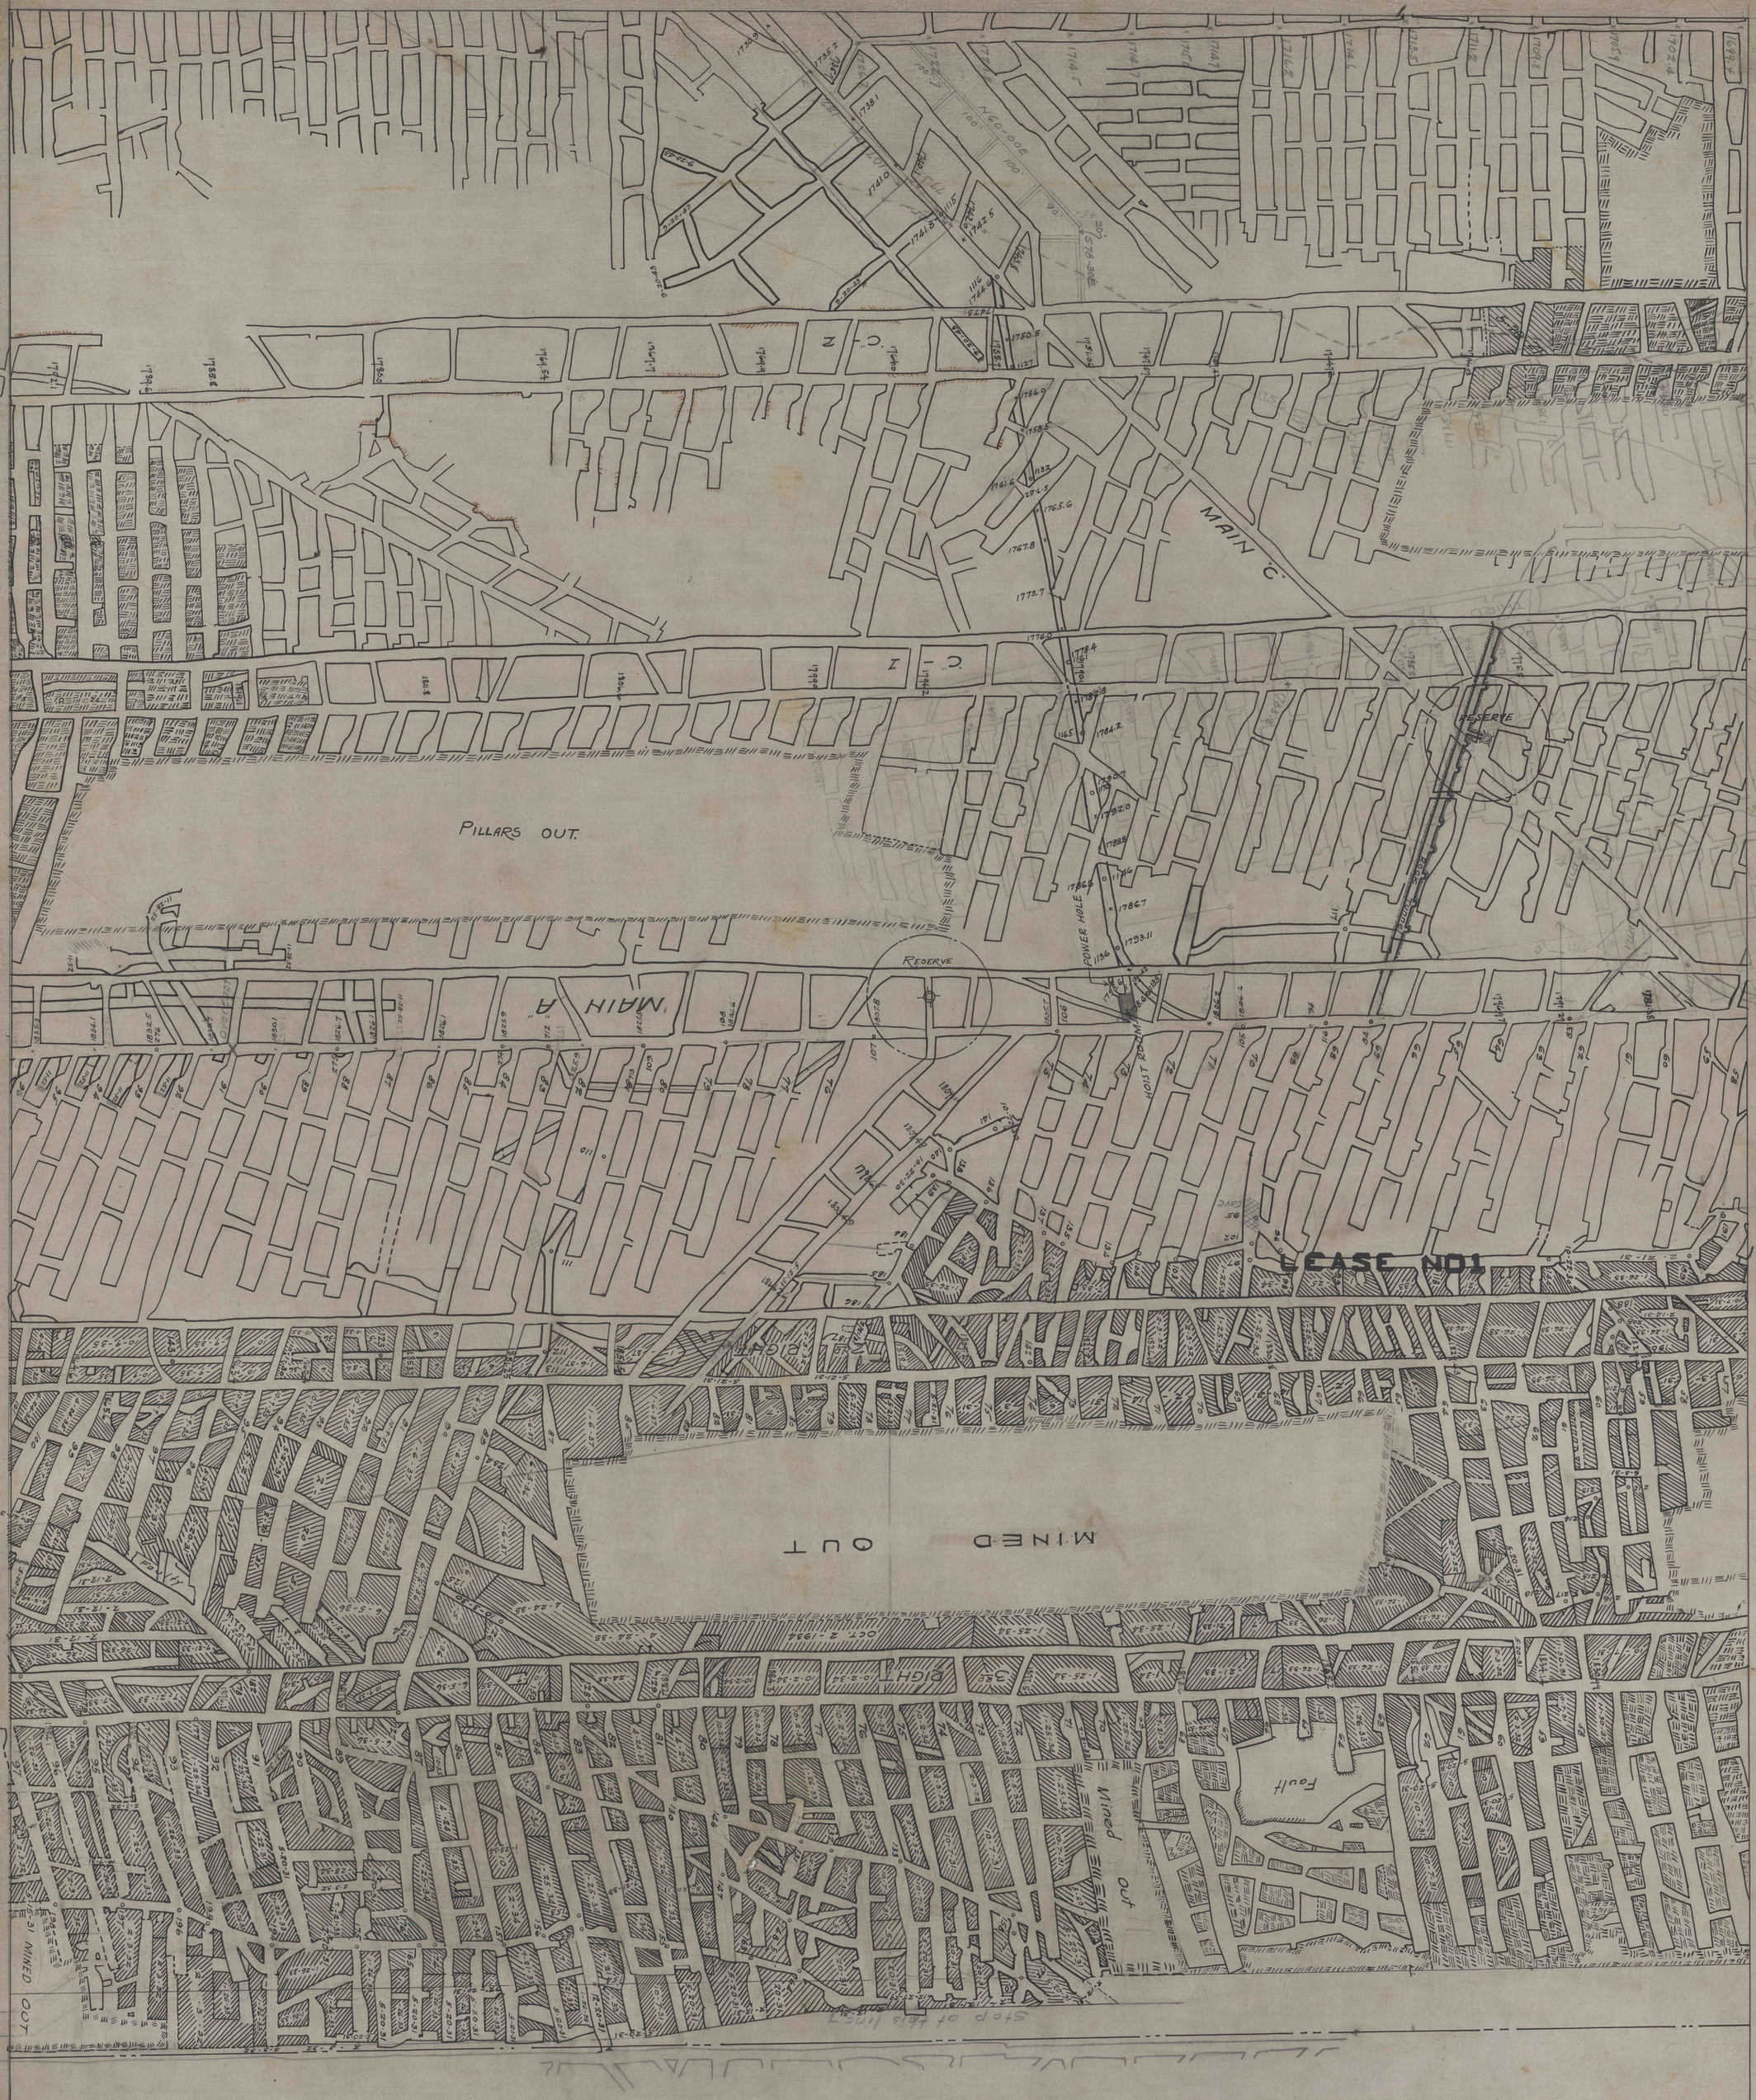

MAIN "C"
C-2
C-1
PILLARS OUT.
RESERVE
POWER HOLE
MAIN "A"
HOIST ROOM
LEASE NO1
MINED OUT
OCT. 2-1934
3RD RIGHT
Fault
Mined out
Stop of this line