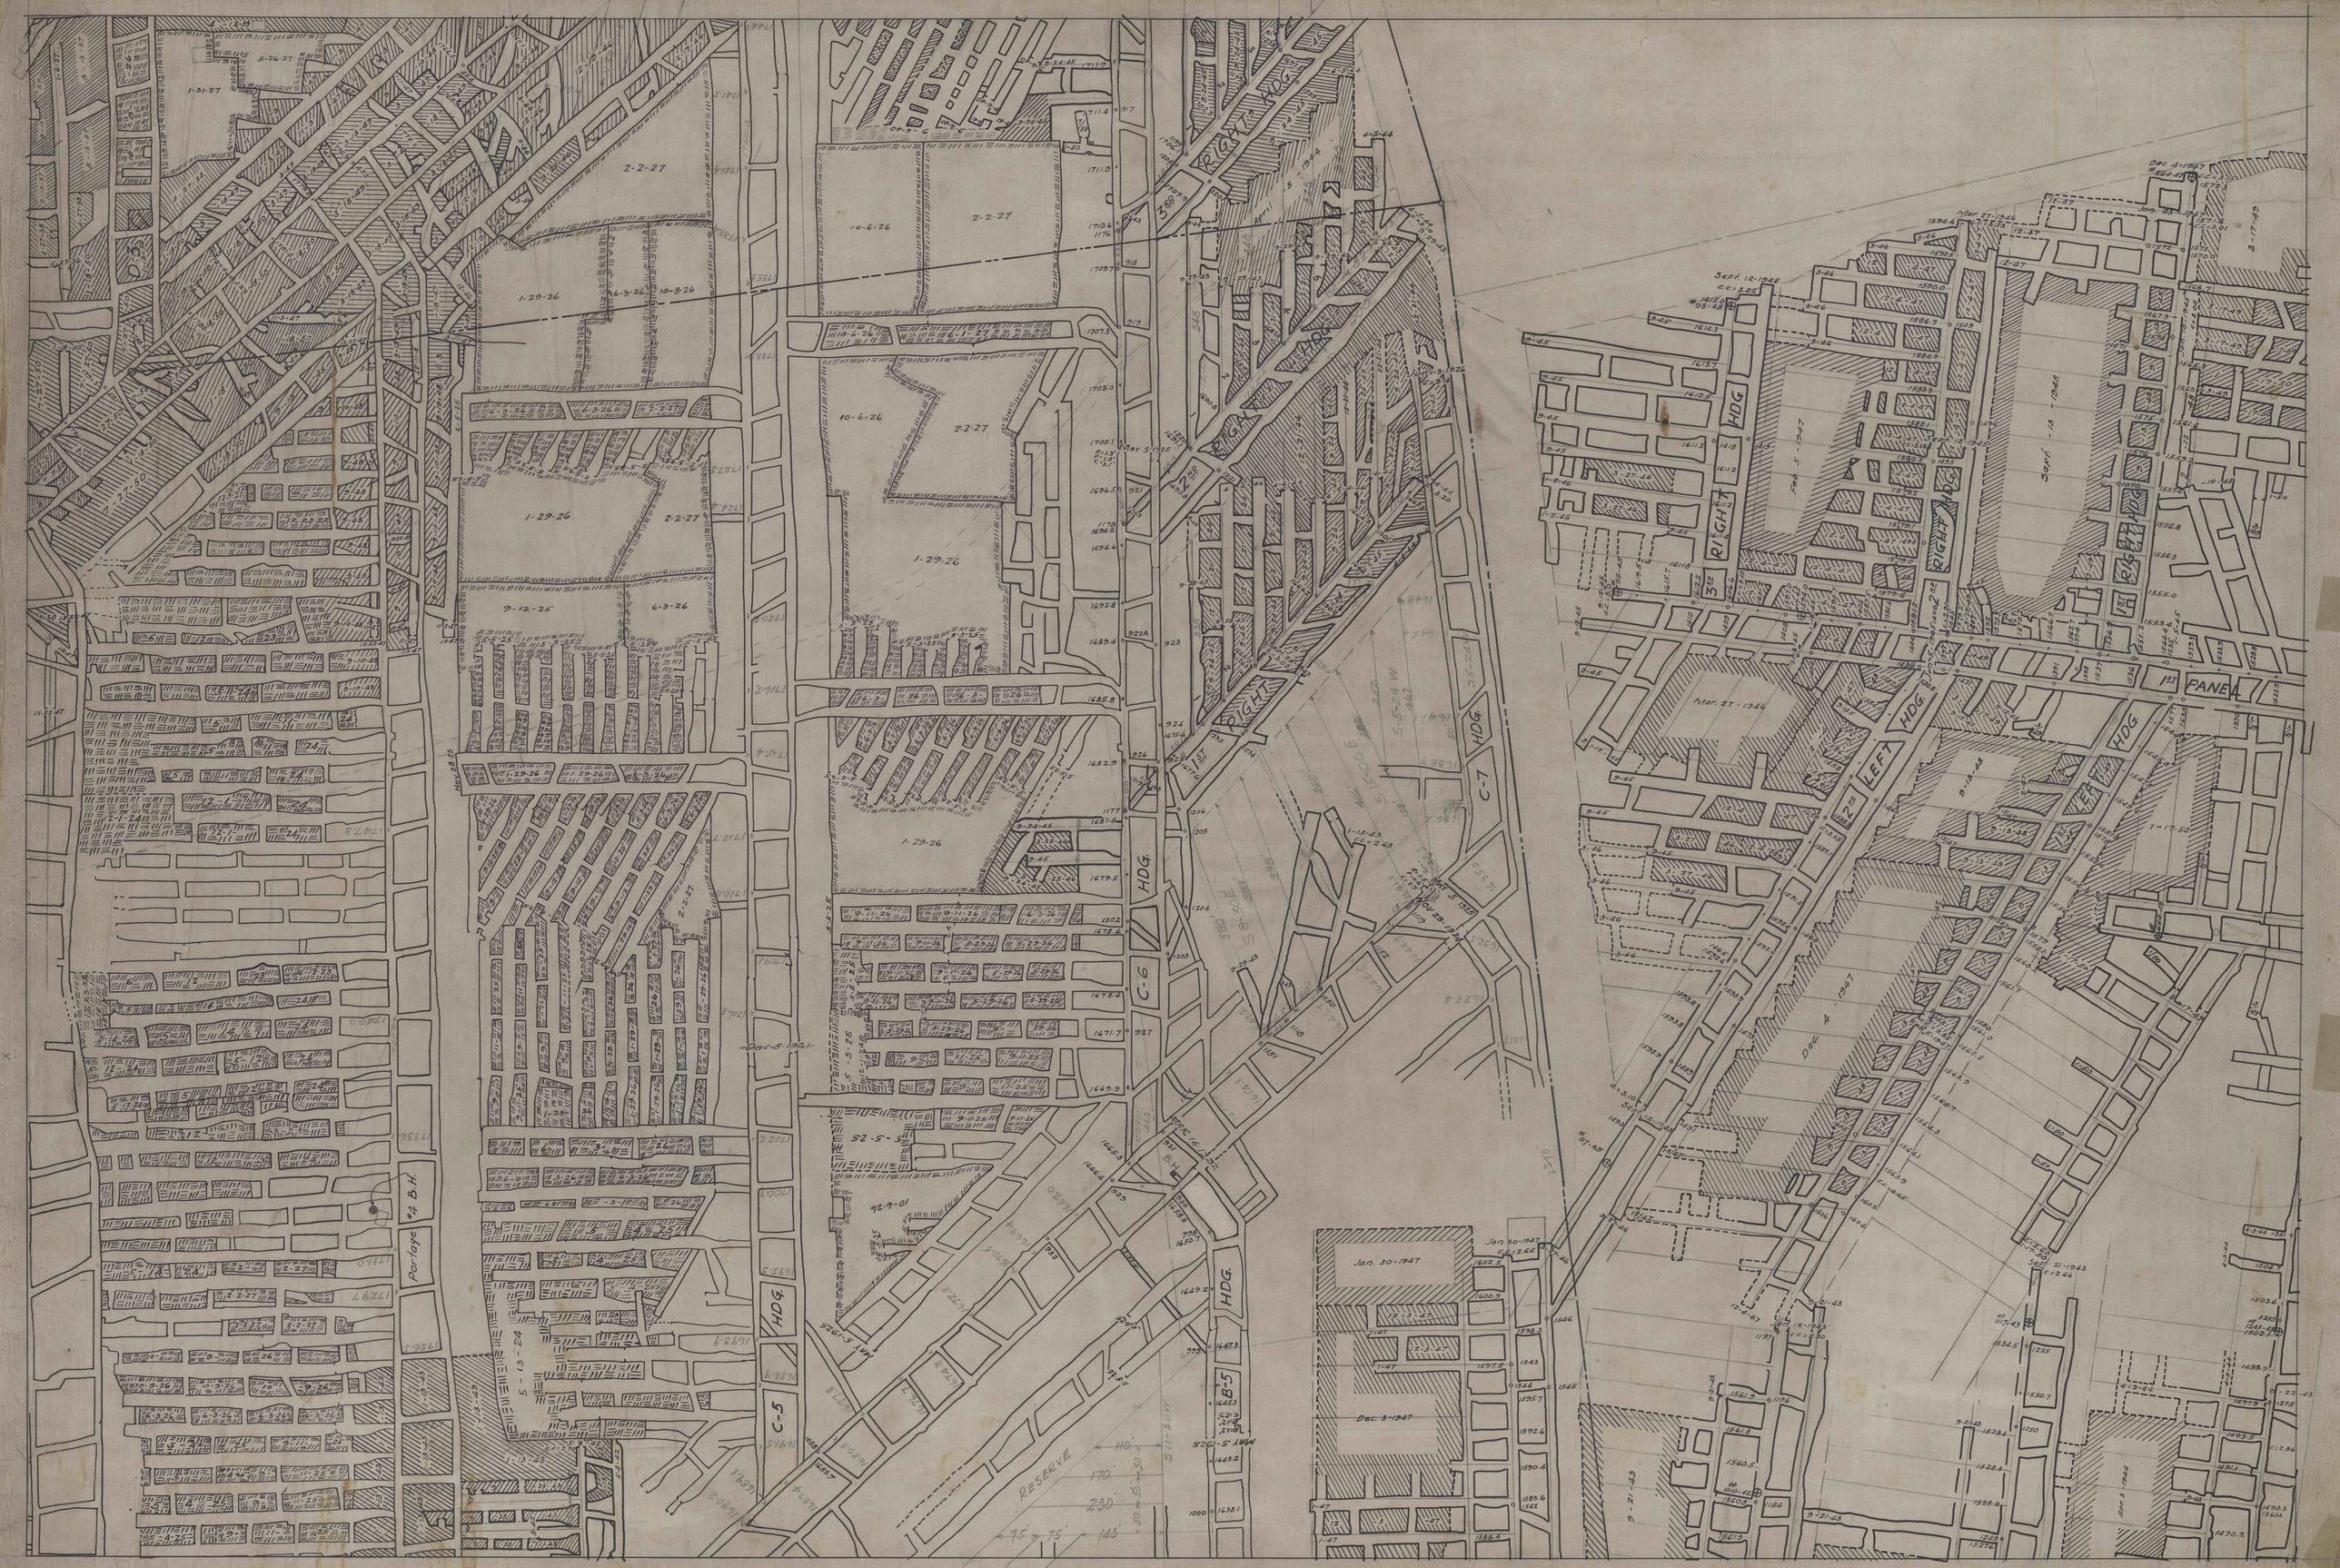

RIGHT HDG.
LEFT HDG.
1ST PANEL
C-7
C-6
C-5
B-5
Portage #4 B.H.
RESERVE
Jan. 30-1947
Dec. 3-1947
Mar. 27-1946
Sept. 12-1945
Dec. 4-1947