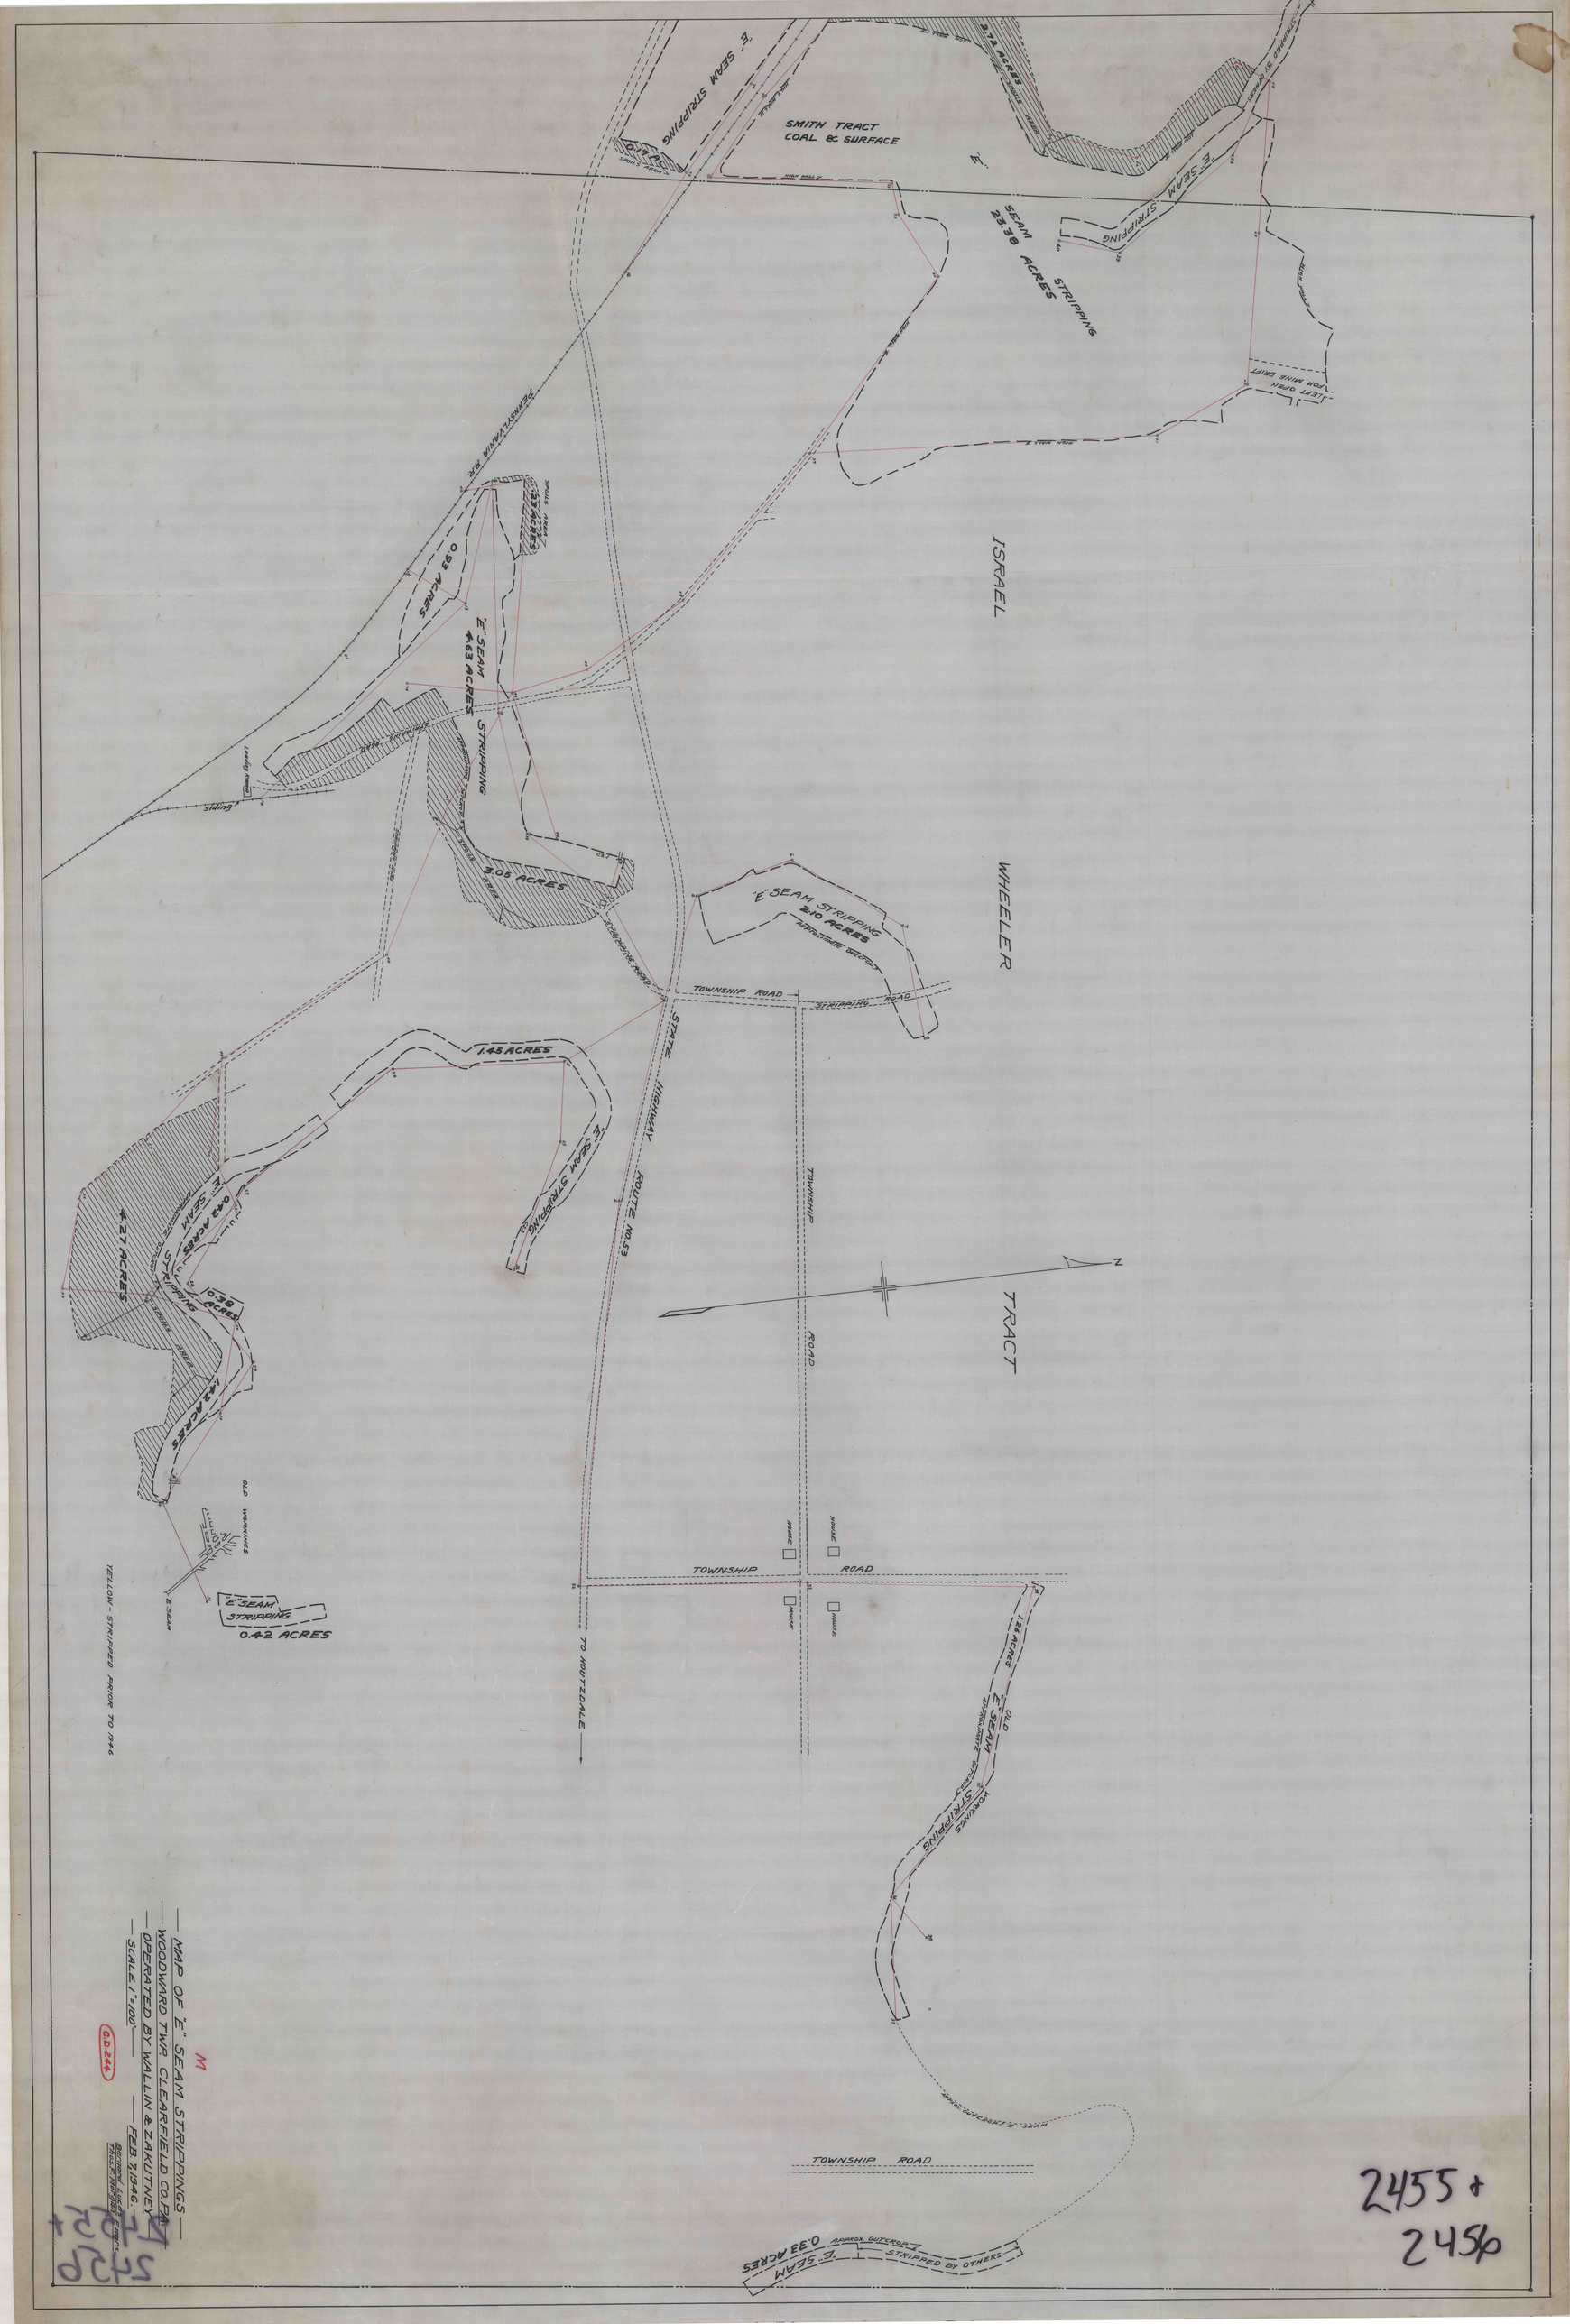
SMITH TRACT
COAL & SURFACE
E SEAM STRIPPING
E SEAM STRIPPING
SEAM 23.38 ACRES STRIPPING
E SEAM STRIPPING
0.93 ACRES
E SEAM 4.63 ACRES STRIPPING
9.08 ACRES
"E" SEAM STRIPPING 2.10 ACRES
ISRAEL
WHEELER
TRACT
TOWNSHIP ROAD
STATE HIGHWAY ROUTE NO. 53
1.45 ACRES
E SEAM STRIPPING
4.27 ACRES
0.42 ACRES
1.45 ACRES
E SEAM STRIPPING
1.38 ACRES
E SEAM STRIPPING
0.42 ACRES
OLD WORKINGS
TOWNSHIP ROAD
TO HUNTSDALE
1.84 ACRES
E SEAM STRIPPING
OLD WORKINGS
TOWNSHIP ROAD
0.33 ACRES
"E" SEAM STRIPPED BY OTHERS
YELLOW - STRIPPED PRIOR TO 1946
MAP OF "E" SEAM STRIPPINGS
WOODWARD TWP. CLEARFIELD CO. PA.
OPERATED BY WALLIN & ZAKUTNEY
SCALE 1"=100'
FEB 3, 1946
C.D.244
5722
2455 + 2456