


1542

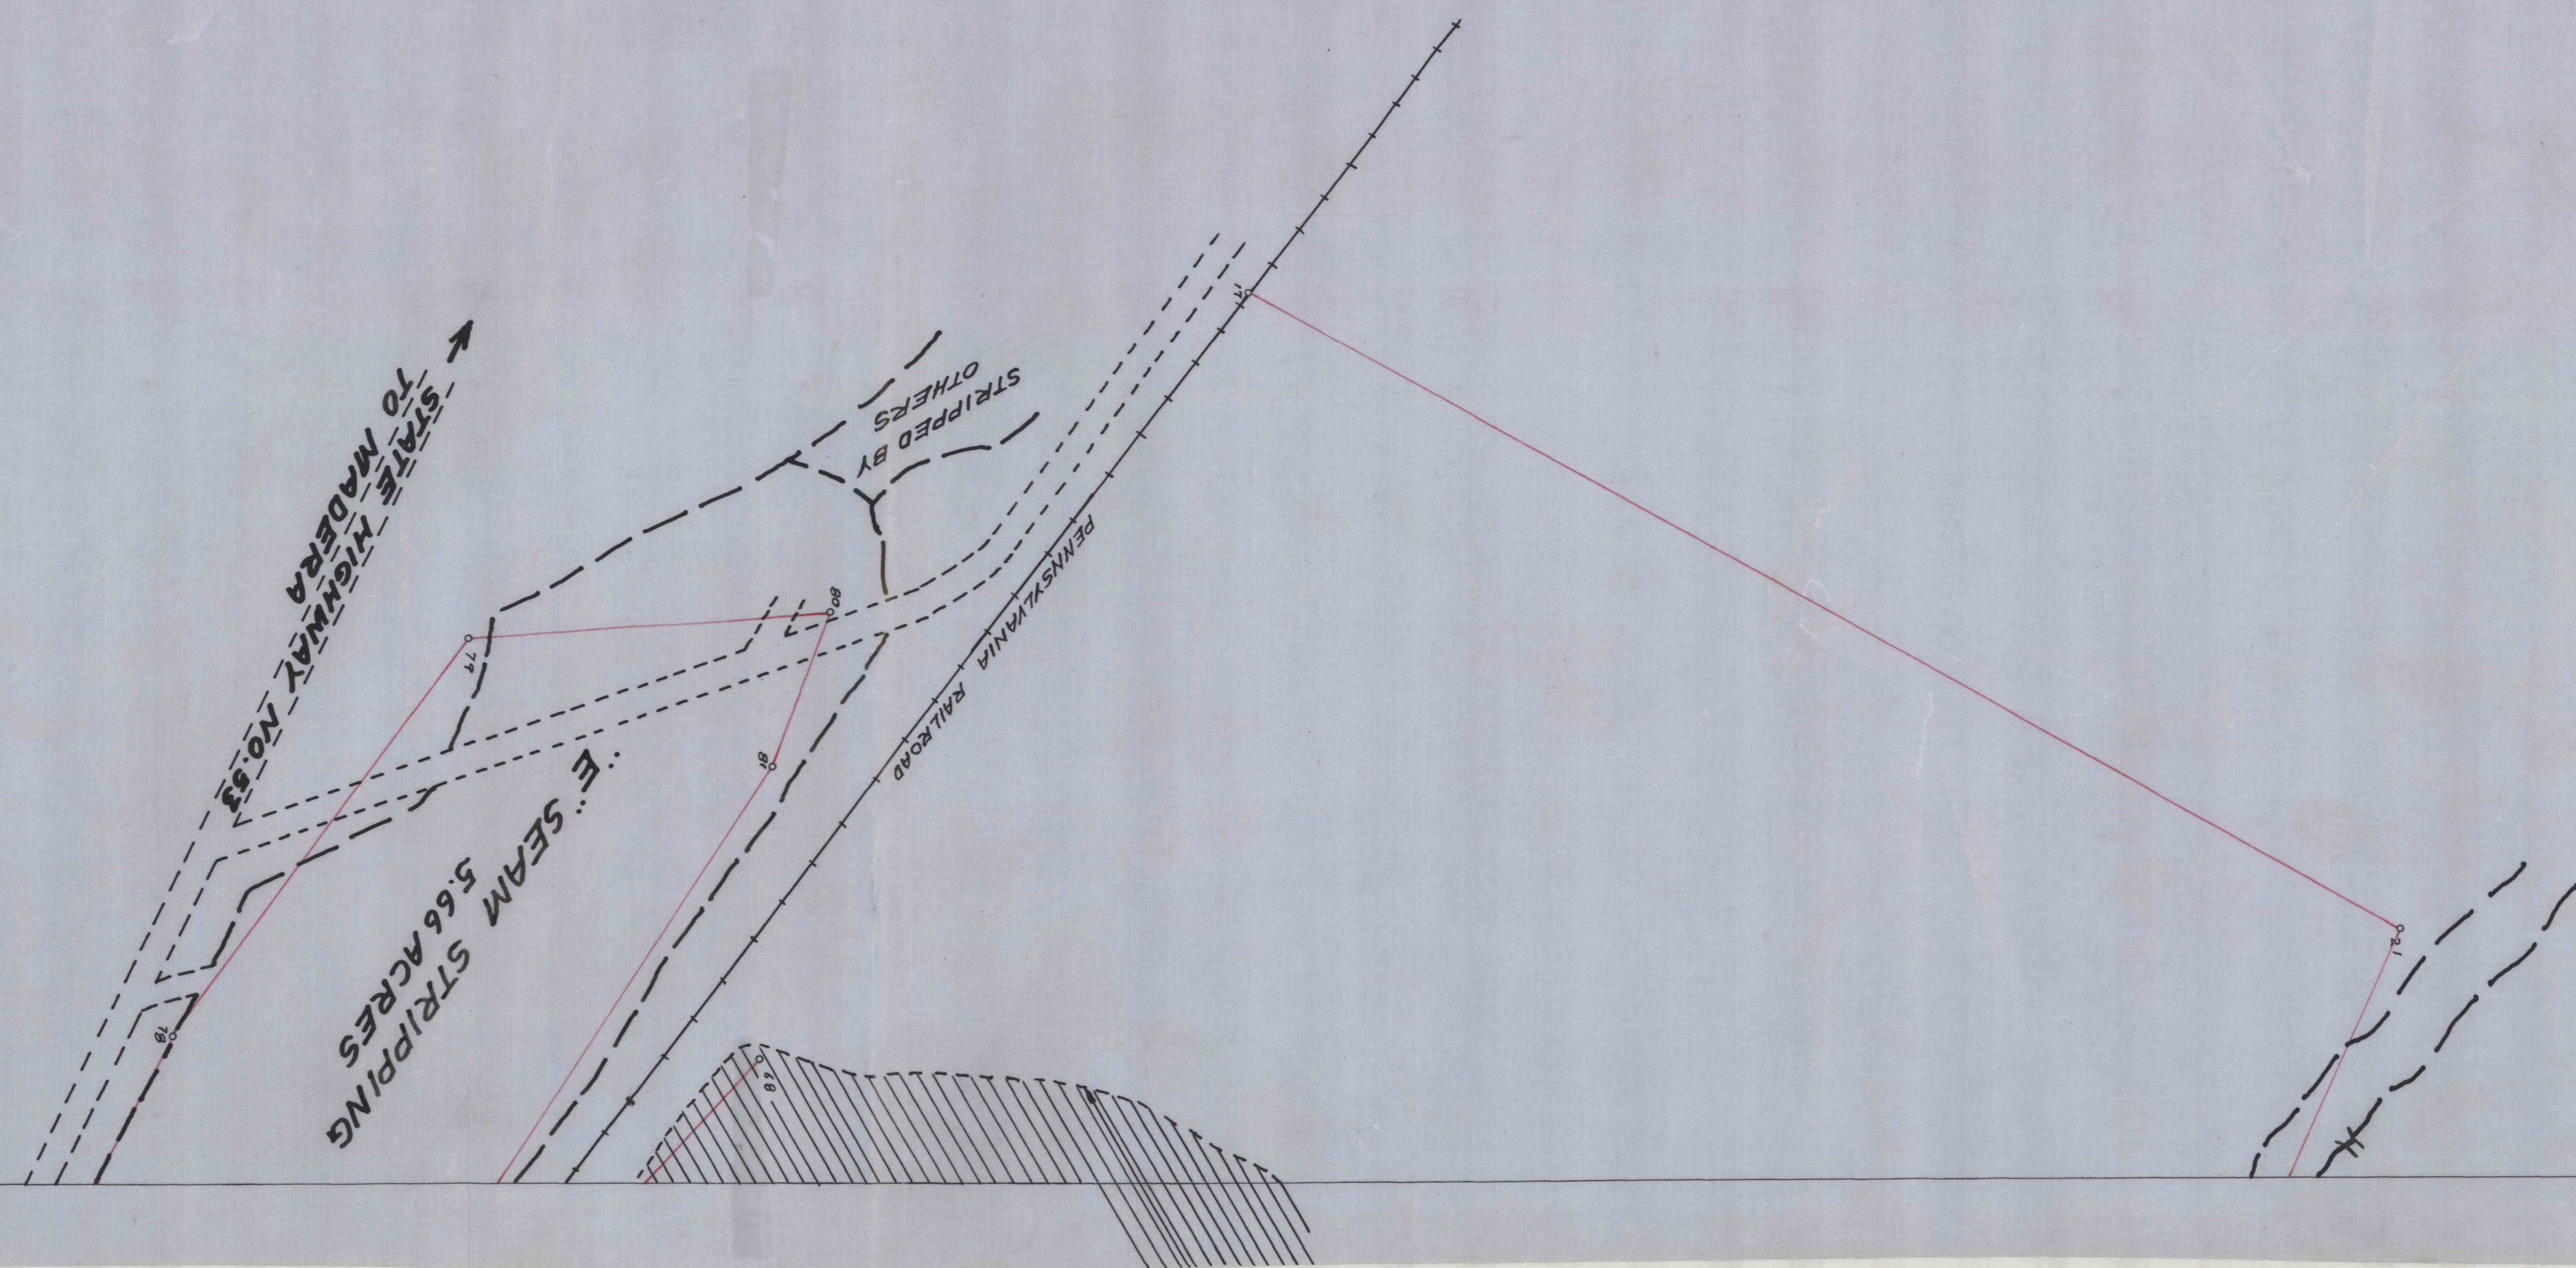

M  
C.D. 244

3427