


B.F. McCULLY

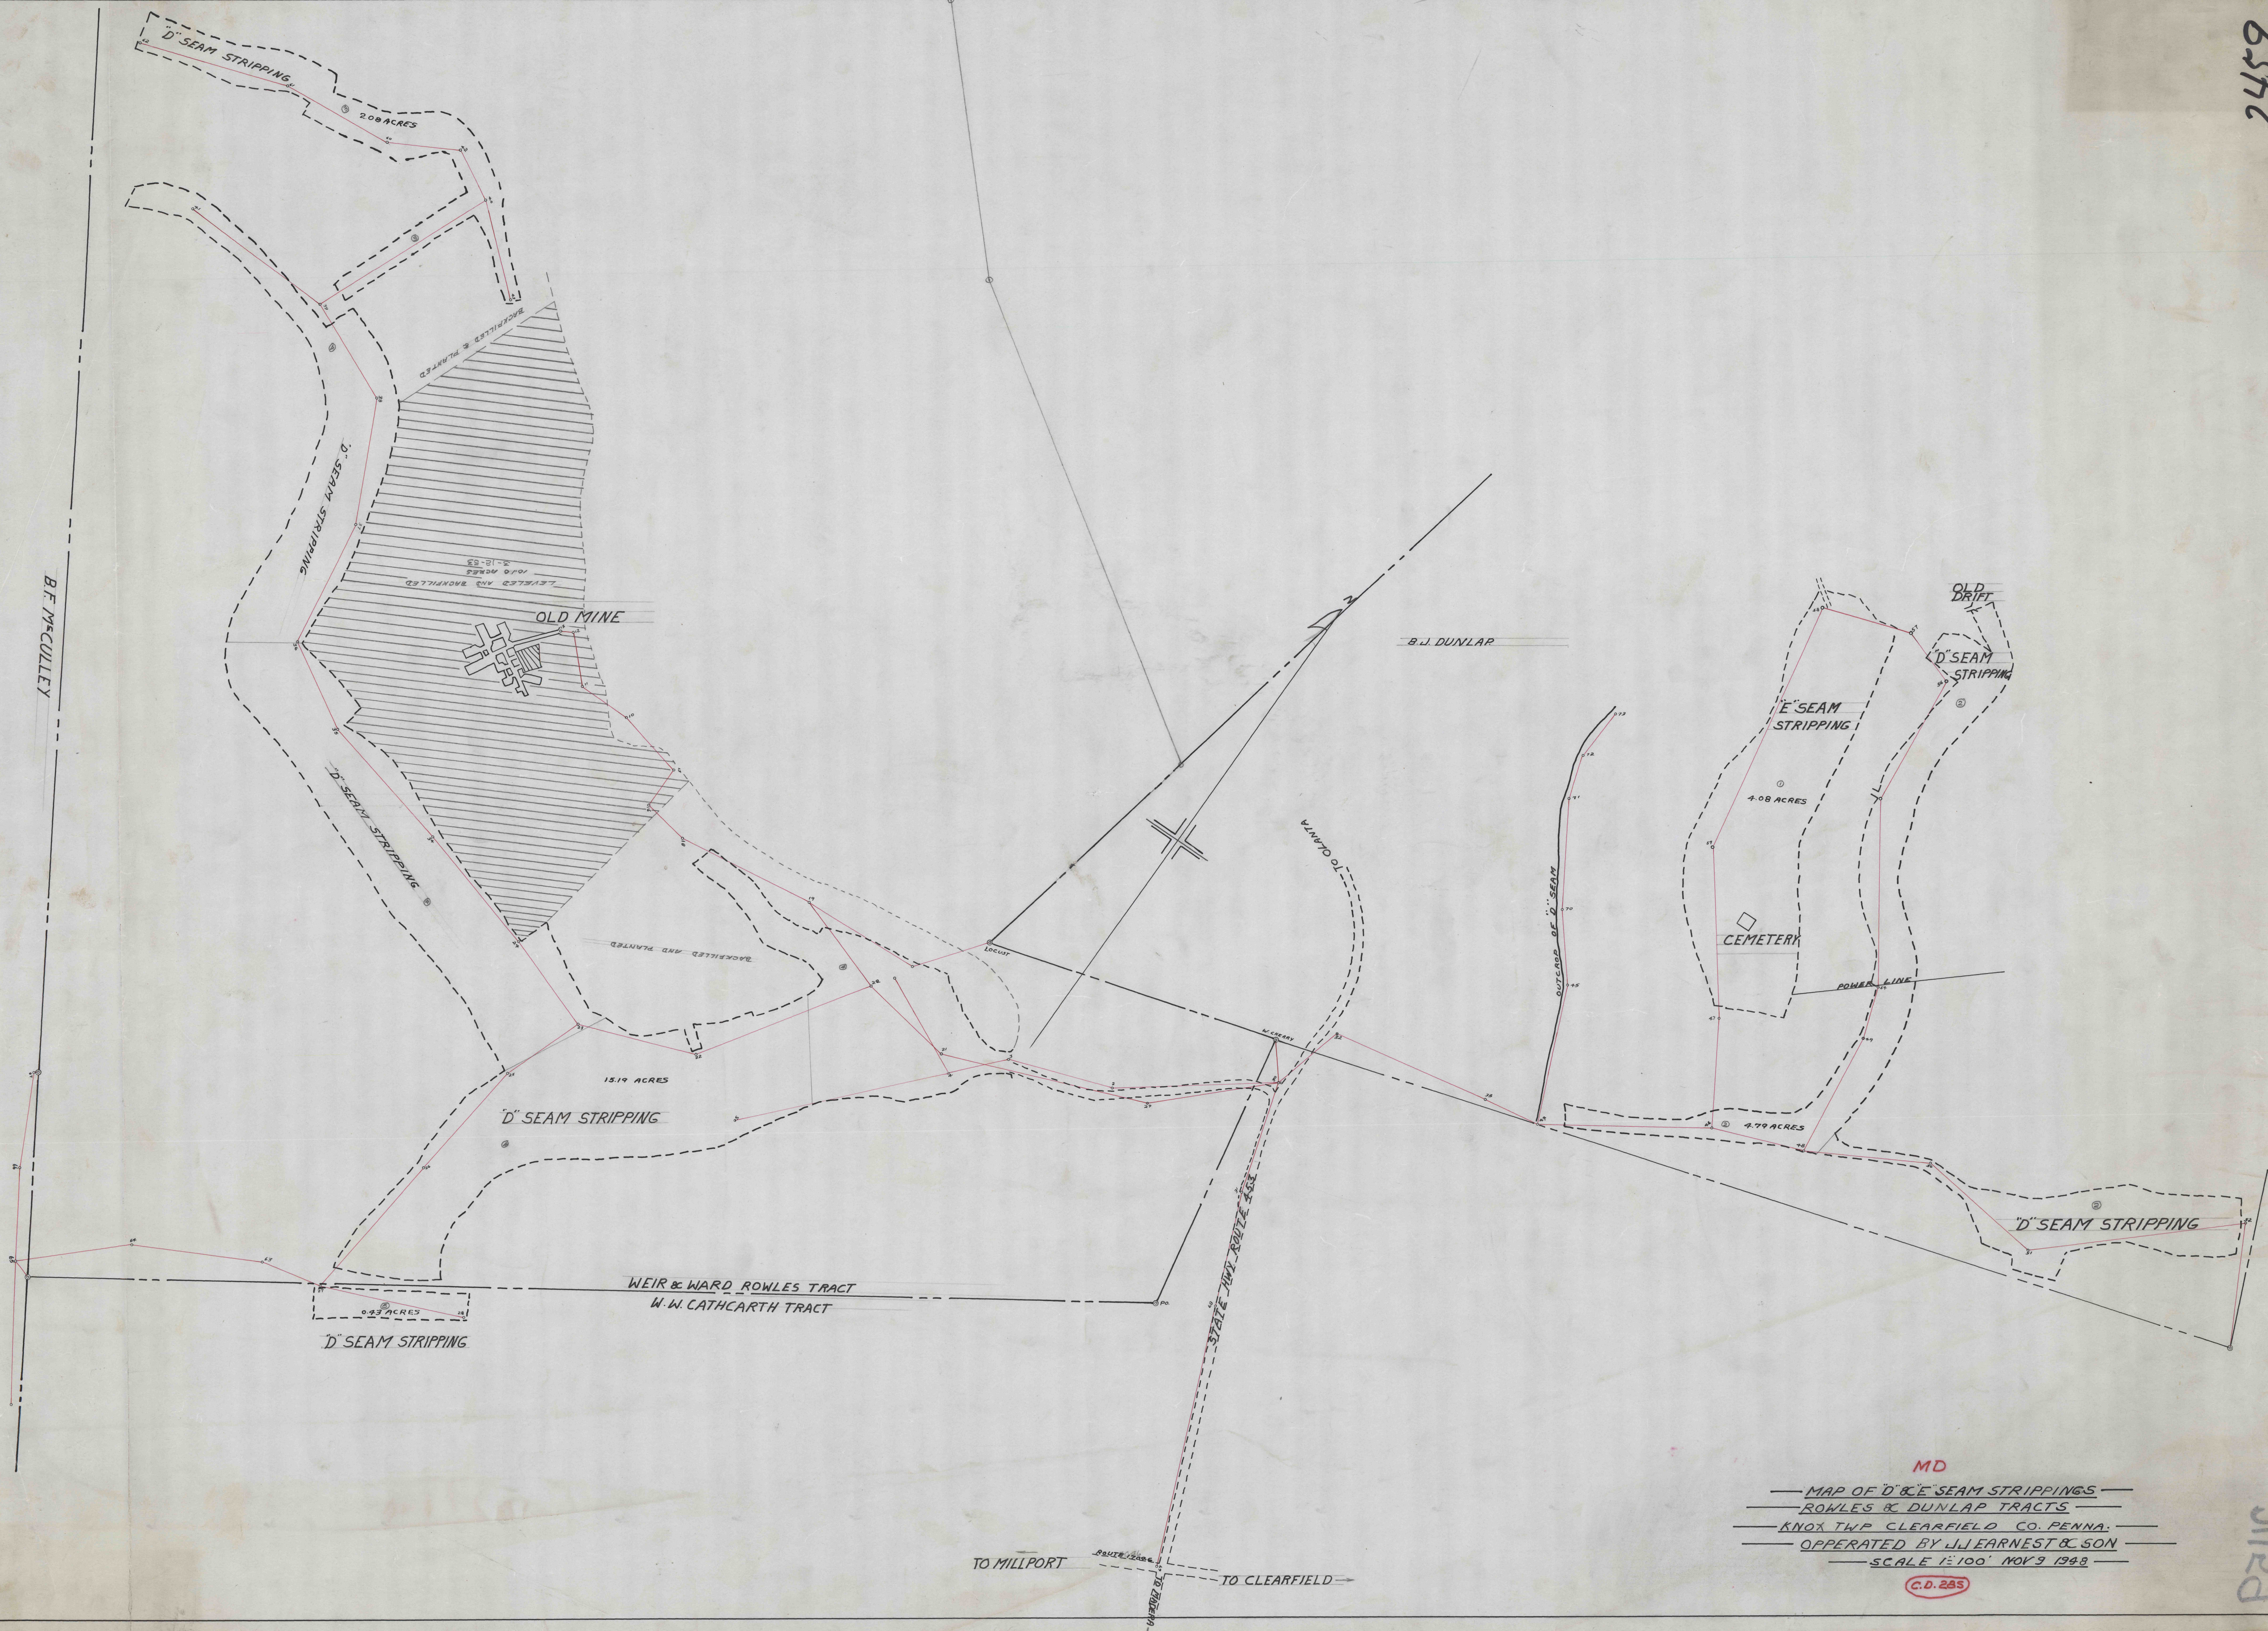

MD  
 — MAP OF D & E SEAM STRIPPINGS —  
 — ROWLES & DUNLAP TRACTS —  
 — KNOX TWP CLEARFIELD CO. PENNA. —  
 — OPERATED BY J.J. EARNEST & SON —  
 — SCALE 1" = 100' NOV 9 1948 —  
 (C.D. 285)

P246