


1745

KITTANING COAL Co.

Nancy LeCorre
27A.

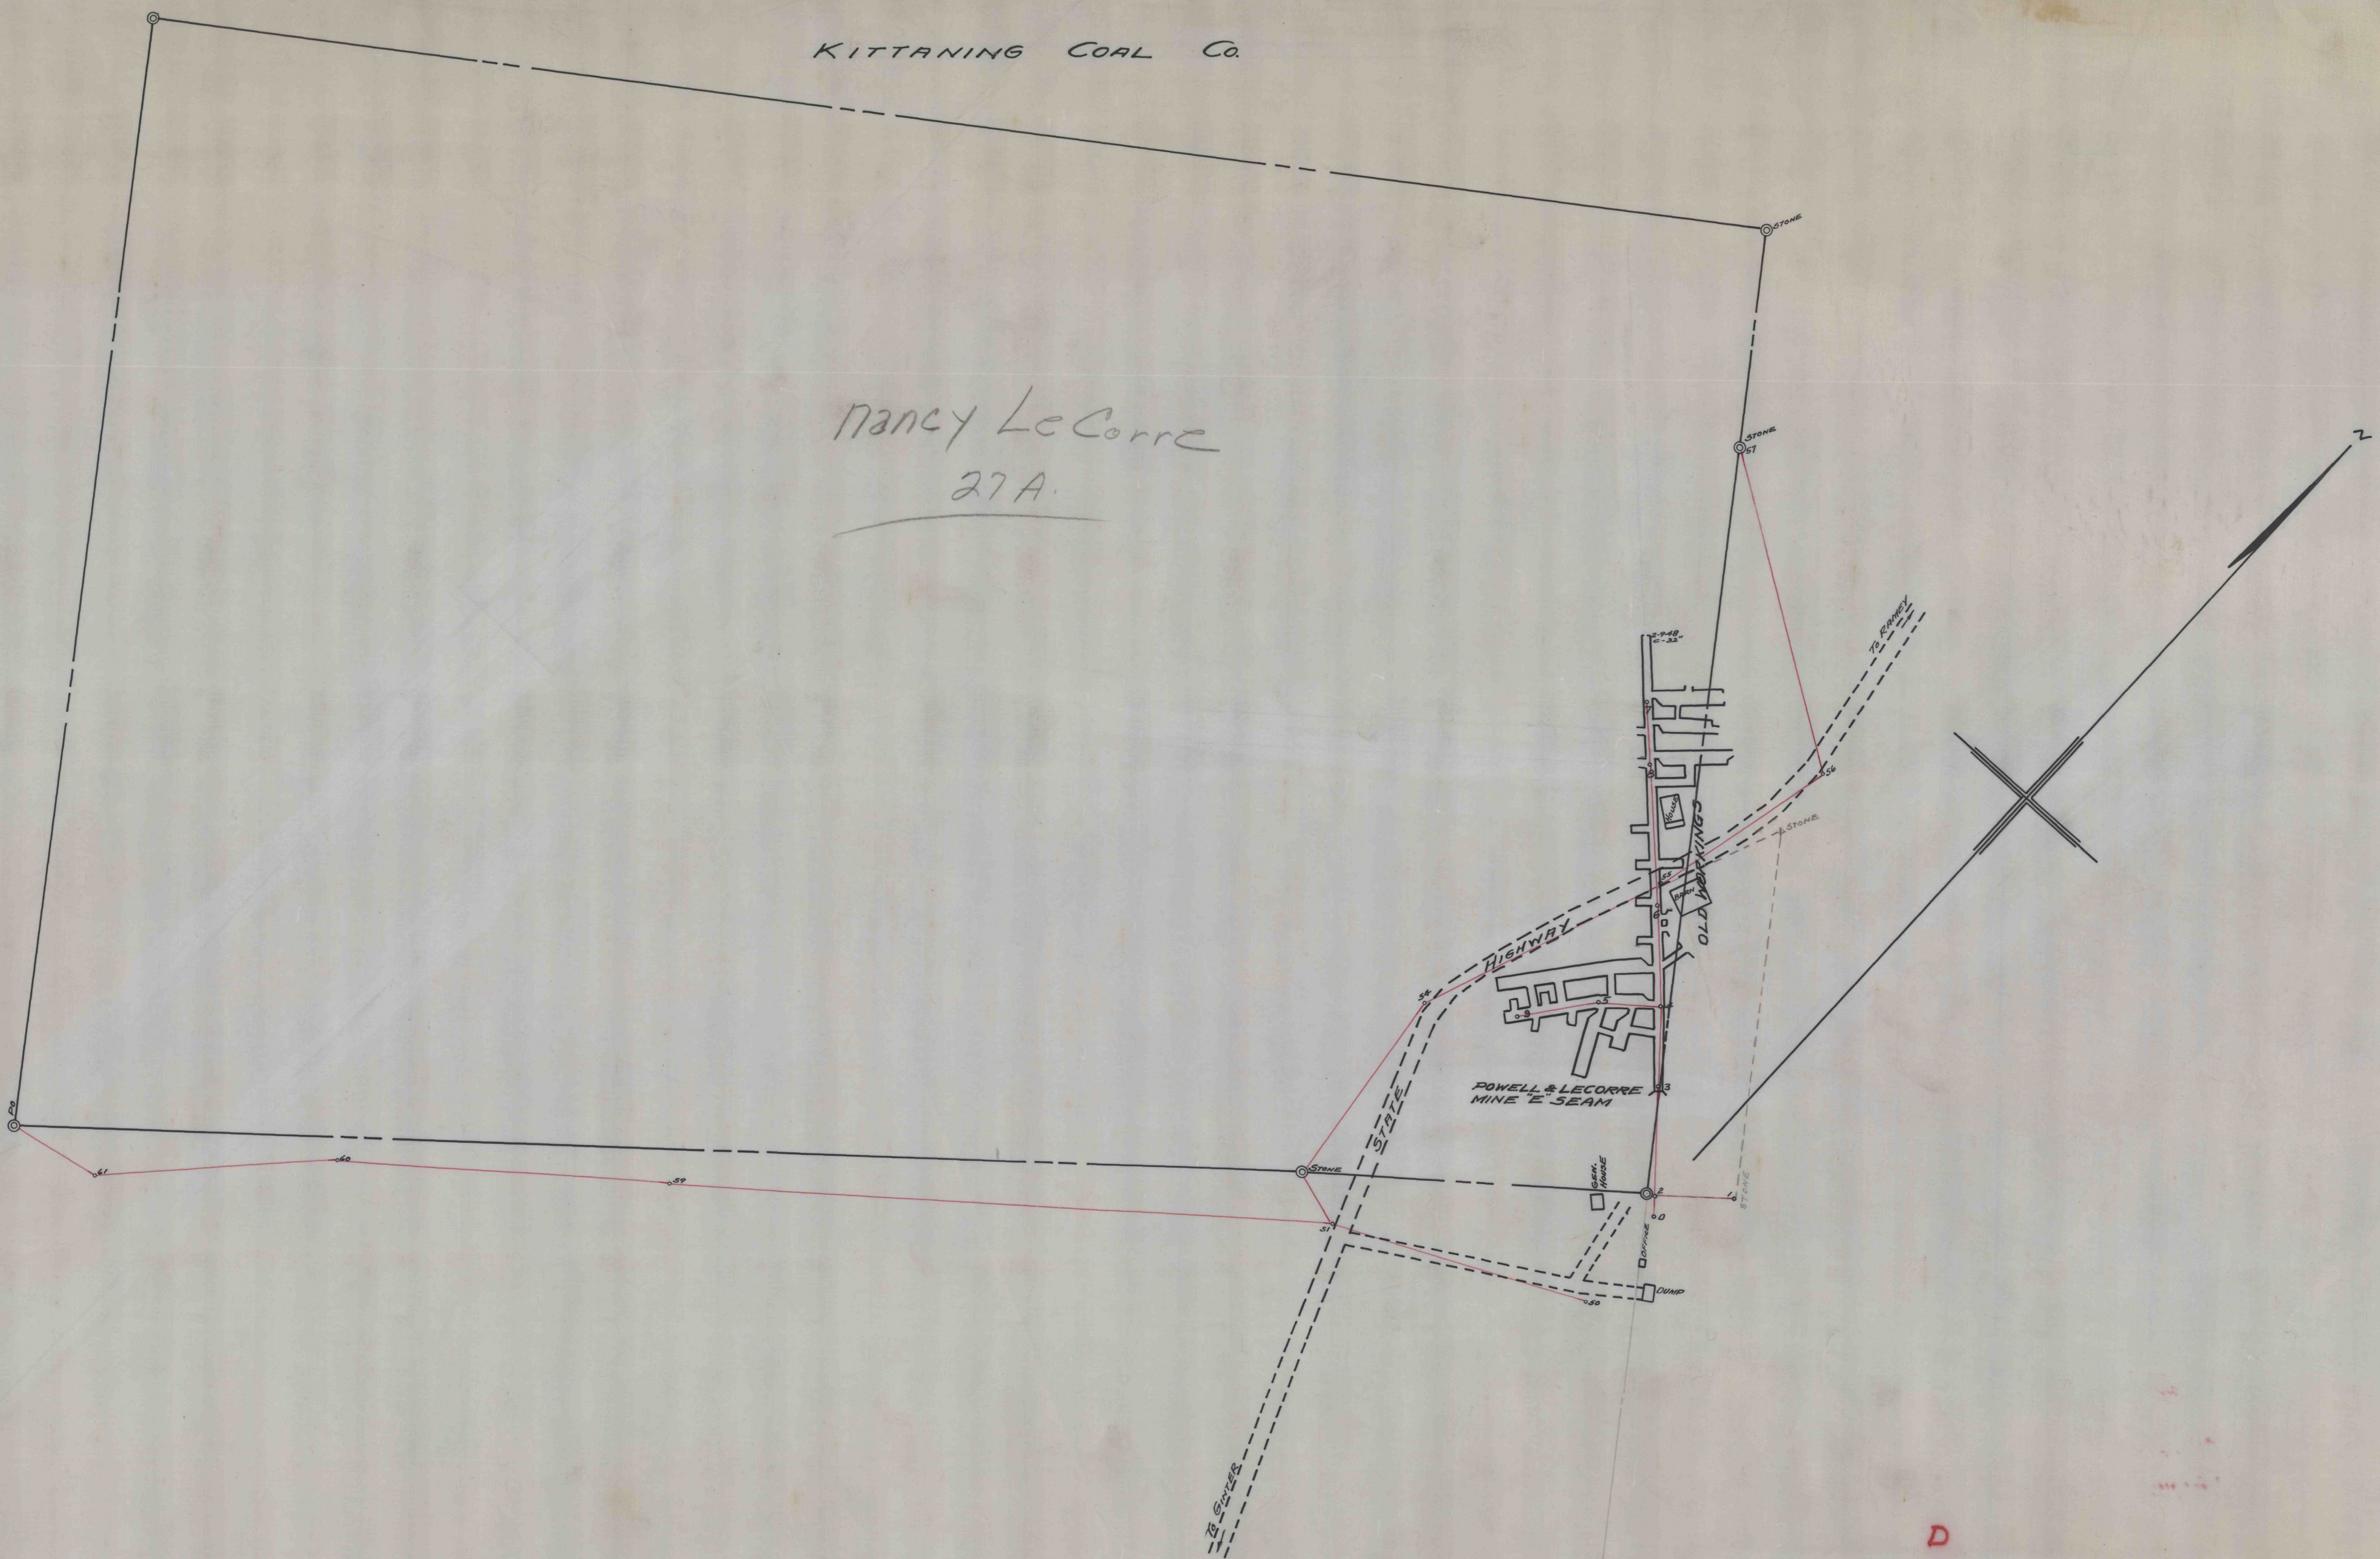

D

MAP OF
POWELL AND LECORRE MINE
OPERATED BY D. POWELL & LECORRE BROS.
GULICH TWP. CLEARFIELD COUNTY PA.
SCALE 1"=100' JULY 2, 1948

BERNARD LUCAS
 THOS. F. MORGAN ENGRS (C.D. 283)

2471