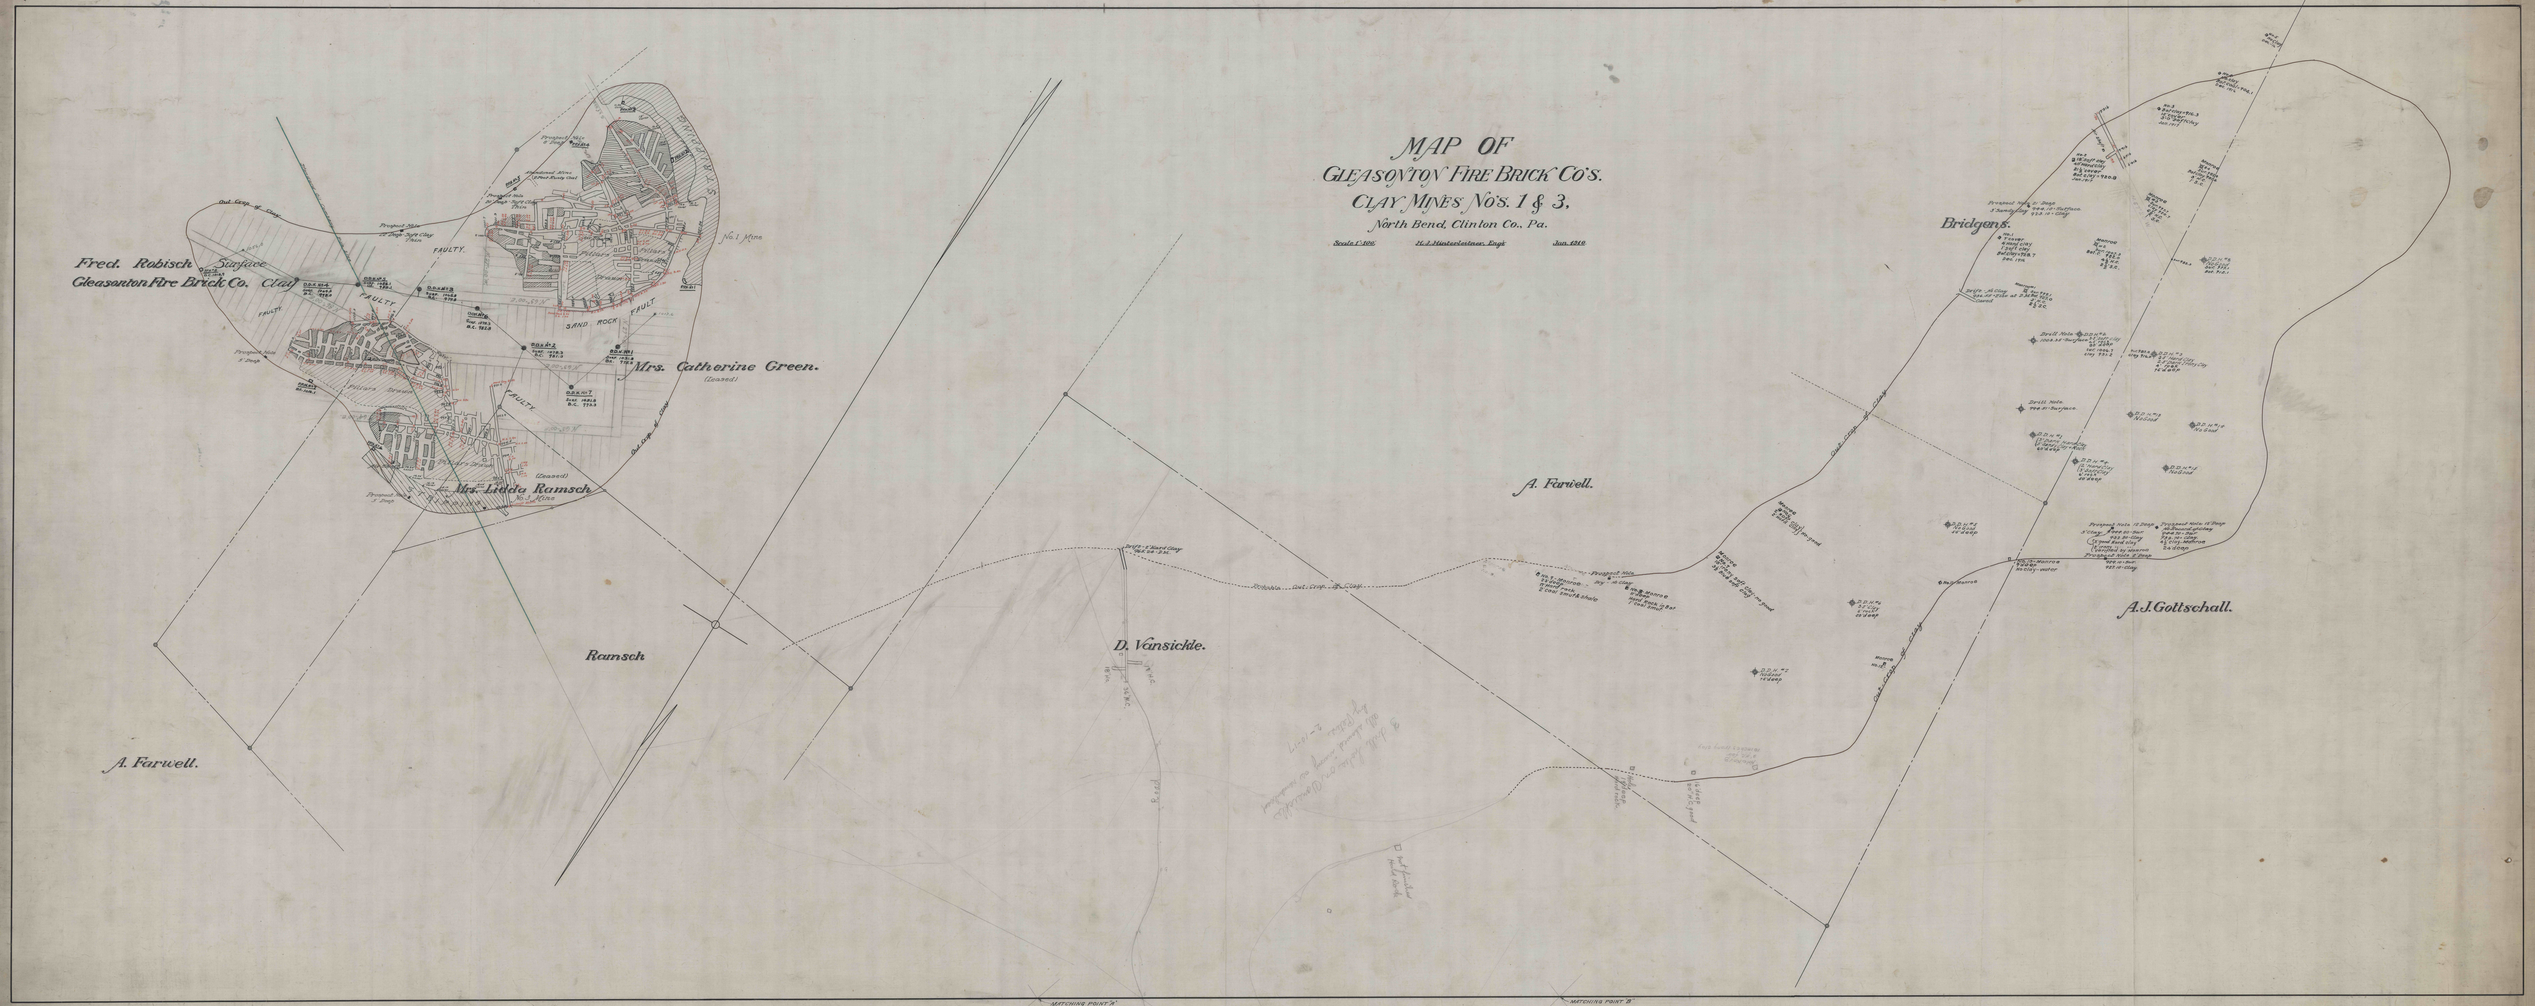
MAP OF
GLEASONTON FIRE BRICK CO'S.
CLAY MINES NO'S. 1 & 3.
North Bend, Clinton Co., Pa.
Scale 1"=100'
H. J. Hinterleitner, Engr.
Jan. 1910.
Fred. Robisch Surface
Gleasonton Fire Brick Co. Clay
Mrs. Catherine Green.
(Leased)
Mrs. Lidda Ramsch
(Leased)
No. 1 Mine
No. 3 Mine
FAULTY
SAND ROCK FAULT
Ramsch
A. Farwell.
D. Vansickle.
A. Farwell.
Bridgens.
A. J. Gottschall.
MATCHING POINT "A"
MATCHING POINT "B"