


1052

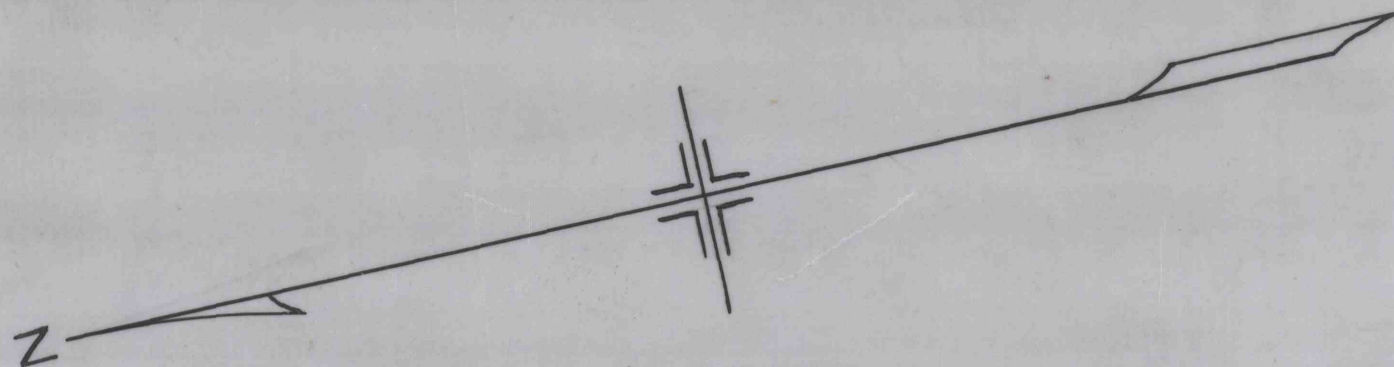

D

— MAP OF —
 — PART OF BOND HILL NO. 1 MINE —
 — OPERATED BY BOND HILL COAL CO. —
 — RUSH TOWNSHIP CENTRE CO. PA. —
 — SCALE 1"=100' — NOV. 14, 1947. —

C.D. 284

BARN

HOUSE


STATE HIGHWAY ROUTE 350

RES. LINE 7
J.P. HAGE HDG.

RESERVATION

Reservation Line 7

BATCHLER

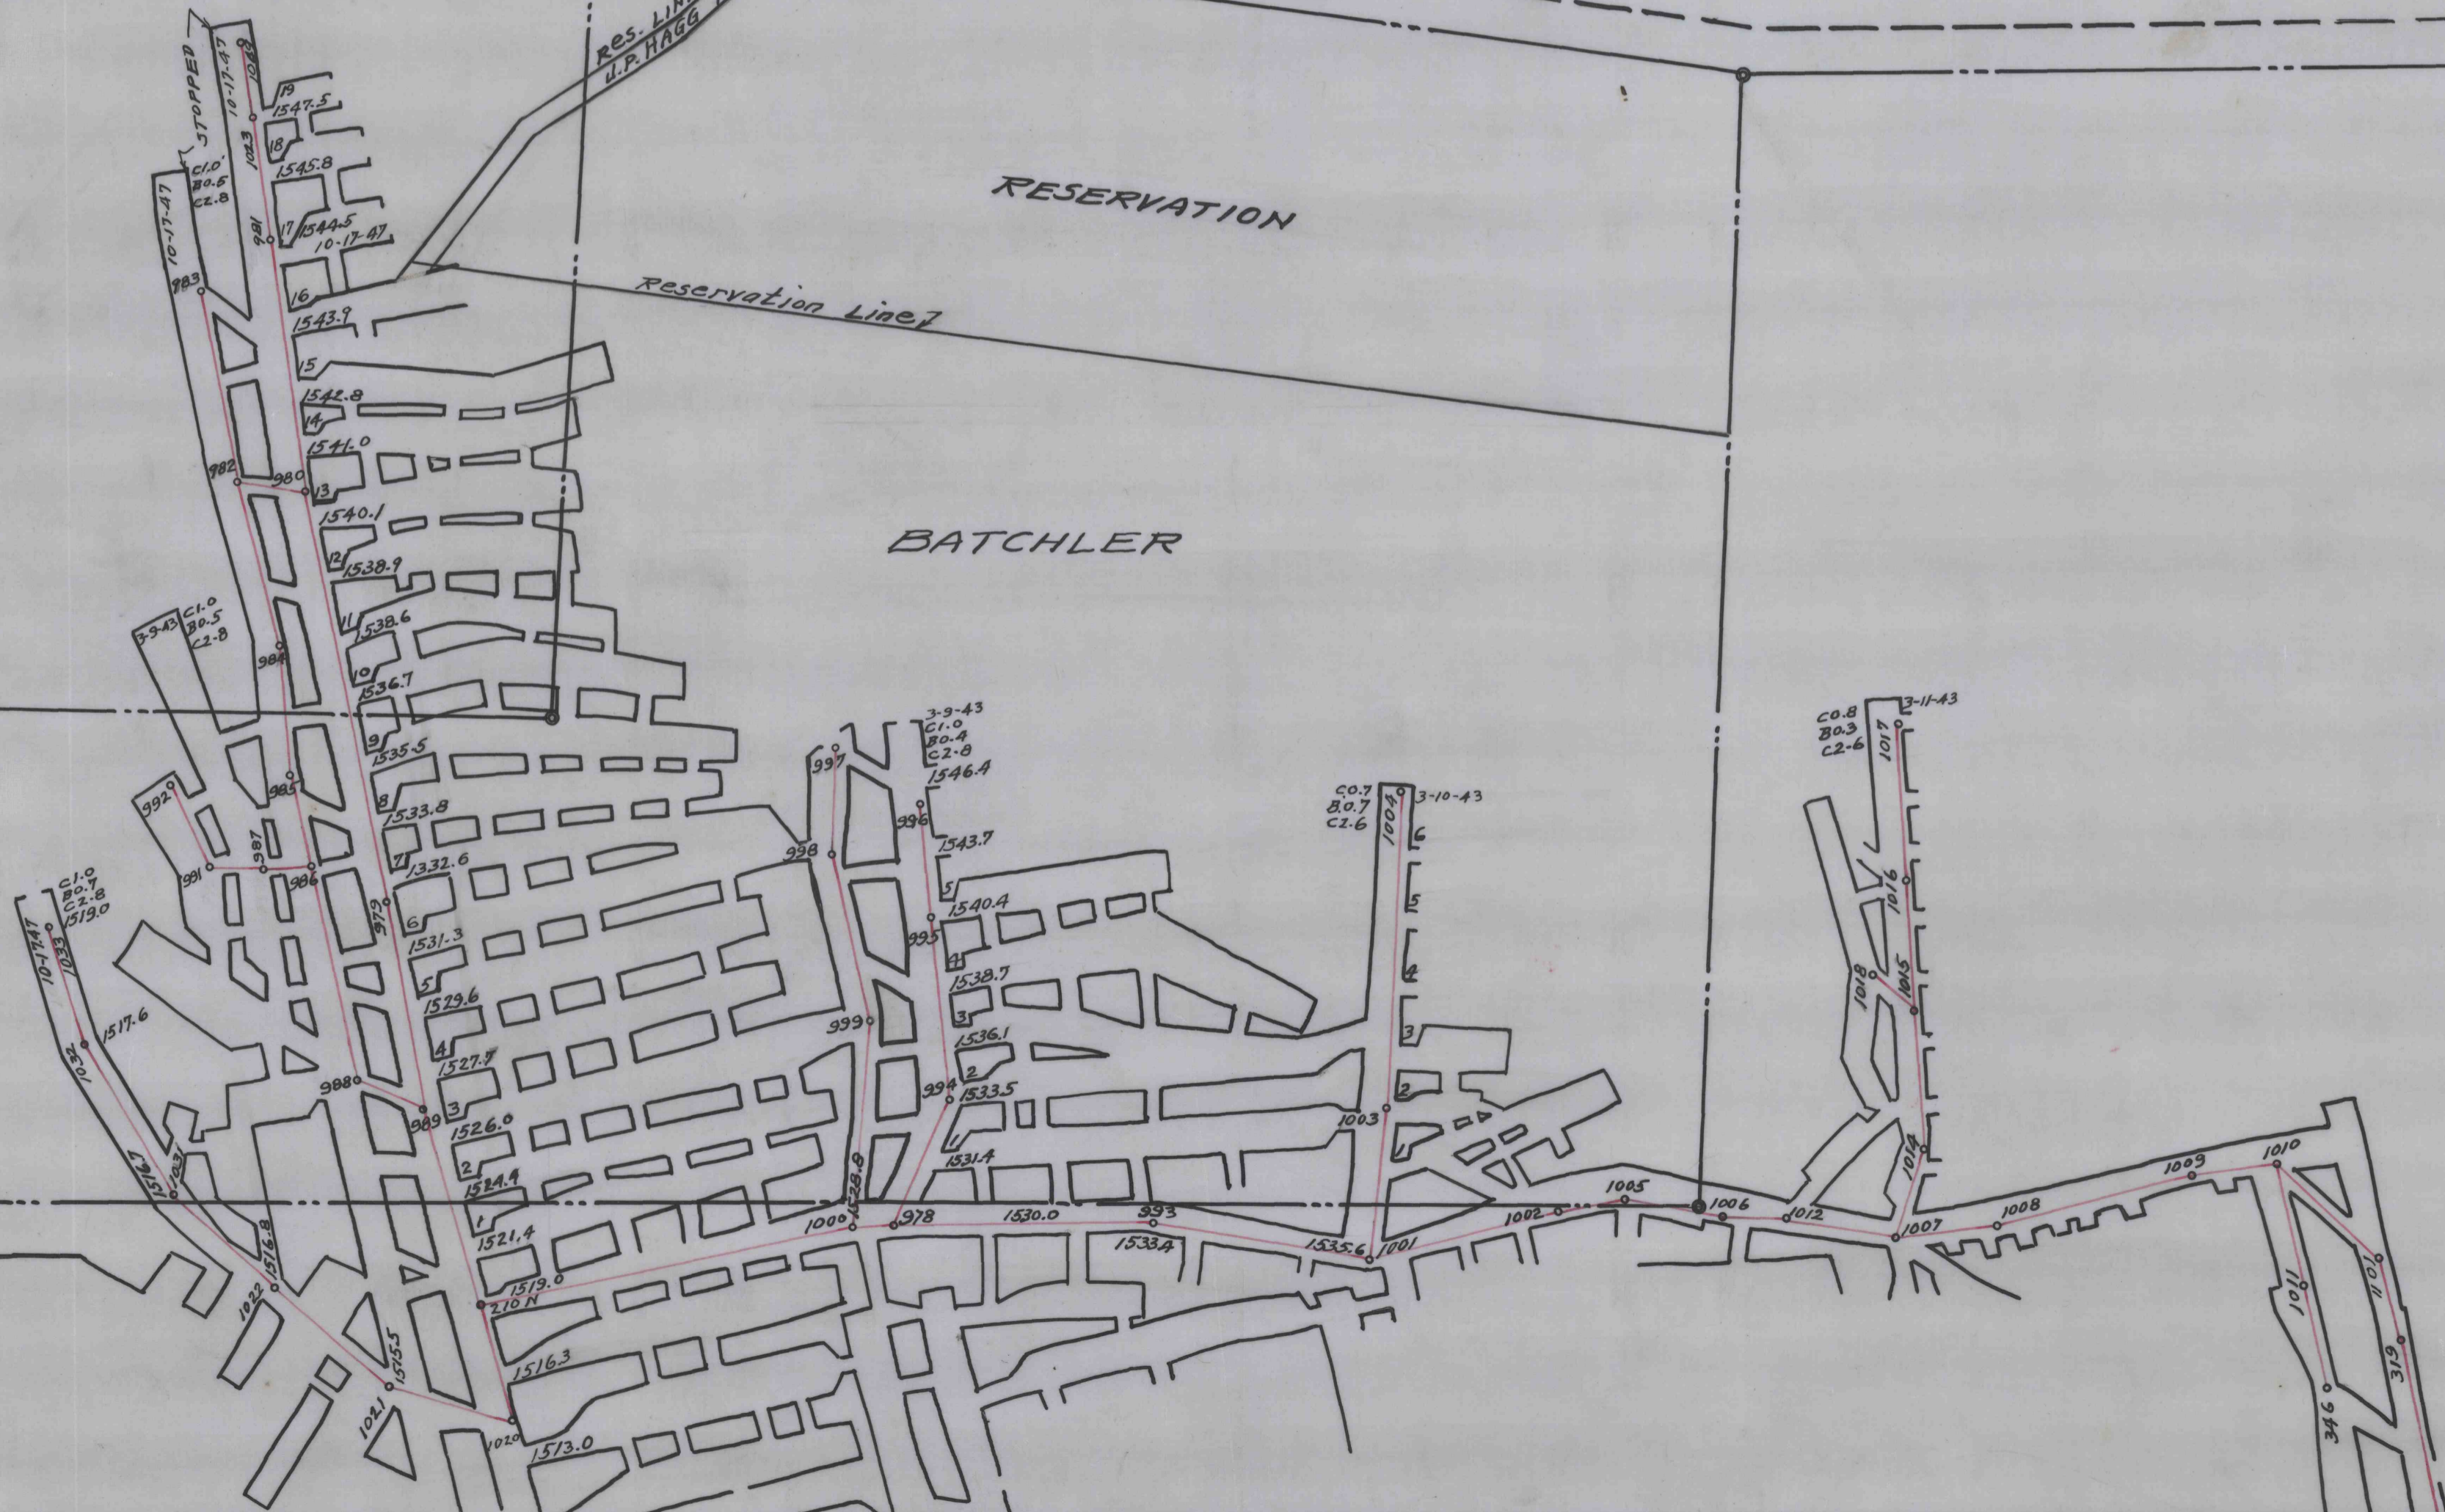

5201