


2507

IVAN & STEPHEN GOULD

5025

WARRANT NO. 4358

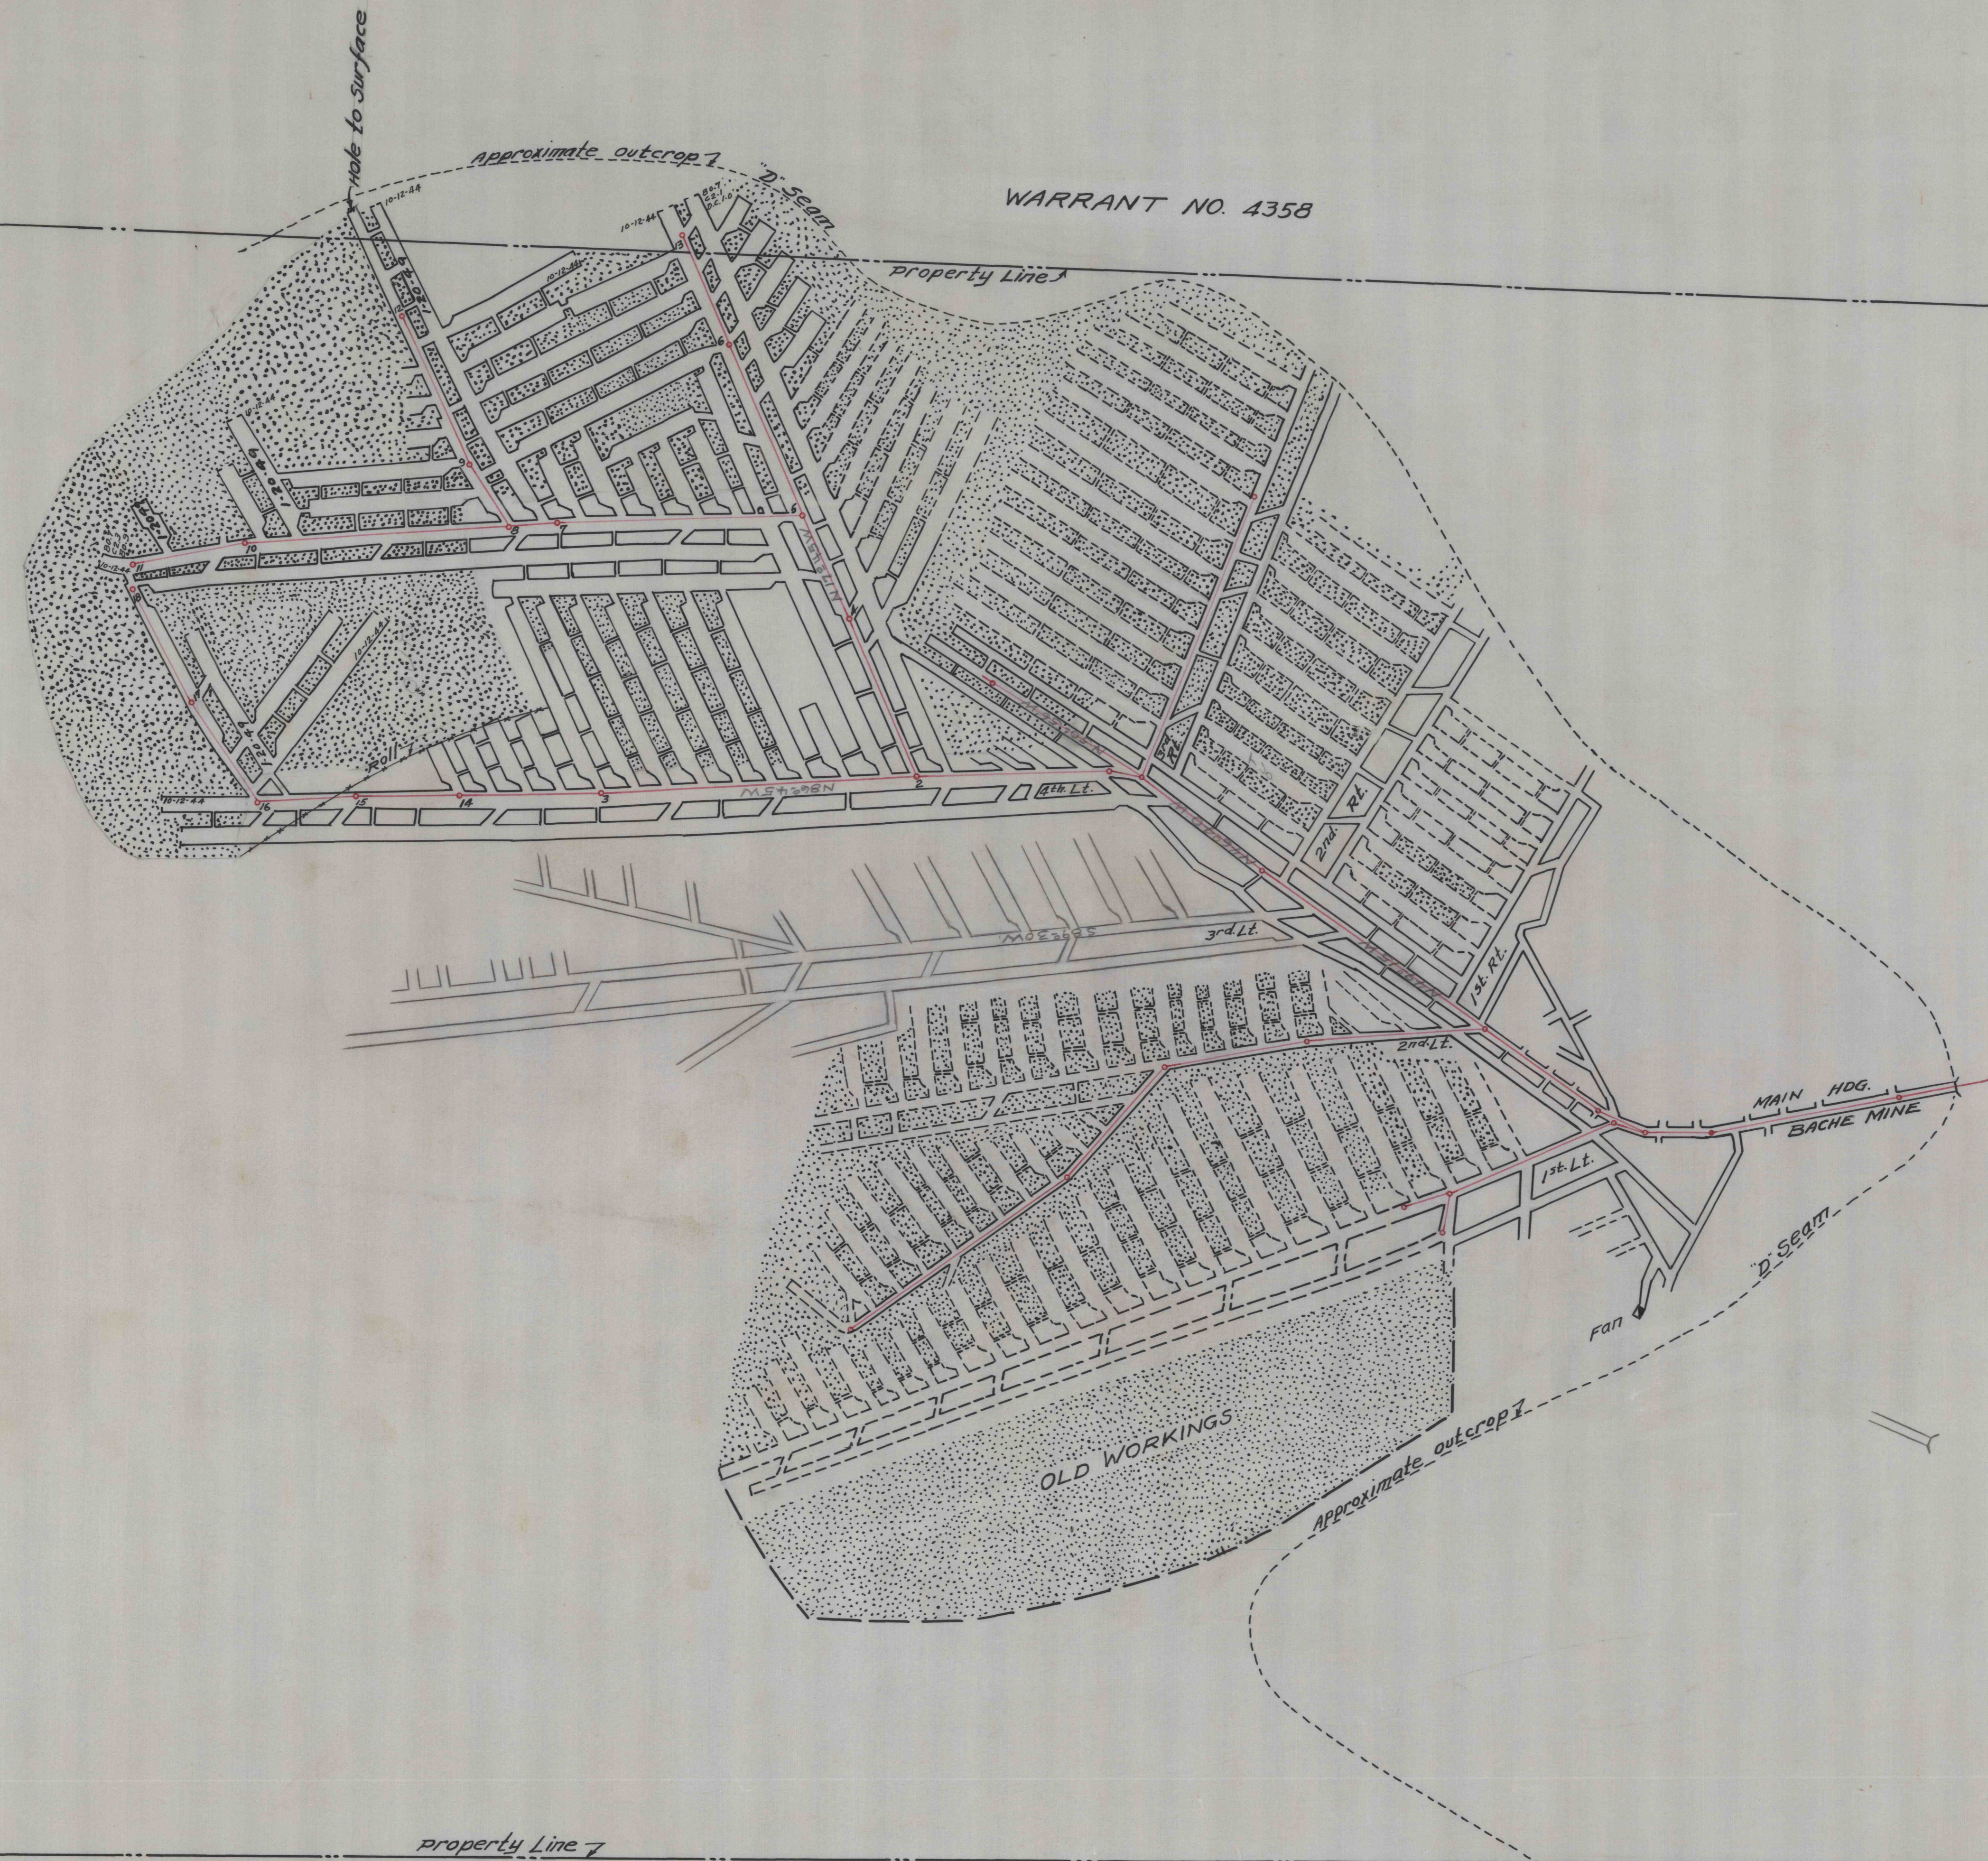

IVAN & STEPHEN GOULD

D  
 — MAP OF BACHE MINE —  
 — PINE TOWNSHIP, LYCOMING CO. PA. —  
 — OPERATED BY O.R. CARSON —  
 — SCALE 1"=100' — NOV. 22, 1944. —

C.D. 207

Bernard Lucas  
Thos. F. Morgan  
Engrs.