

P238

922


J. R. CALDWELL

Scale 1" = 100'

SCHOOL LOT

RESERVATION

ATLEE NORRIS

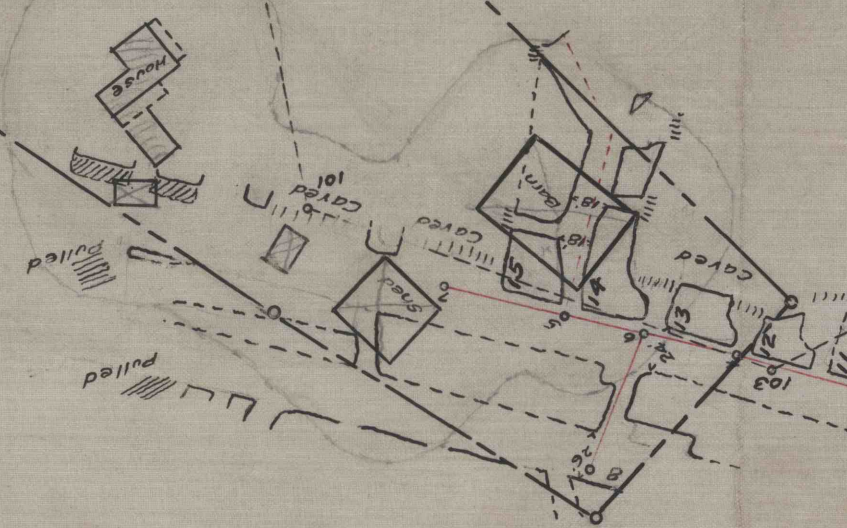

FIRST
RIGHT
HOG

MAIN
HOG

2559