
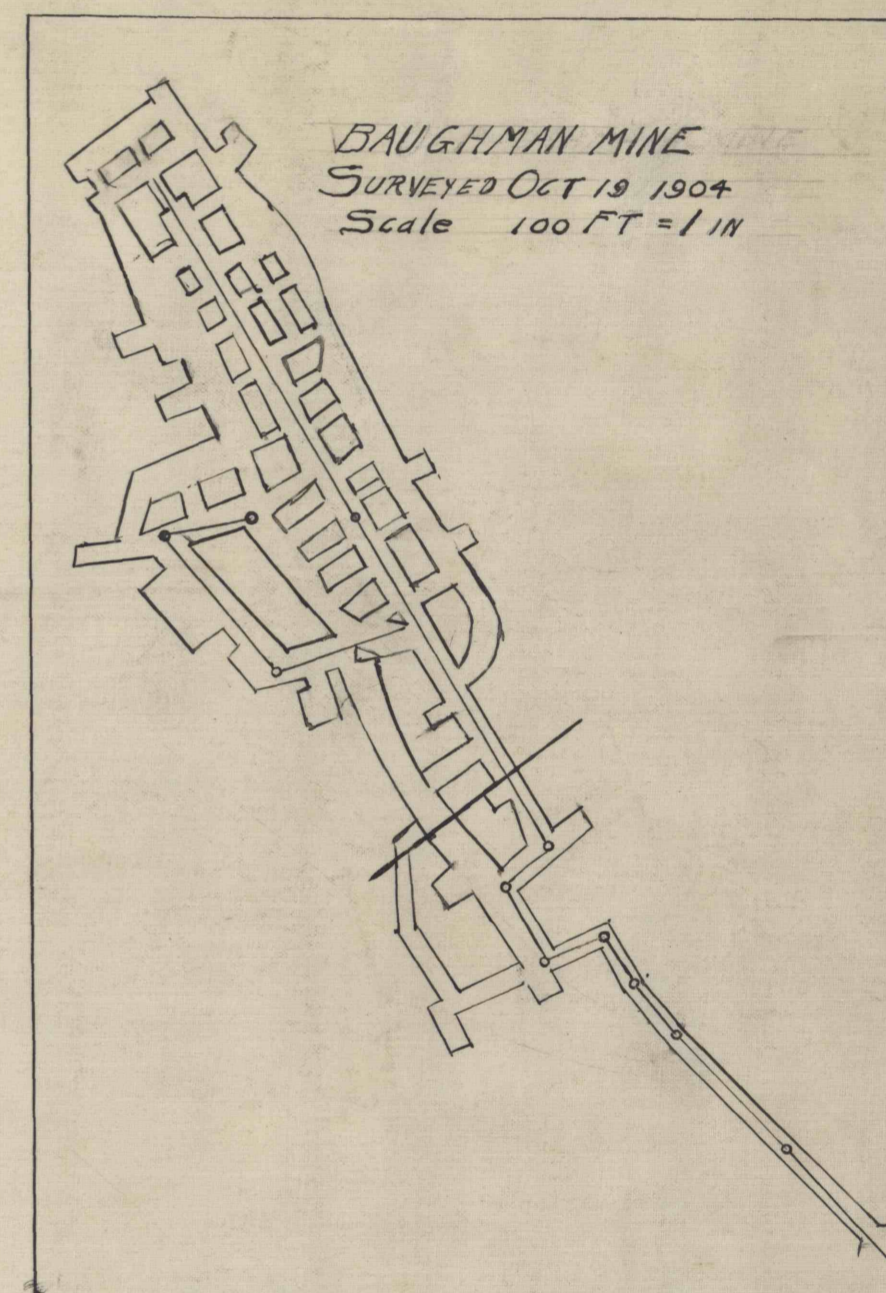


2565

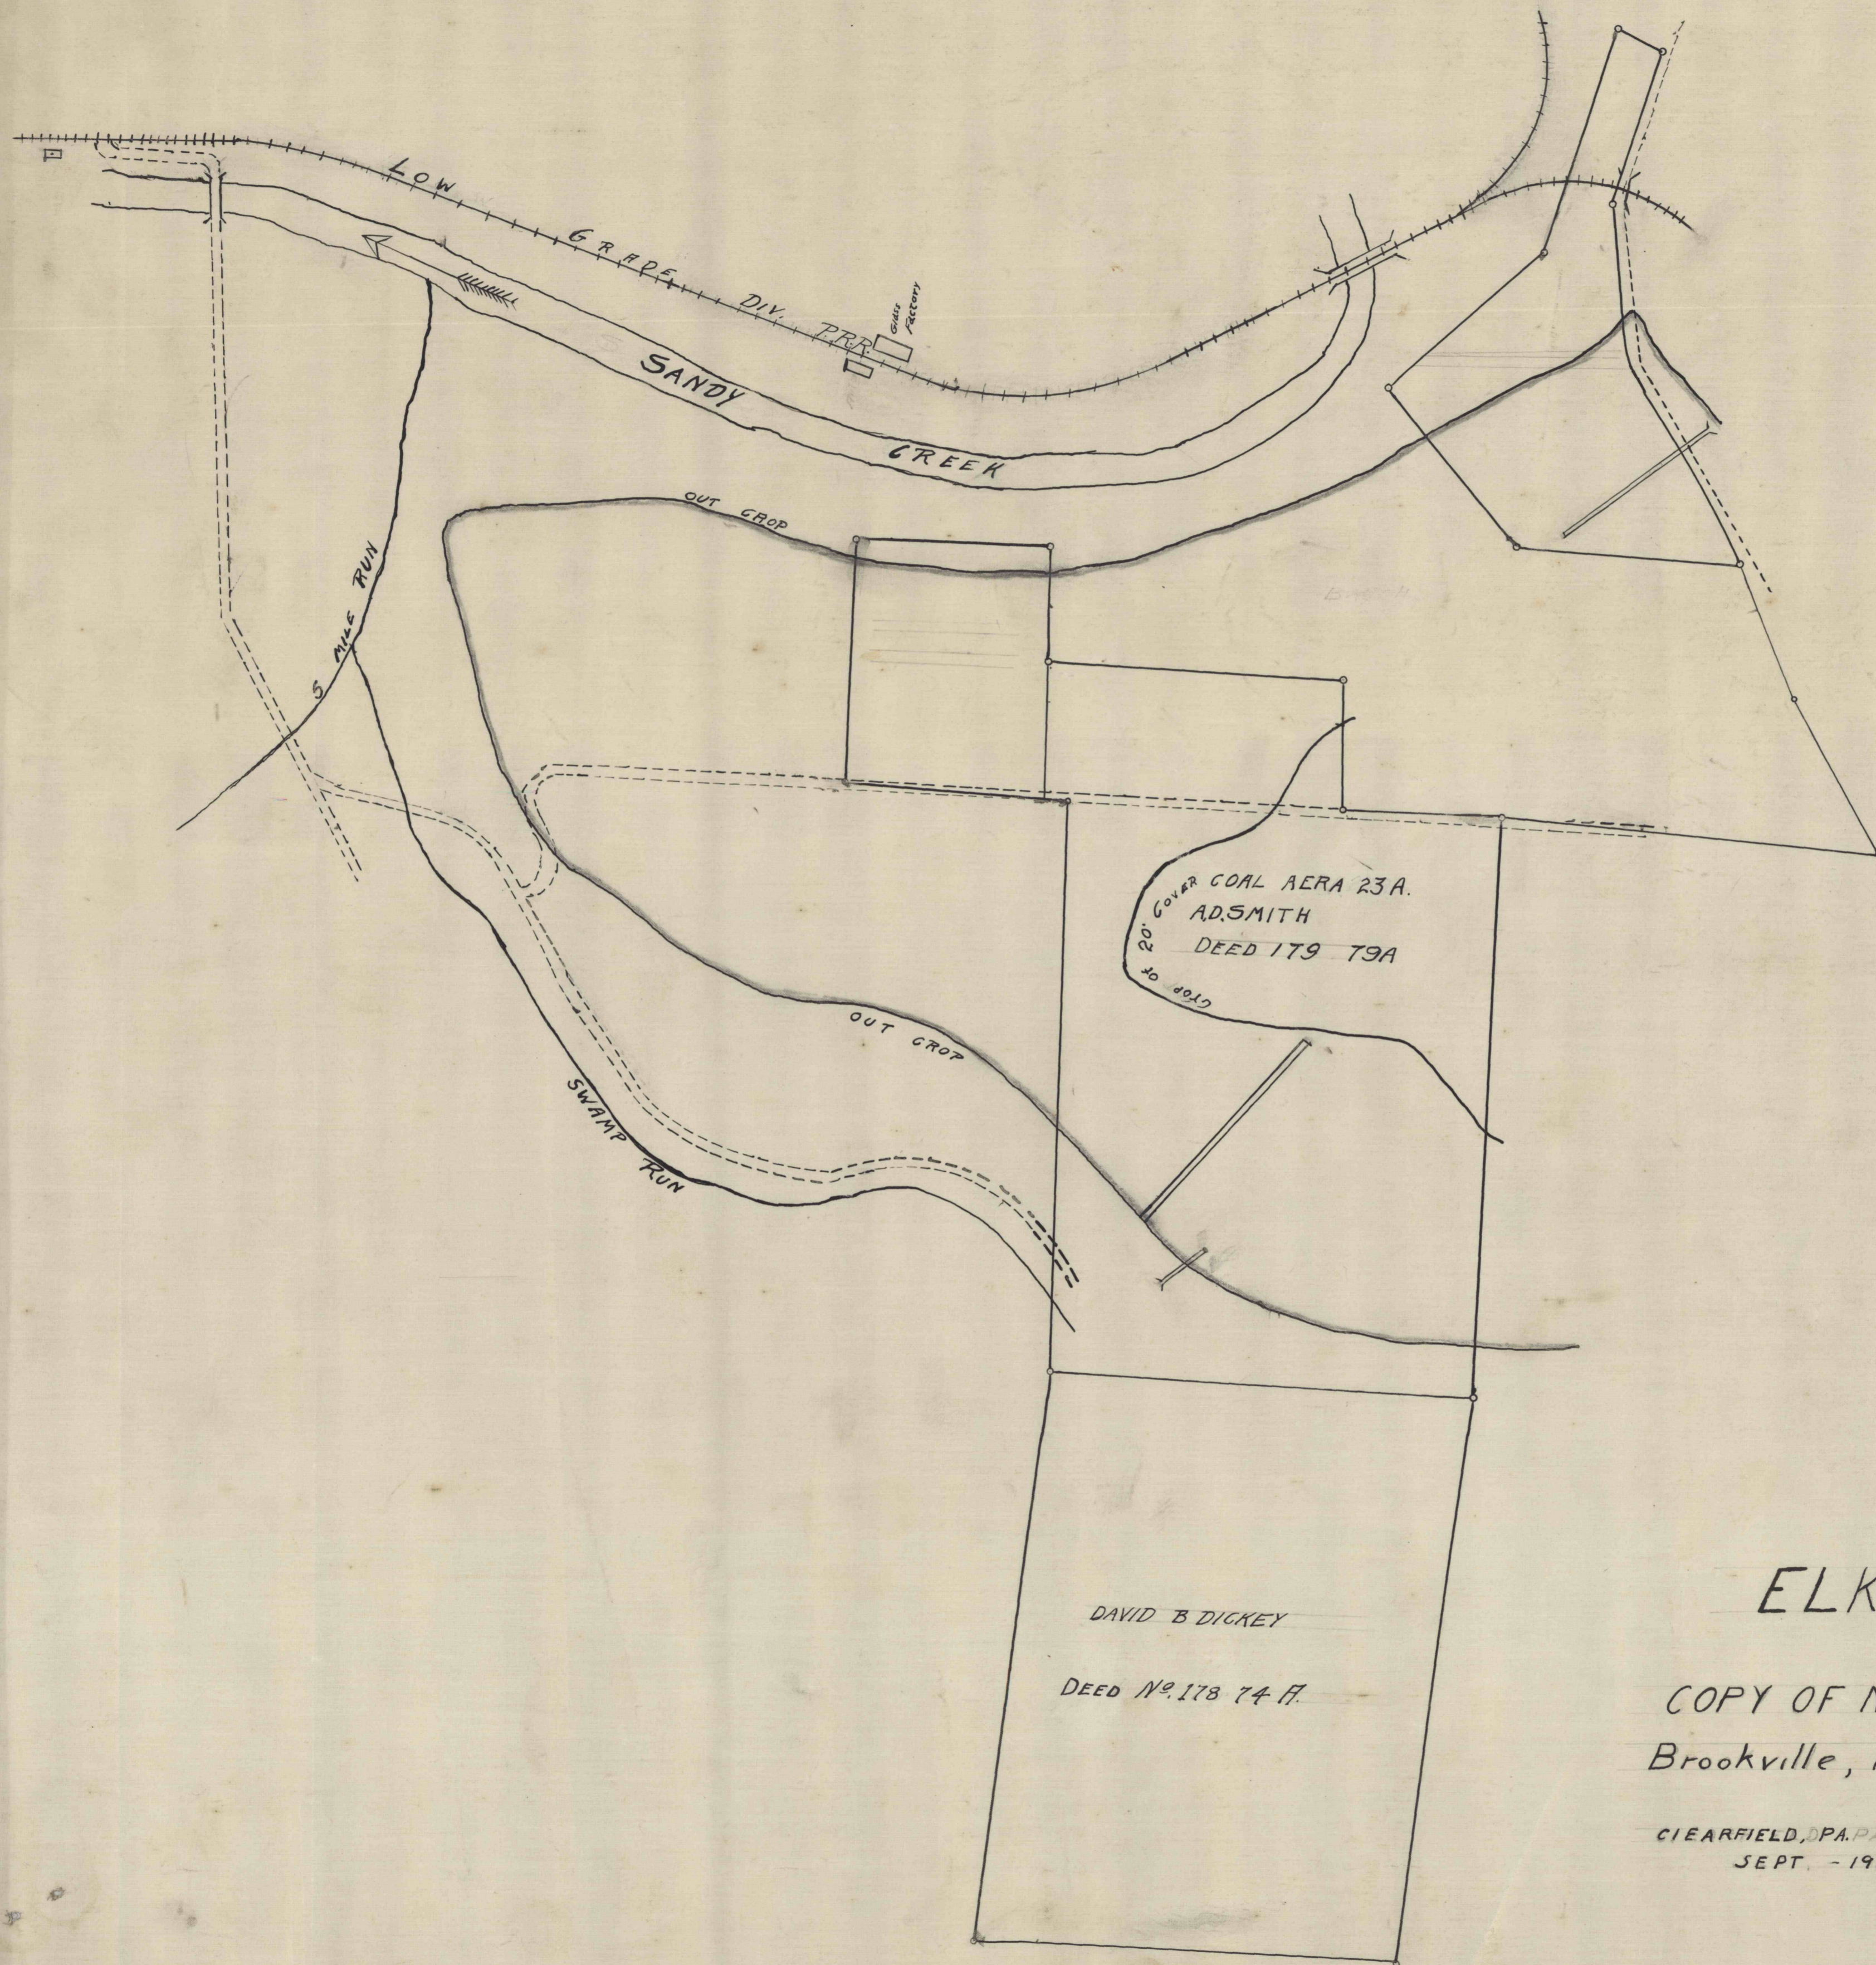

00

# ELK FIRE BRICK CO.

ST. MARYS PA

COPY OF MAP OF FIRE CLAY LANDS NEAR  
Brookville, Pa (896-B) Jefferson Co.

CLEARFIELD, PA. PA.  
SEPT. - 1919

OFFICE OF EW. HESS  
ENGINEER

5202