


170-68
 85-12
 97-42
 1-22
 76-30
 179-41
 26-30
 13-50

25-56
 1-45
 527-37 1/2

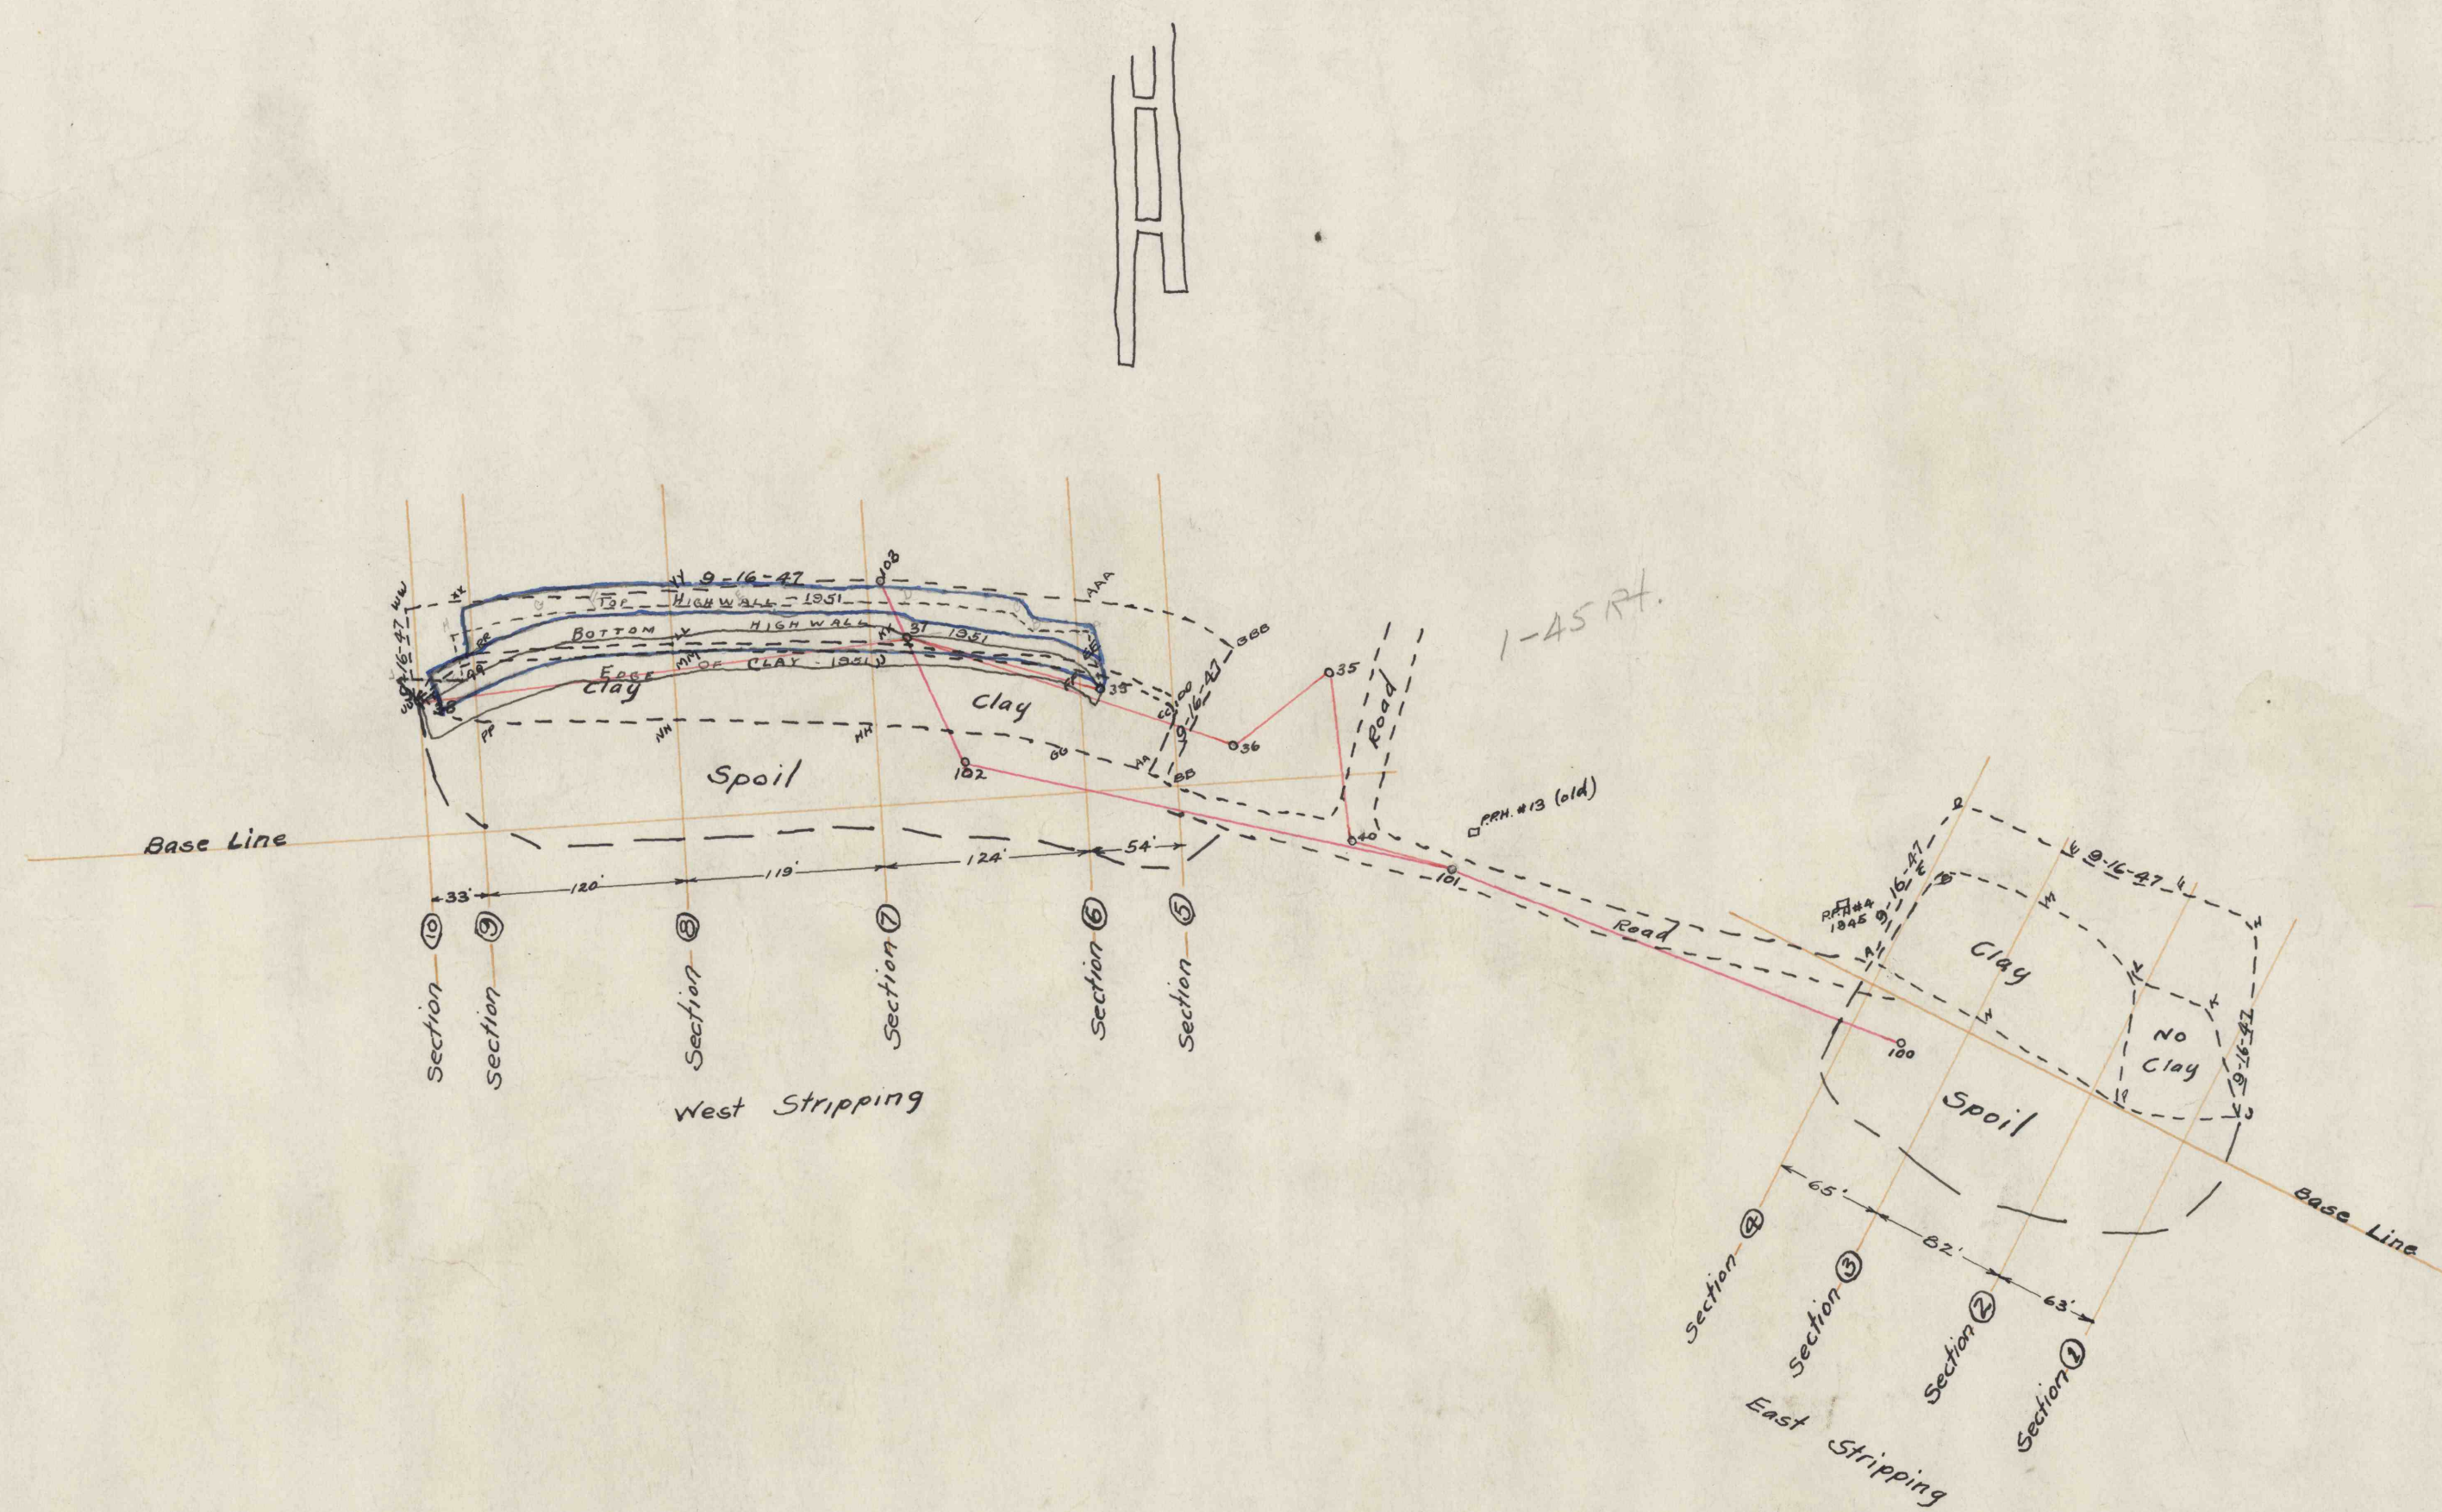

Do Not Use
 NORTH AMERICAN REFRACTORIES CO.
 CLEVELAND, OHIO
 PLAN OF
 WEST BRANCH STRIPPING
 NEAR RENOVO CLINTON CO, PA
 DATE 9-16-47
 SCALE 1"=100'
 DRAWN AEH CHECKED JPH.
 WORKED FROM DWG. NO 26-2-2
 INDEX NO 26-2-10