


2644

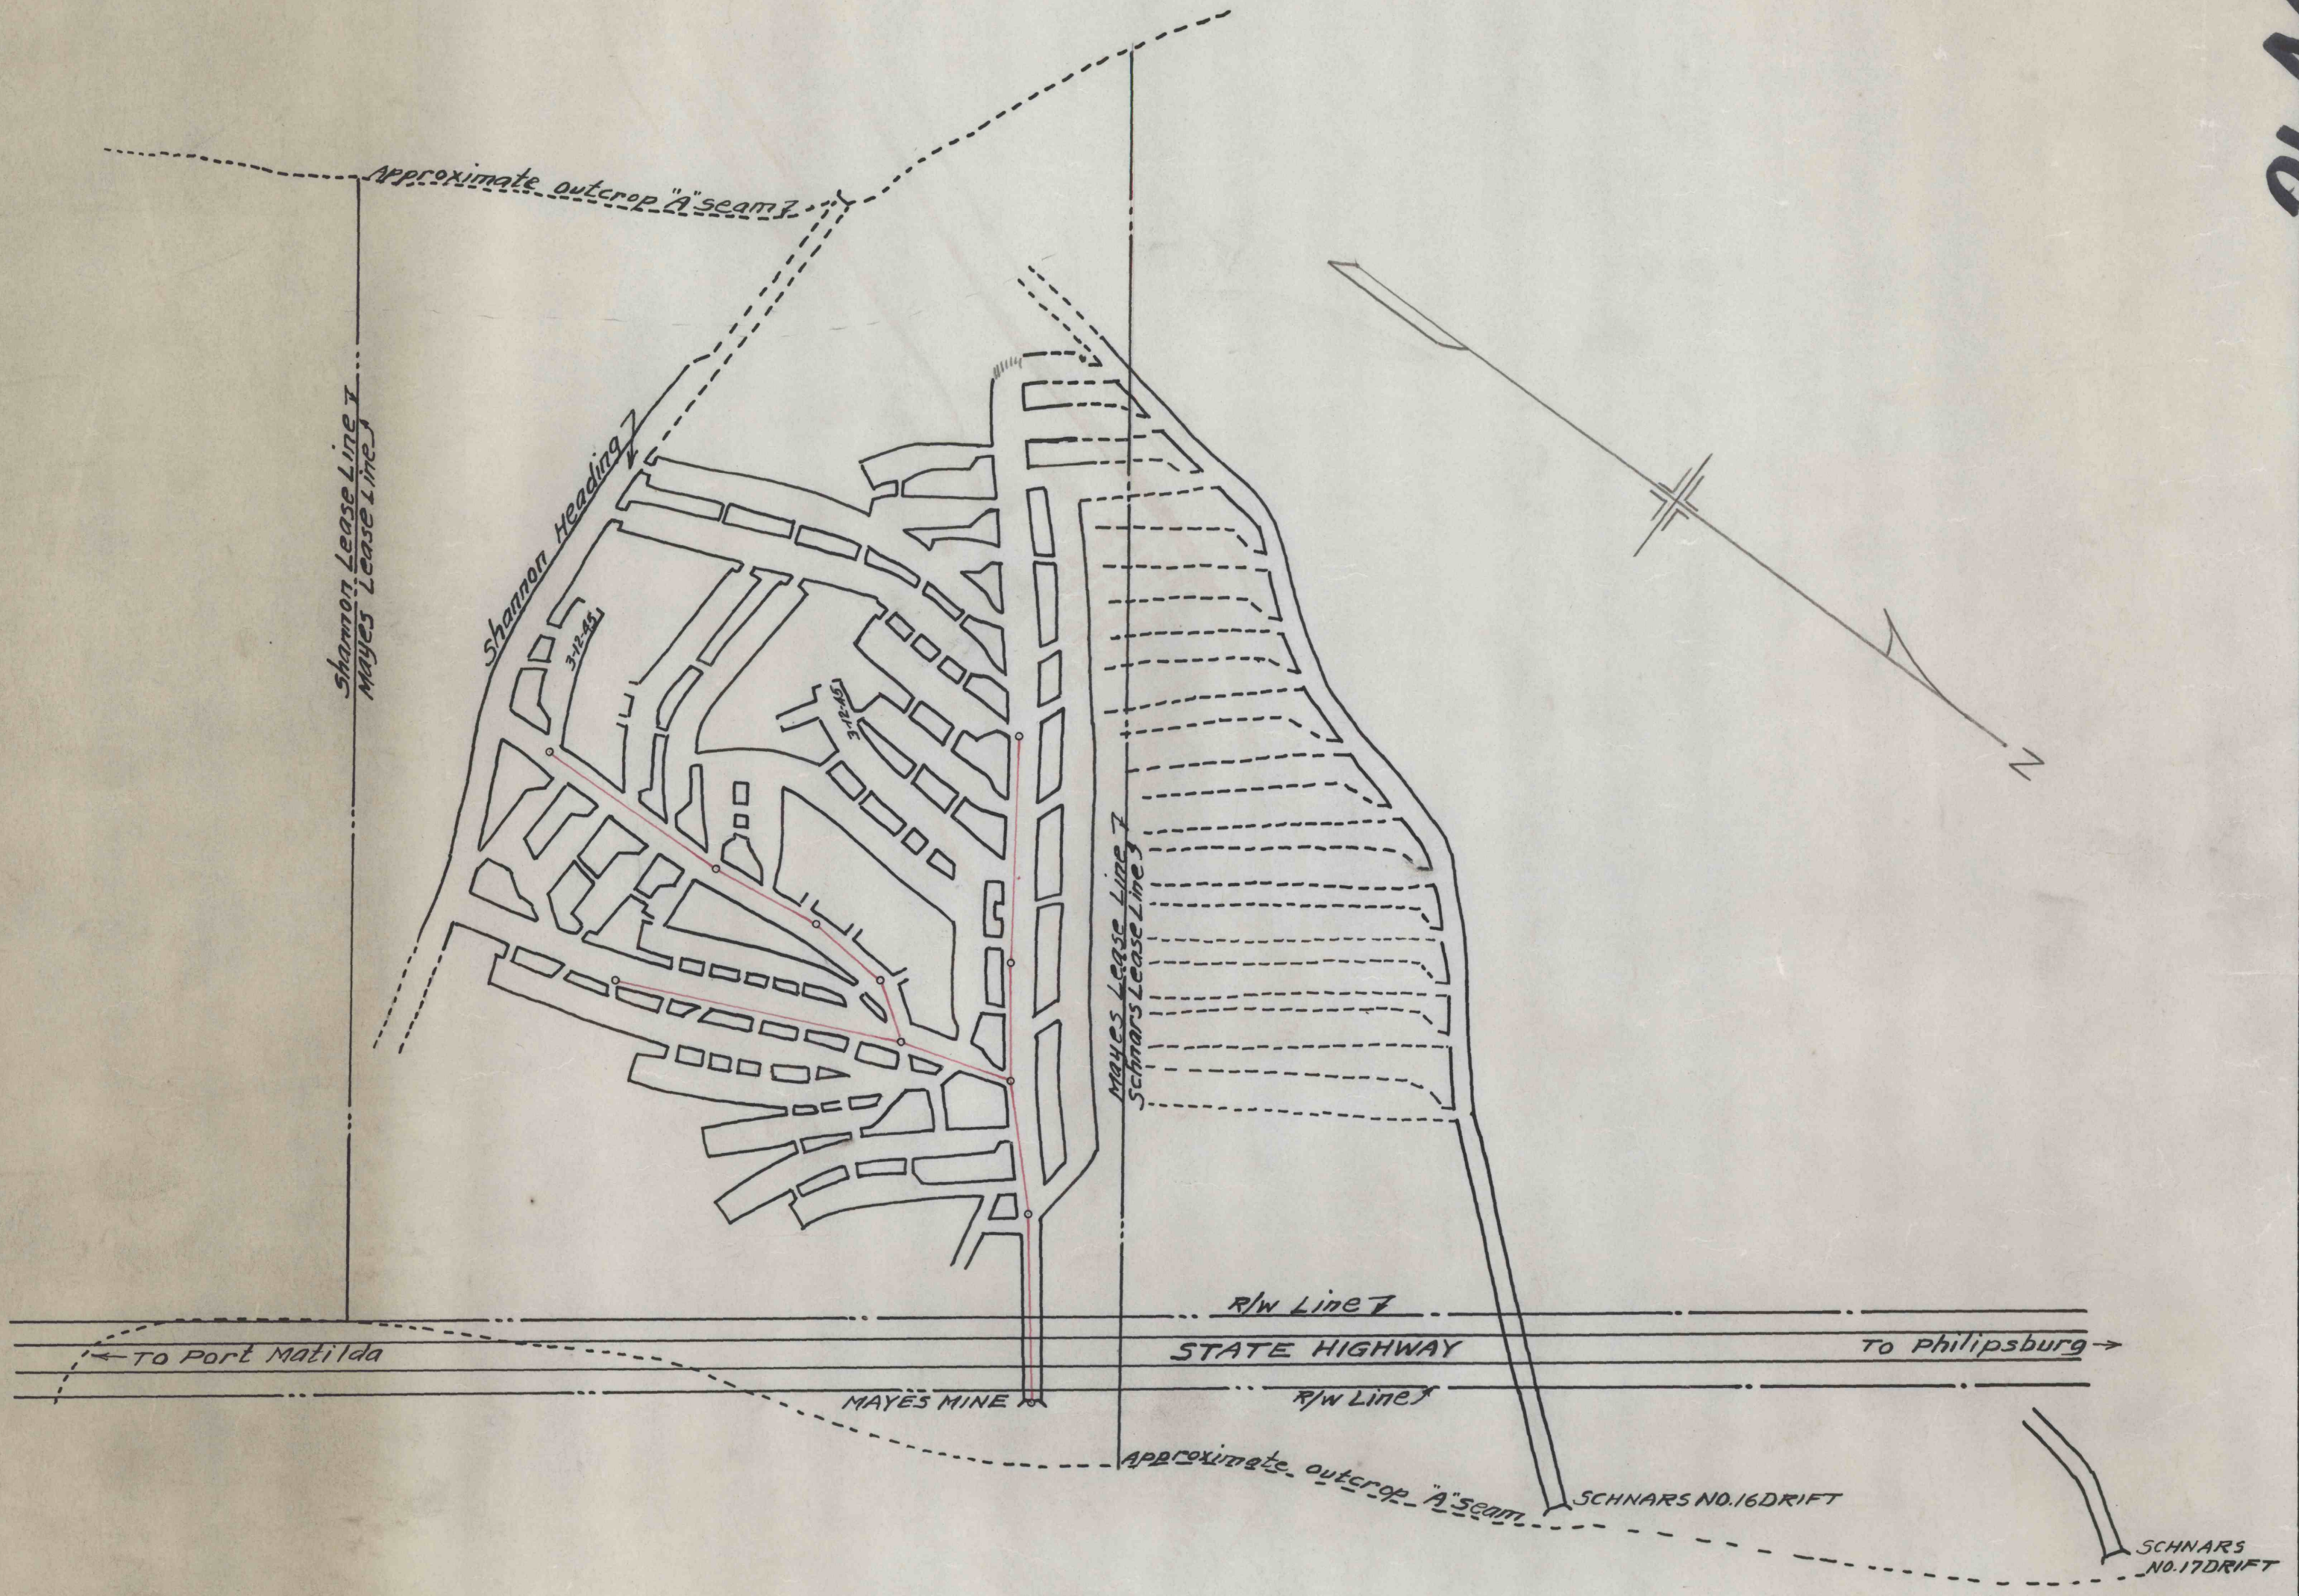

**D**

— MAP OF MAYES MINE —  
 — RUSH TWP. CENTRE CO. PENNA. —  
 — OPERATED BY GEO. R. MAYES —  
 SCALE 1"=100' APRIL, 5, 1945.  
C.D. 212 Bernard Lucas Engrs.  
Thos. F. Morgan