


W. H. HUGHES
MINE NEAR
MARTINDALE
267

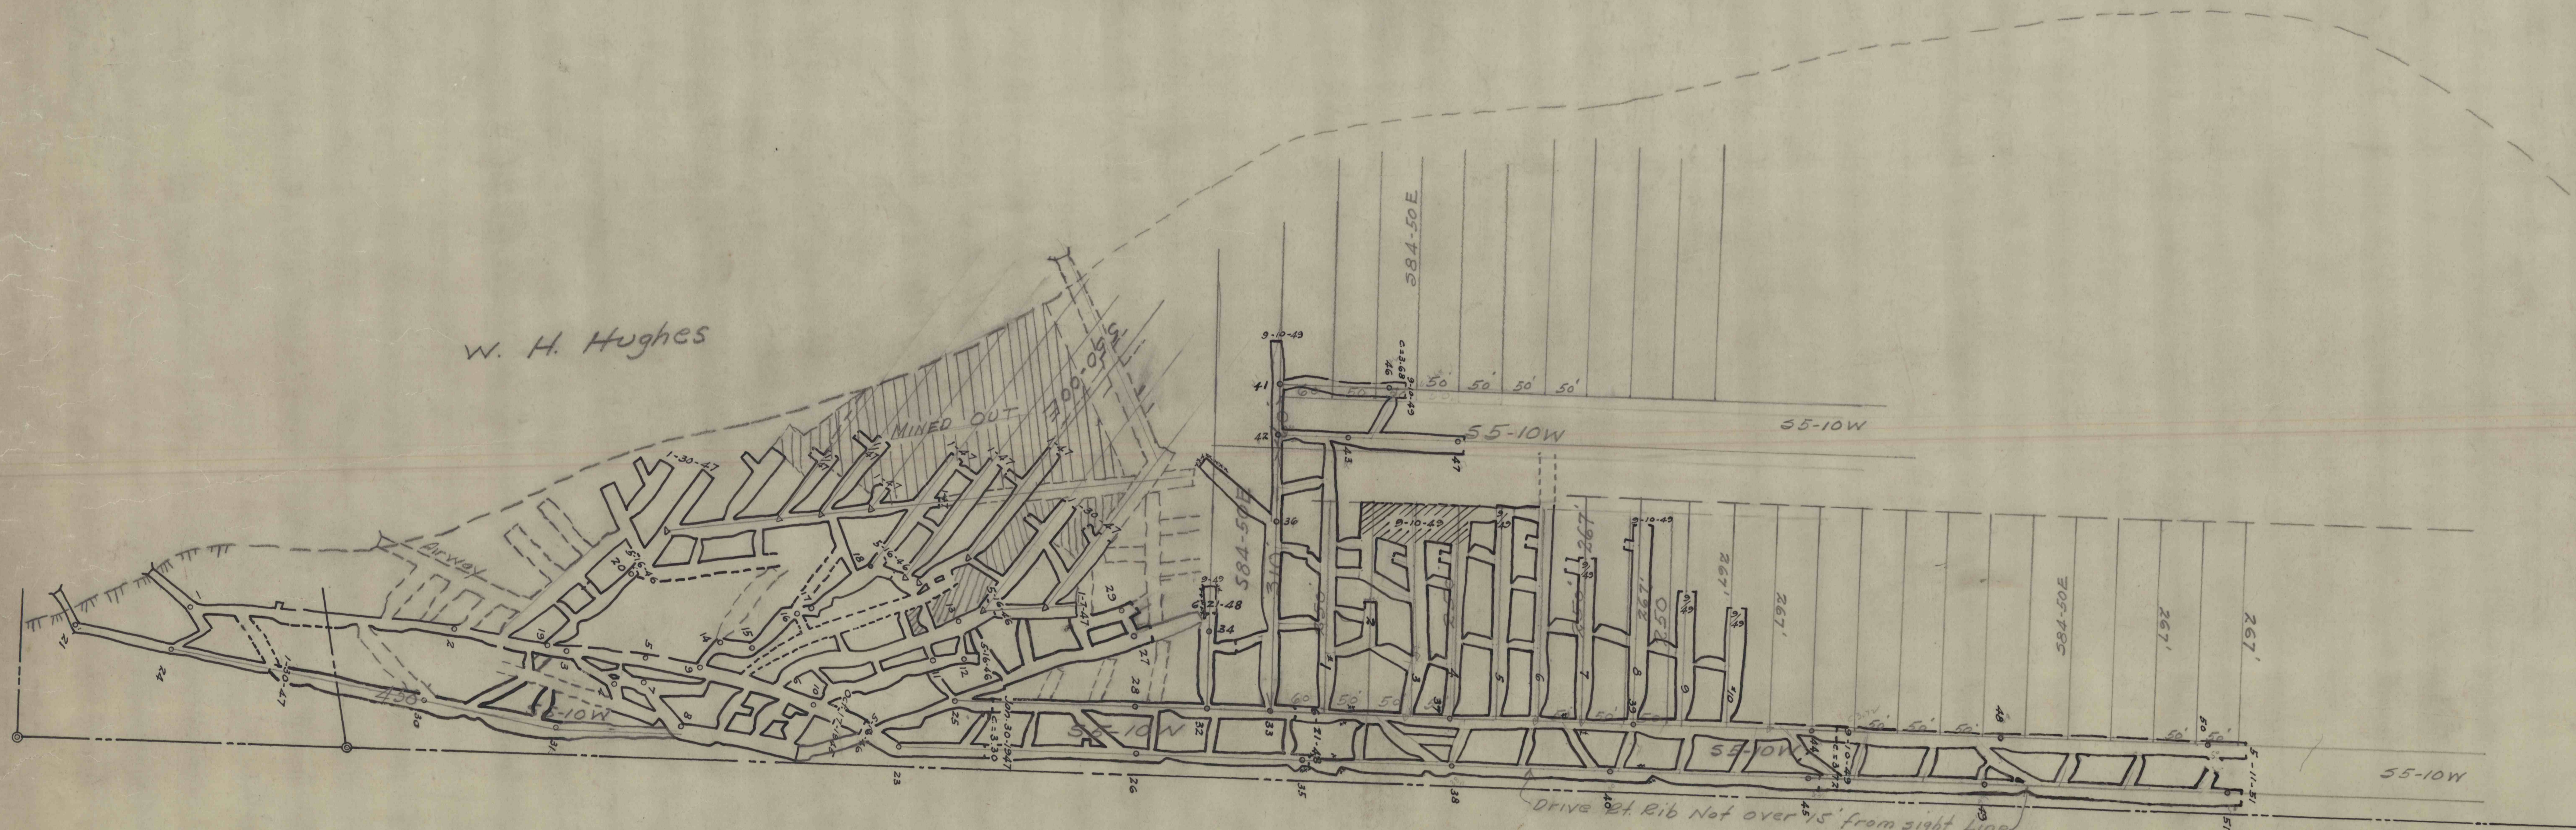

W. H. Hughes

Johnstown Coal & Coke Co.

W. H. HUGHES
MINE NEAR MARTINDALE
Y=100
POSTED TO 5/11/51