


2947

2947

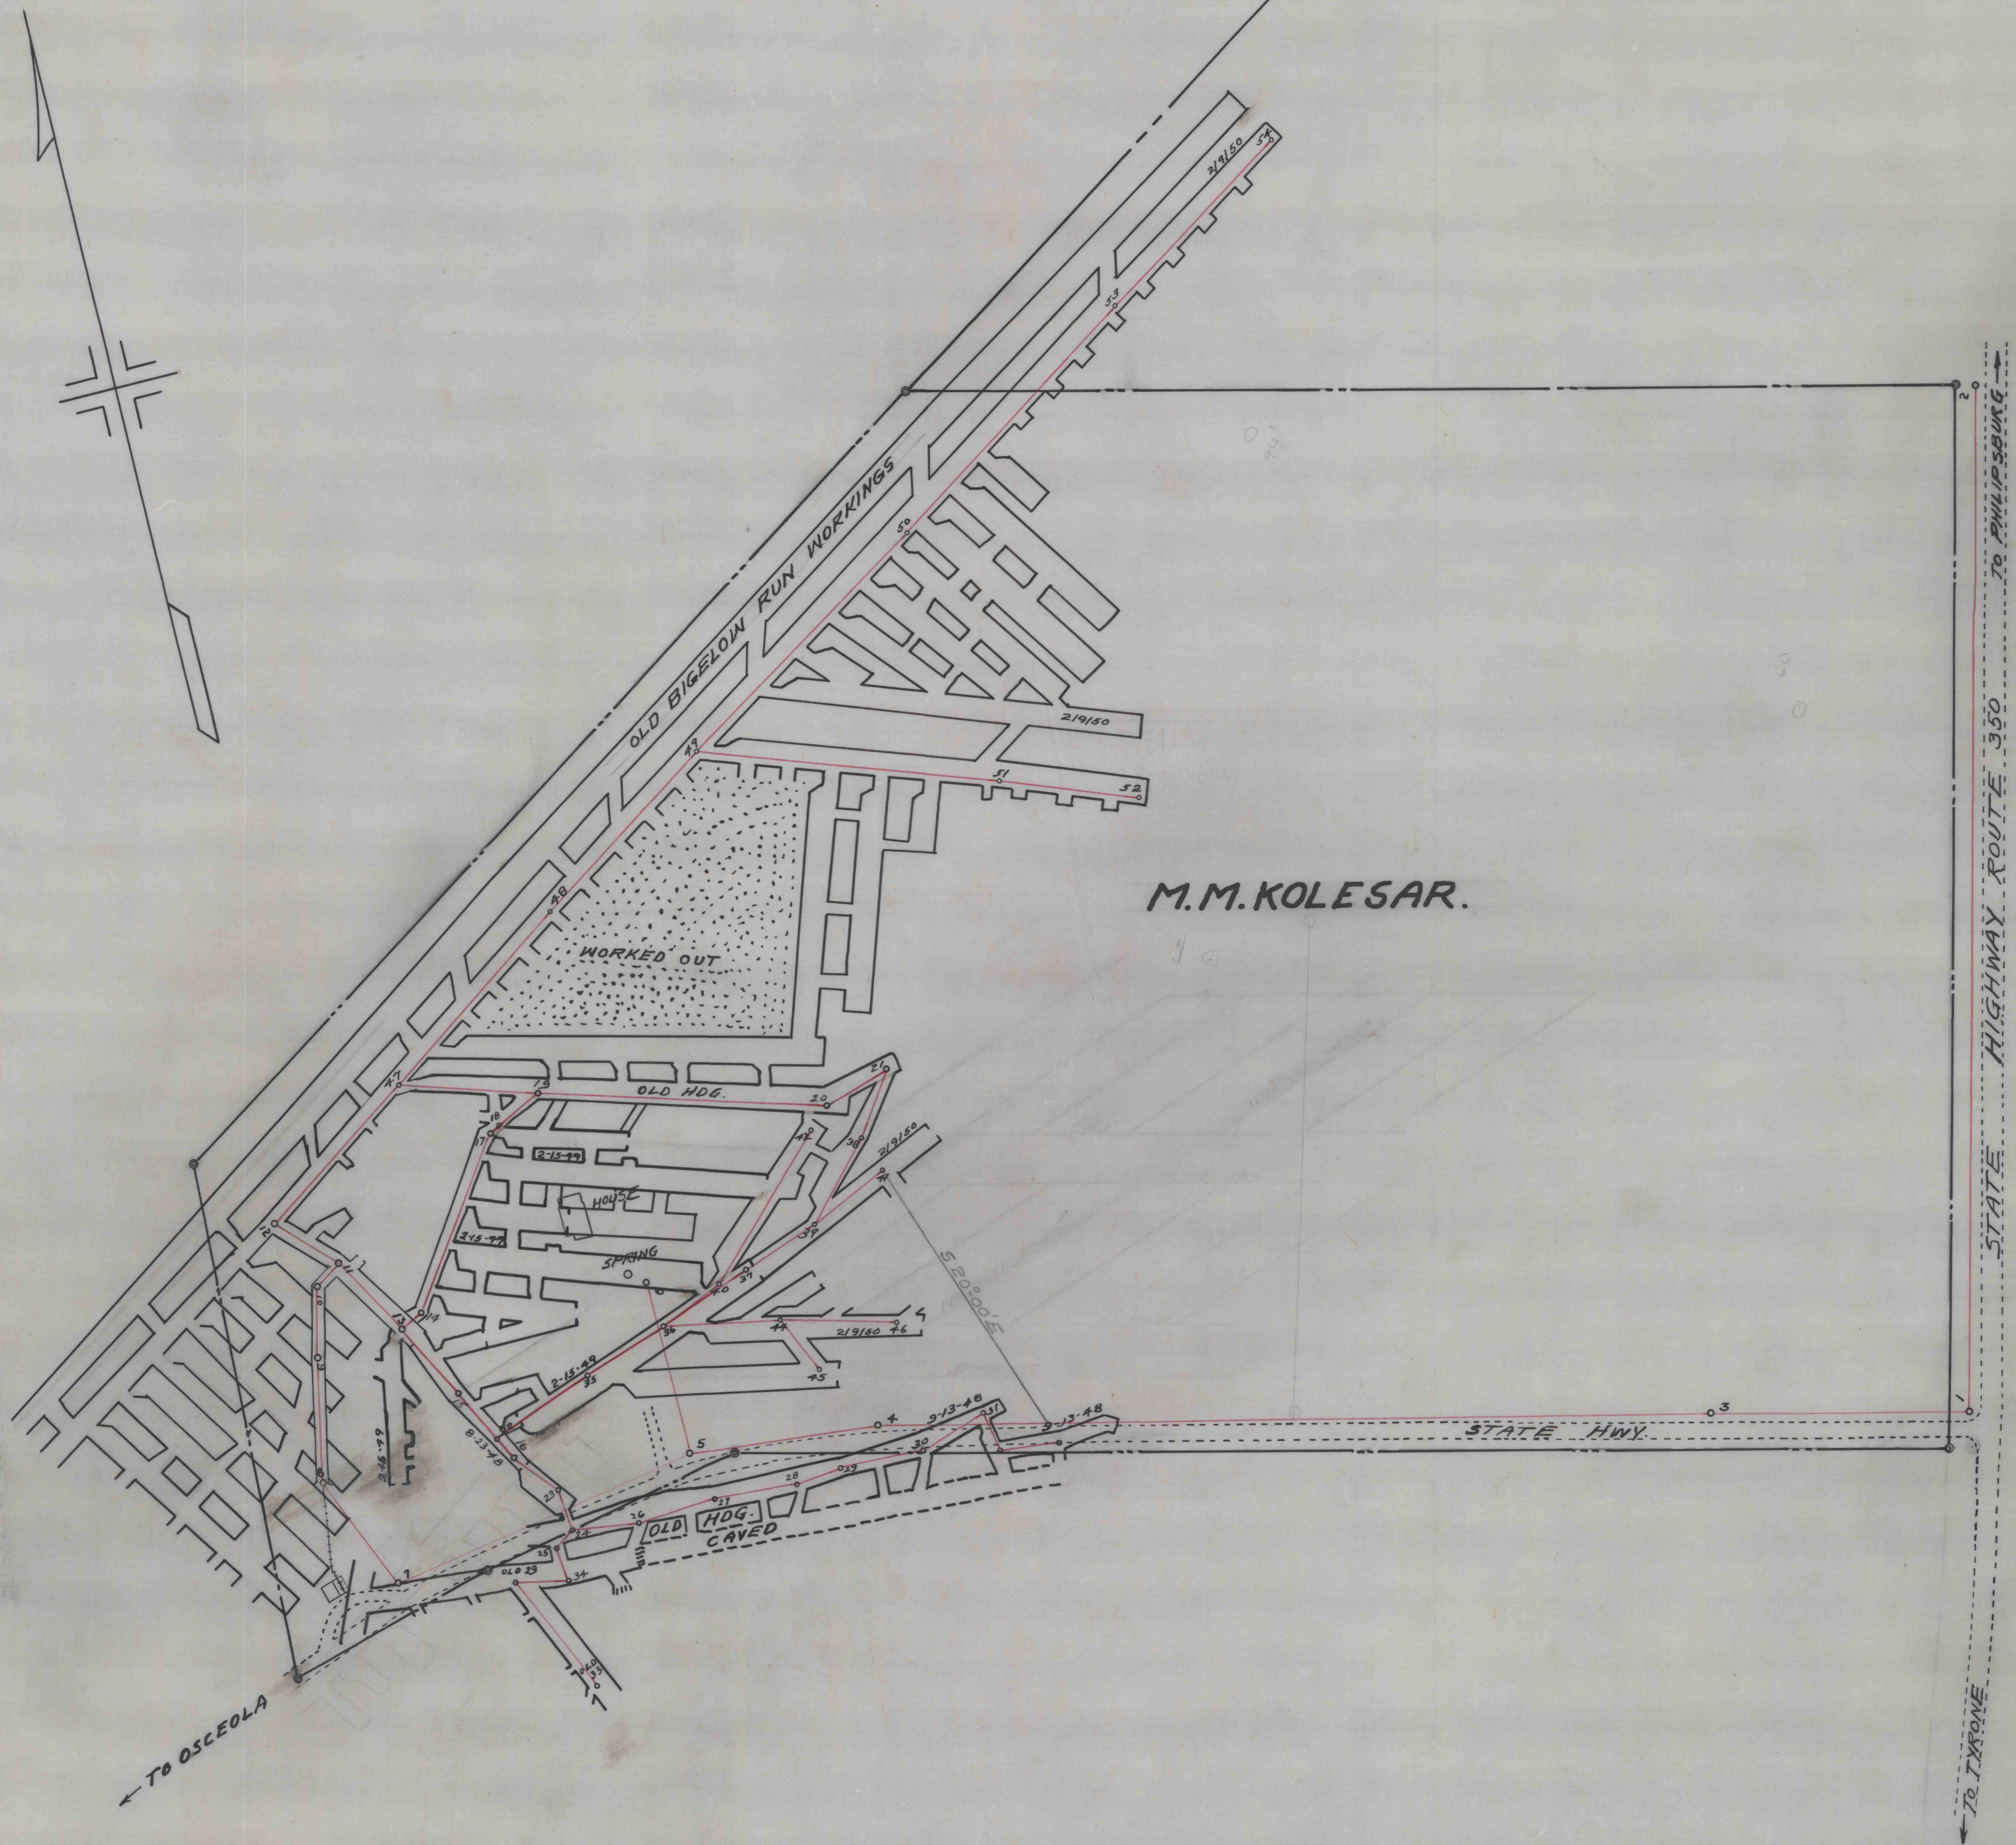

D

— MAP OF ROSELAWN MINE —
 — RUSH TOWNSHIP CENTRE CO. PA., —
 — OPERATED BY M.M. KOLESAR —
 — SCALE 1"=100' — — JAN. 6, 1948 —
 POSTED TO SEPT. 13, 1948.

C.D. 297