


SP15

K. C. CO.

ROWLAND TRACT

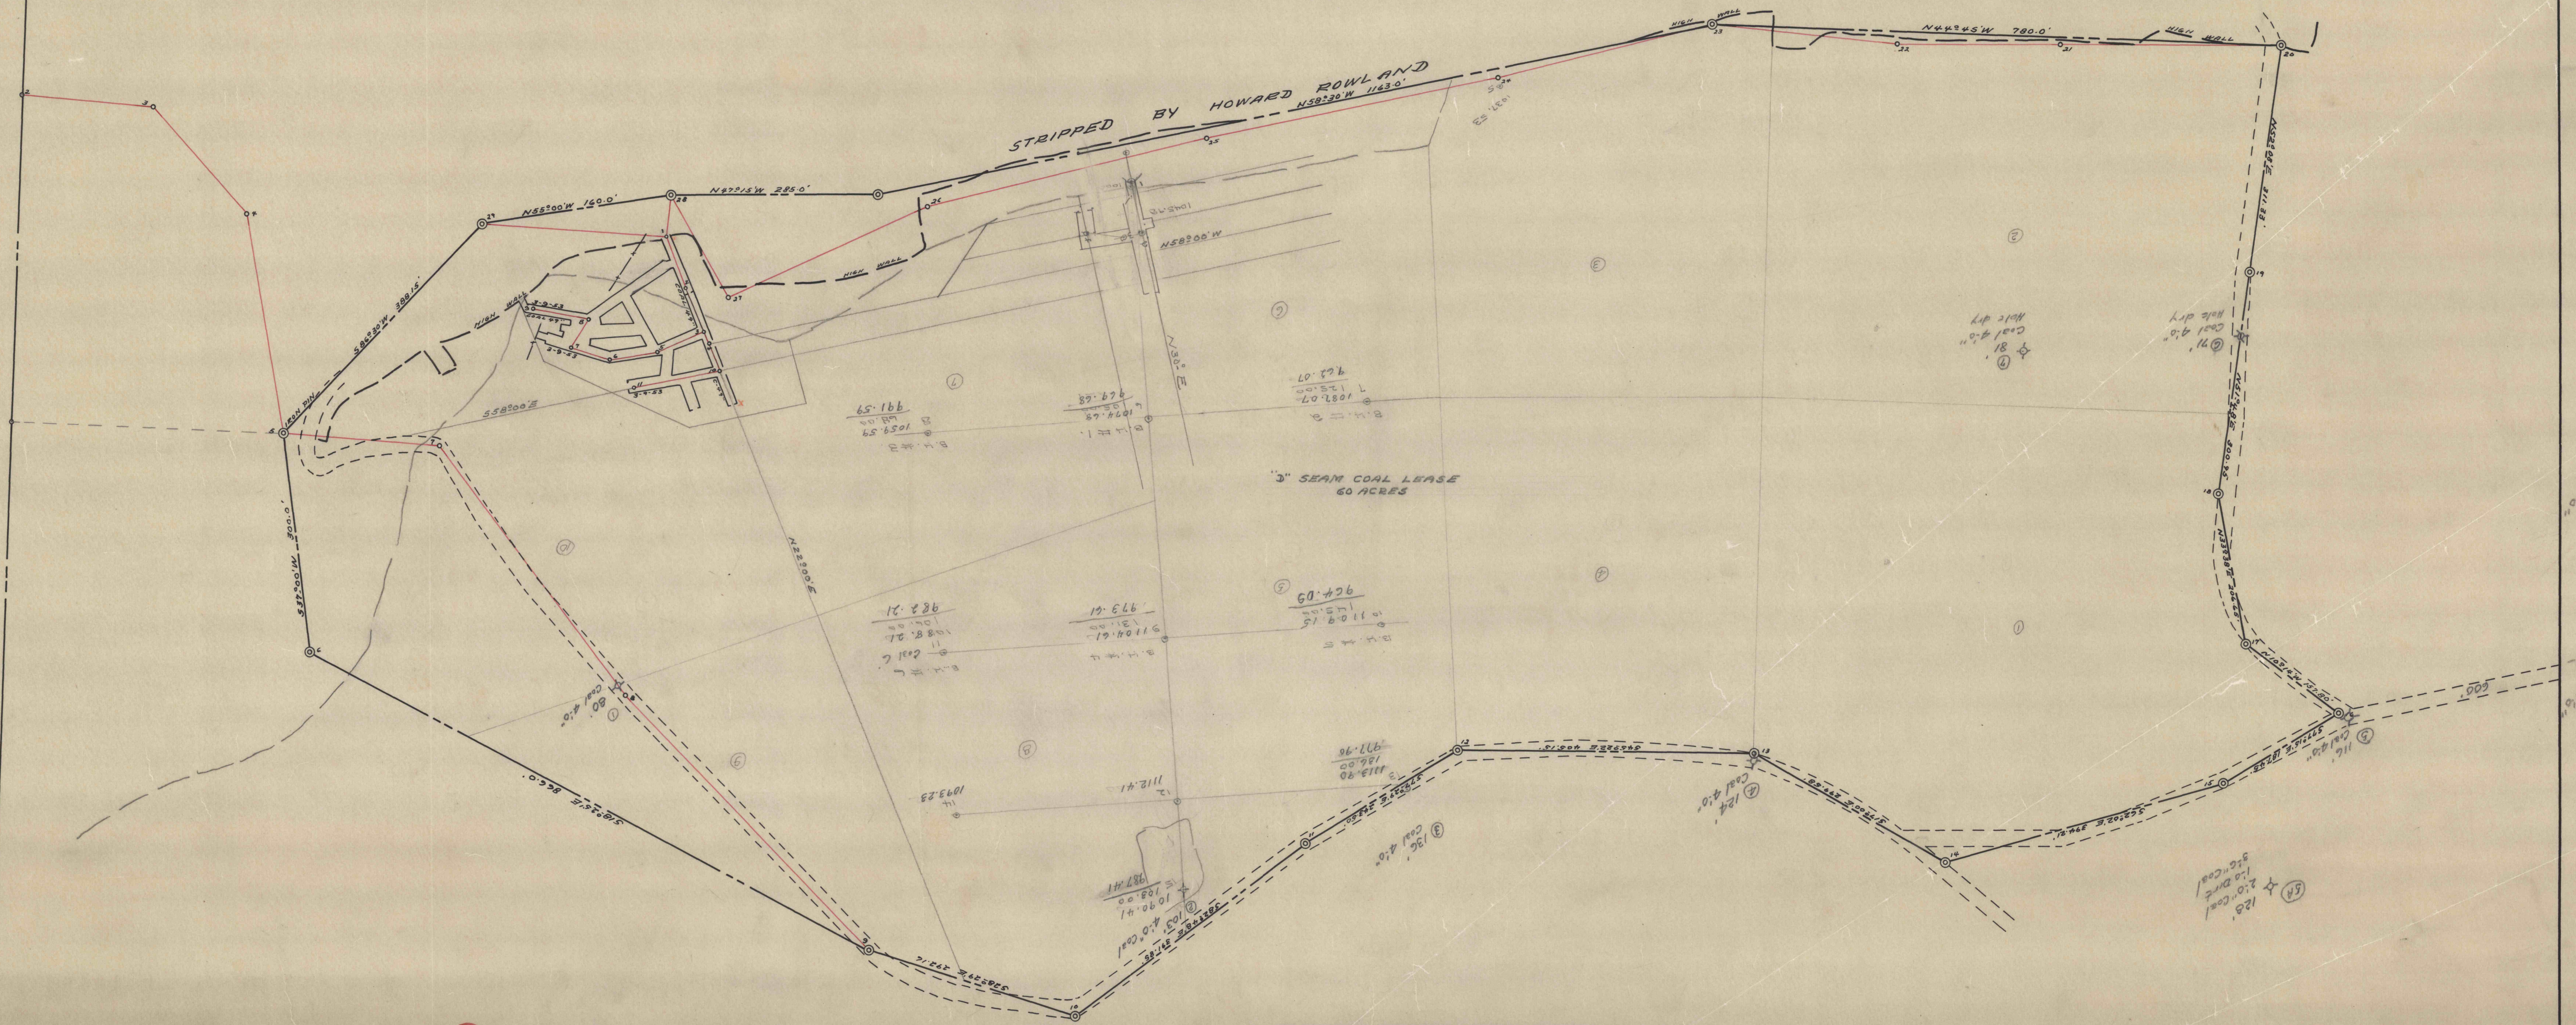

D

ROWLAND TRACT

— MAP SHOWING "D" SEAM COAL LEASE —
 — OPERATED BY J.E. FOX COAL COMPANY —
 — WOODWARD TWP. CLEARFIELD CO. PA. —
 — SCALE 1" = 100' — OCT. 28 1952 —
 — BERNARD LUCAS ENGR. —

C.D. 388

2792