


2797

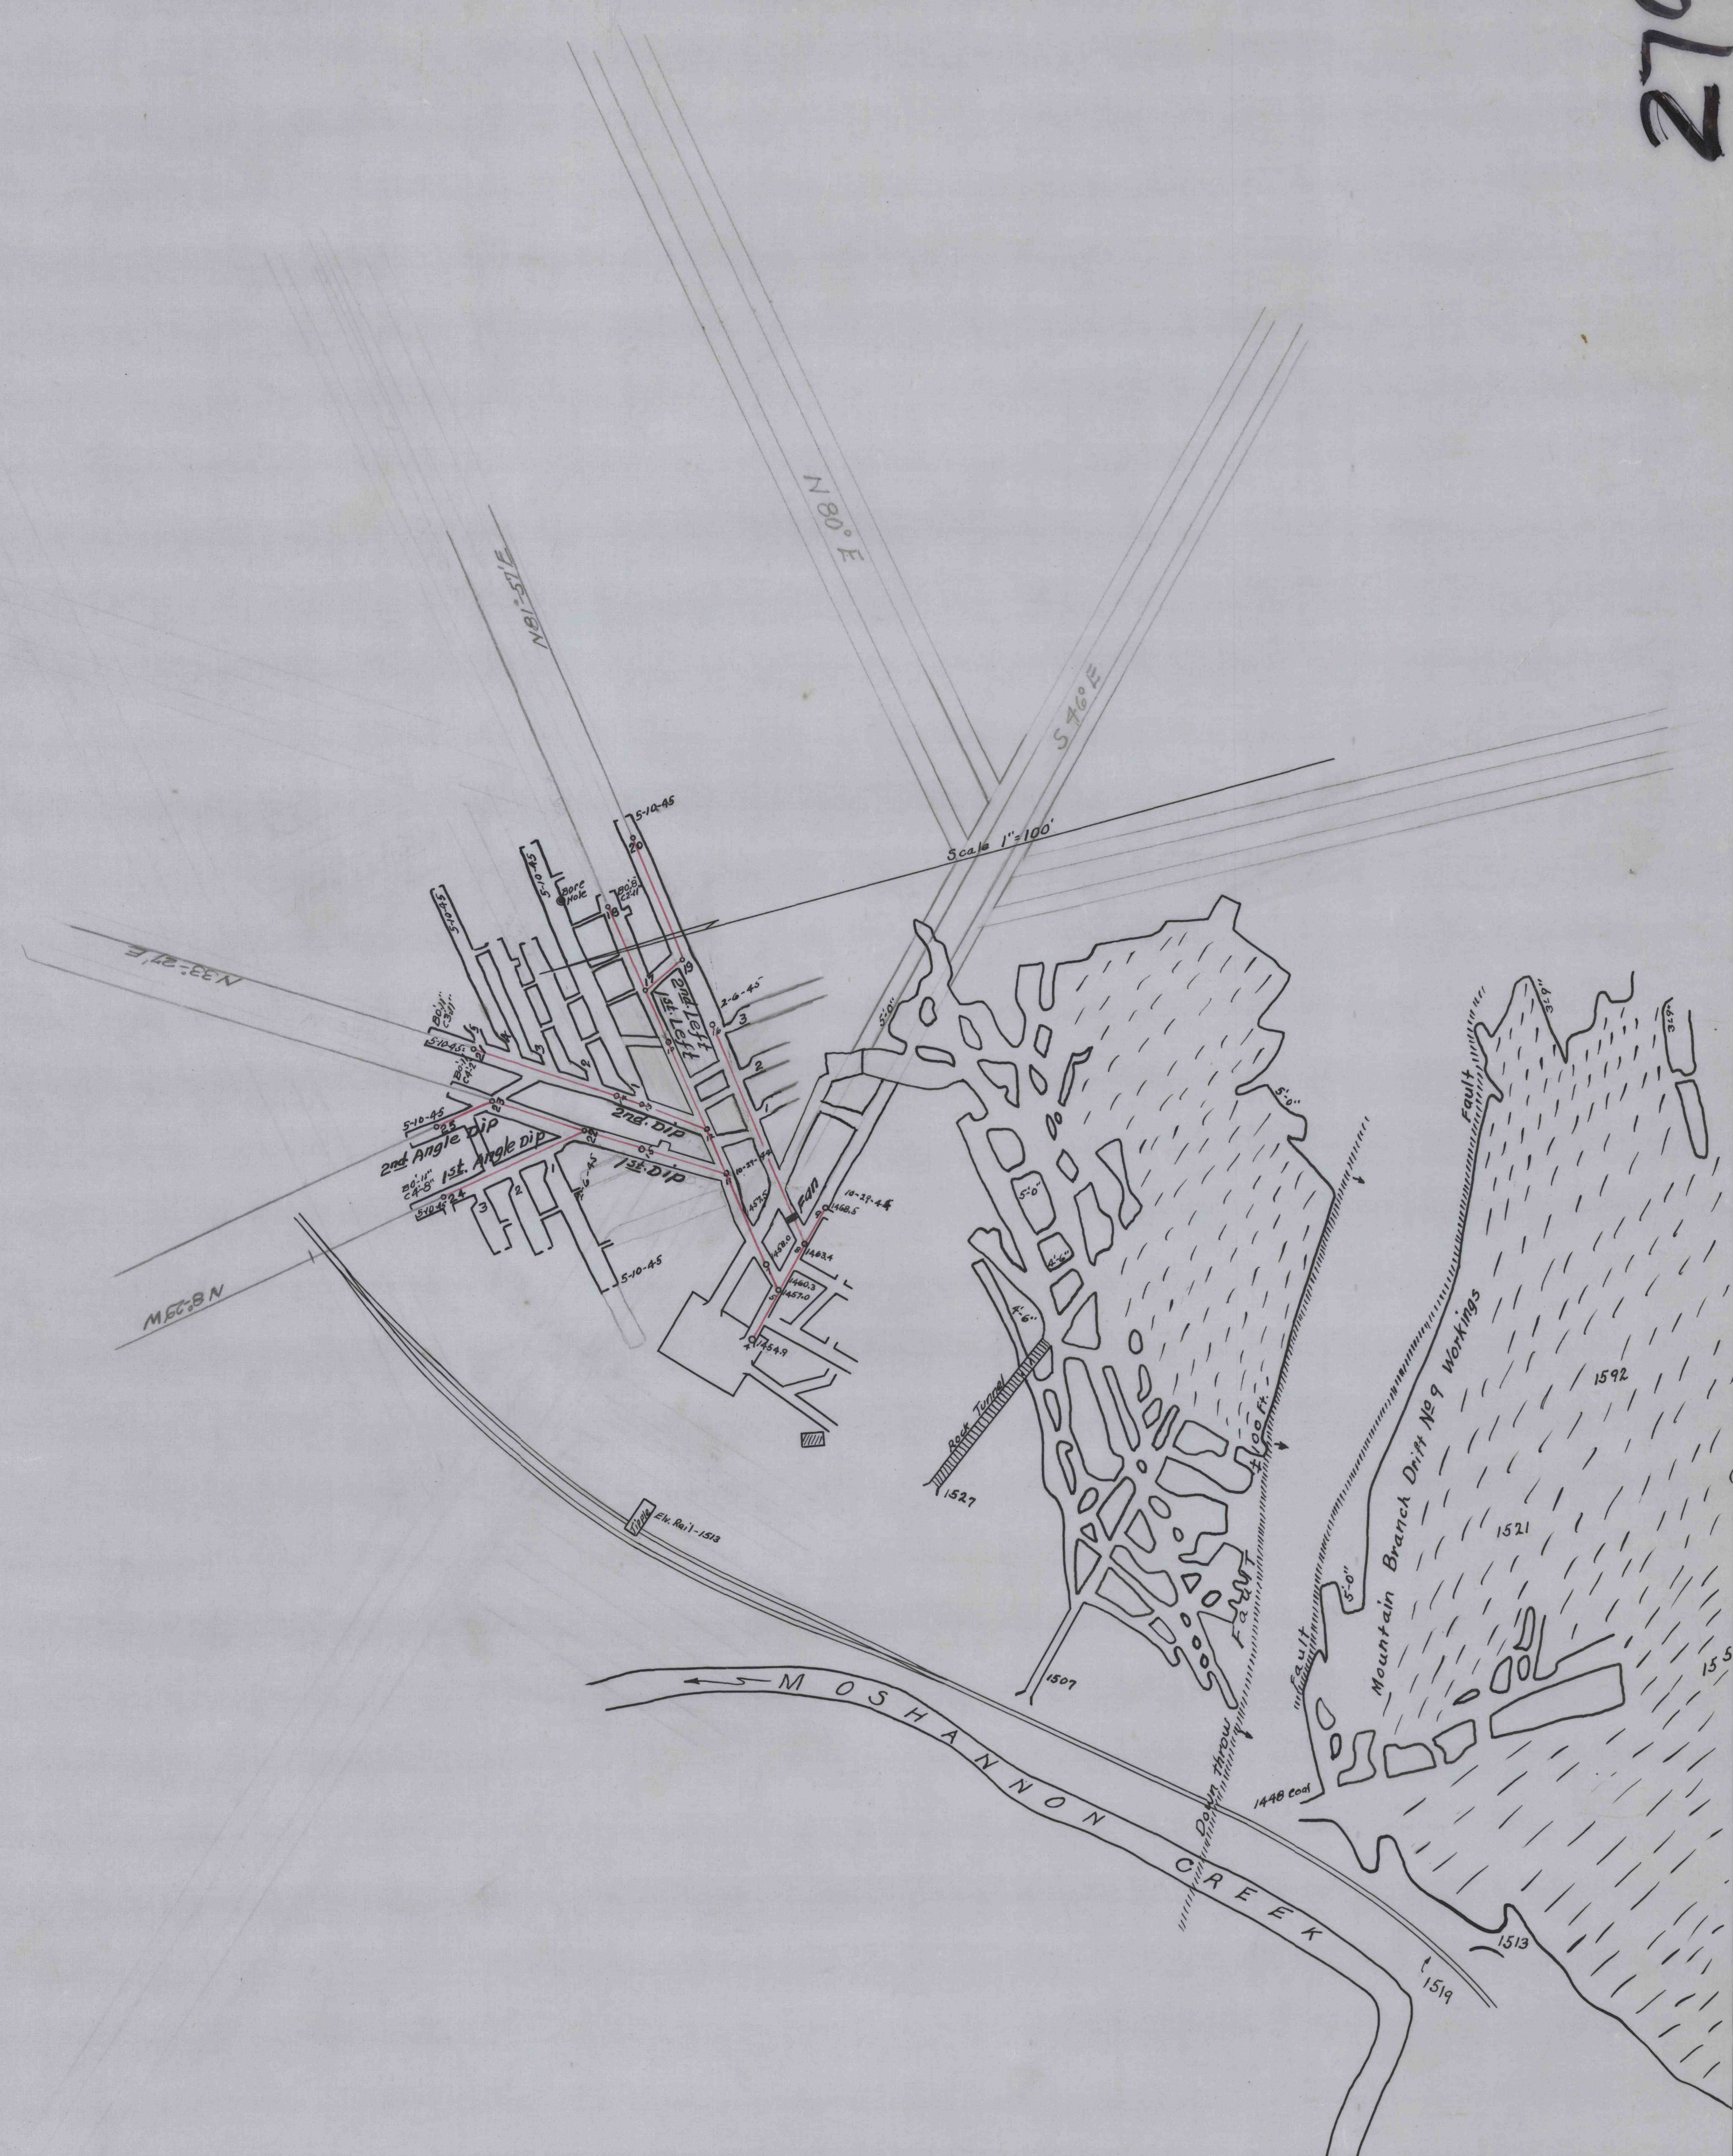

D

MAP OF
MOUNTAIN BRANCH MINE
OPERATED BY
DAHLIN BROTHERS
HOUTZDALE — PENNSYLVANIA
 Scale 1"=100' — November 1, 1944. — J.W. Milson, Eng.

C.D. 203