
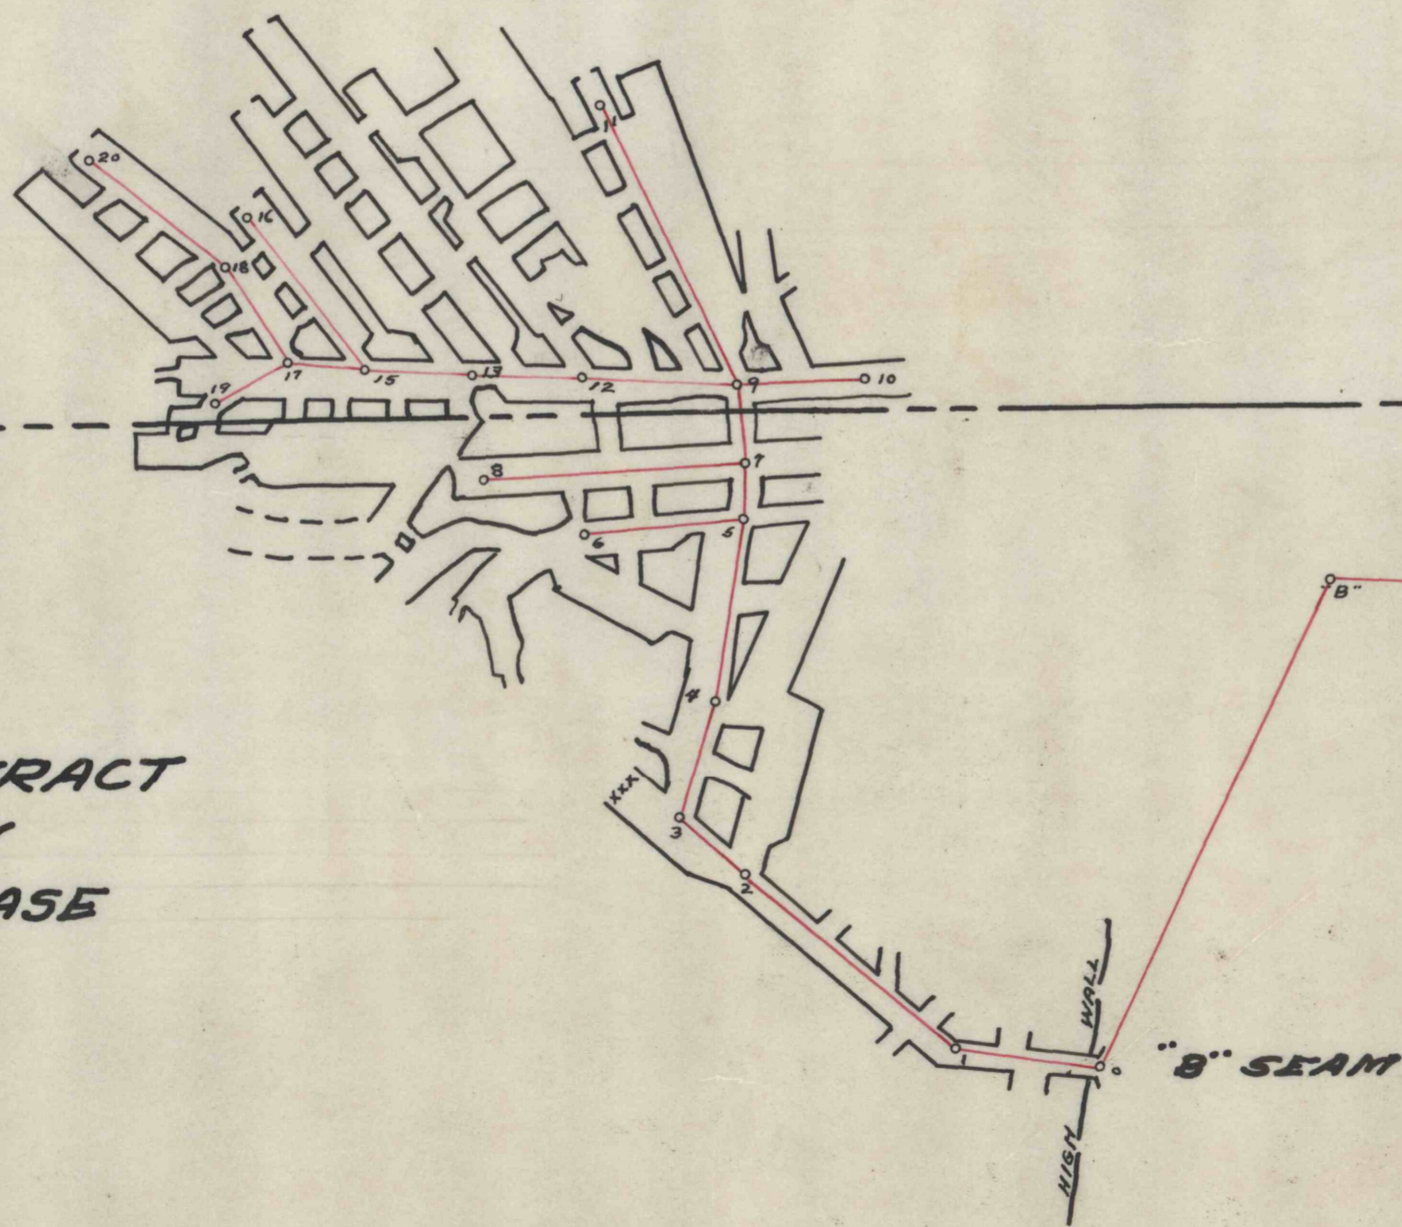


1083

JOHN GUNDAKER TRACT  
D.M. ELLIS  
DUGAN COAL LEASE

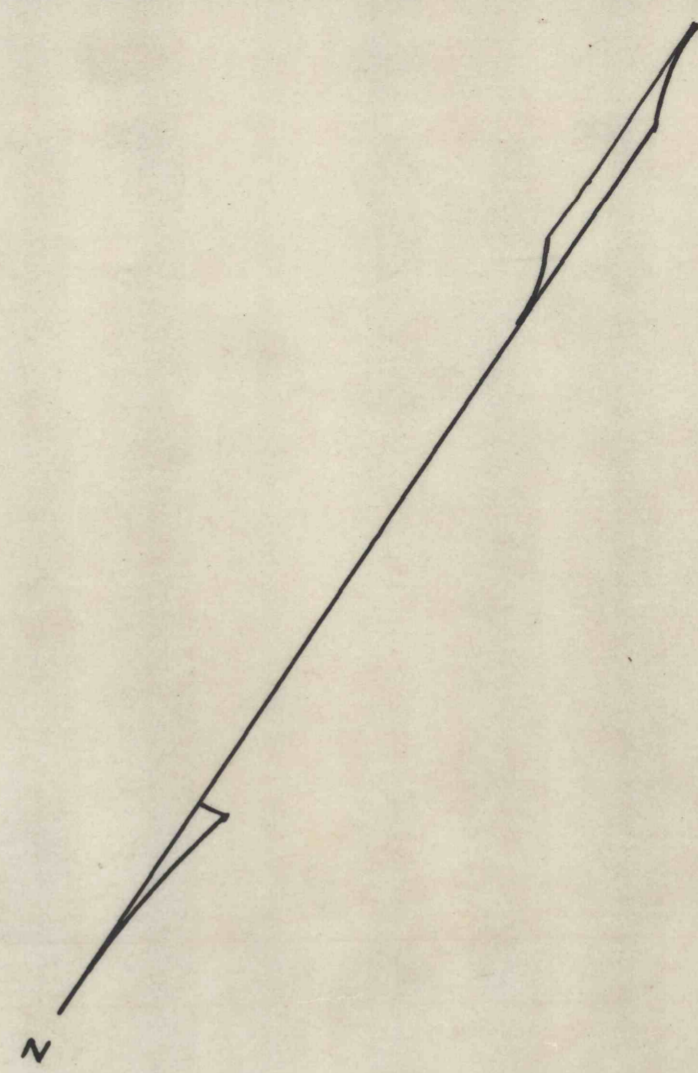

PAUL ZANTZINGER TRACT  
P.C. & L. COMPANY  
MURAWSKI COAL LEASE

D

- DUGAN COAL MINING CO. —
- MAP SHOWING PORTIONS OF —
- "B" SEAM MINE WORKINGS —
- RUSH TWP. CENTRE CO. PENNA. —
- SCALE 1"=100' - MAR. 16, 1951 —

— BERNARD LUCAS ENGR. —

C.D. 225

2801