


MICHAEL GUNDAKER
DAVID M. ELLIS

GEORGE SLOUGH
DAVID M. ELLIS

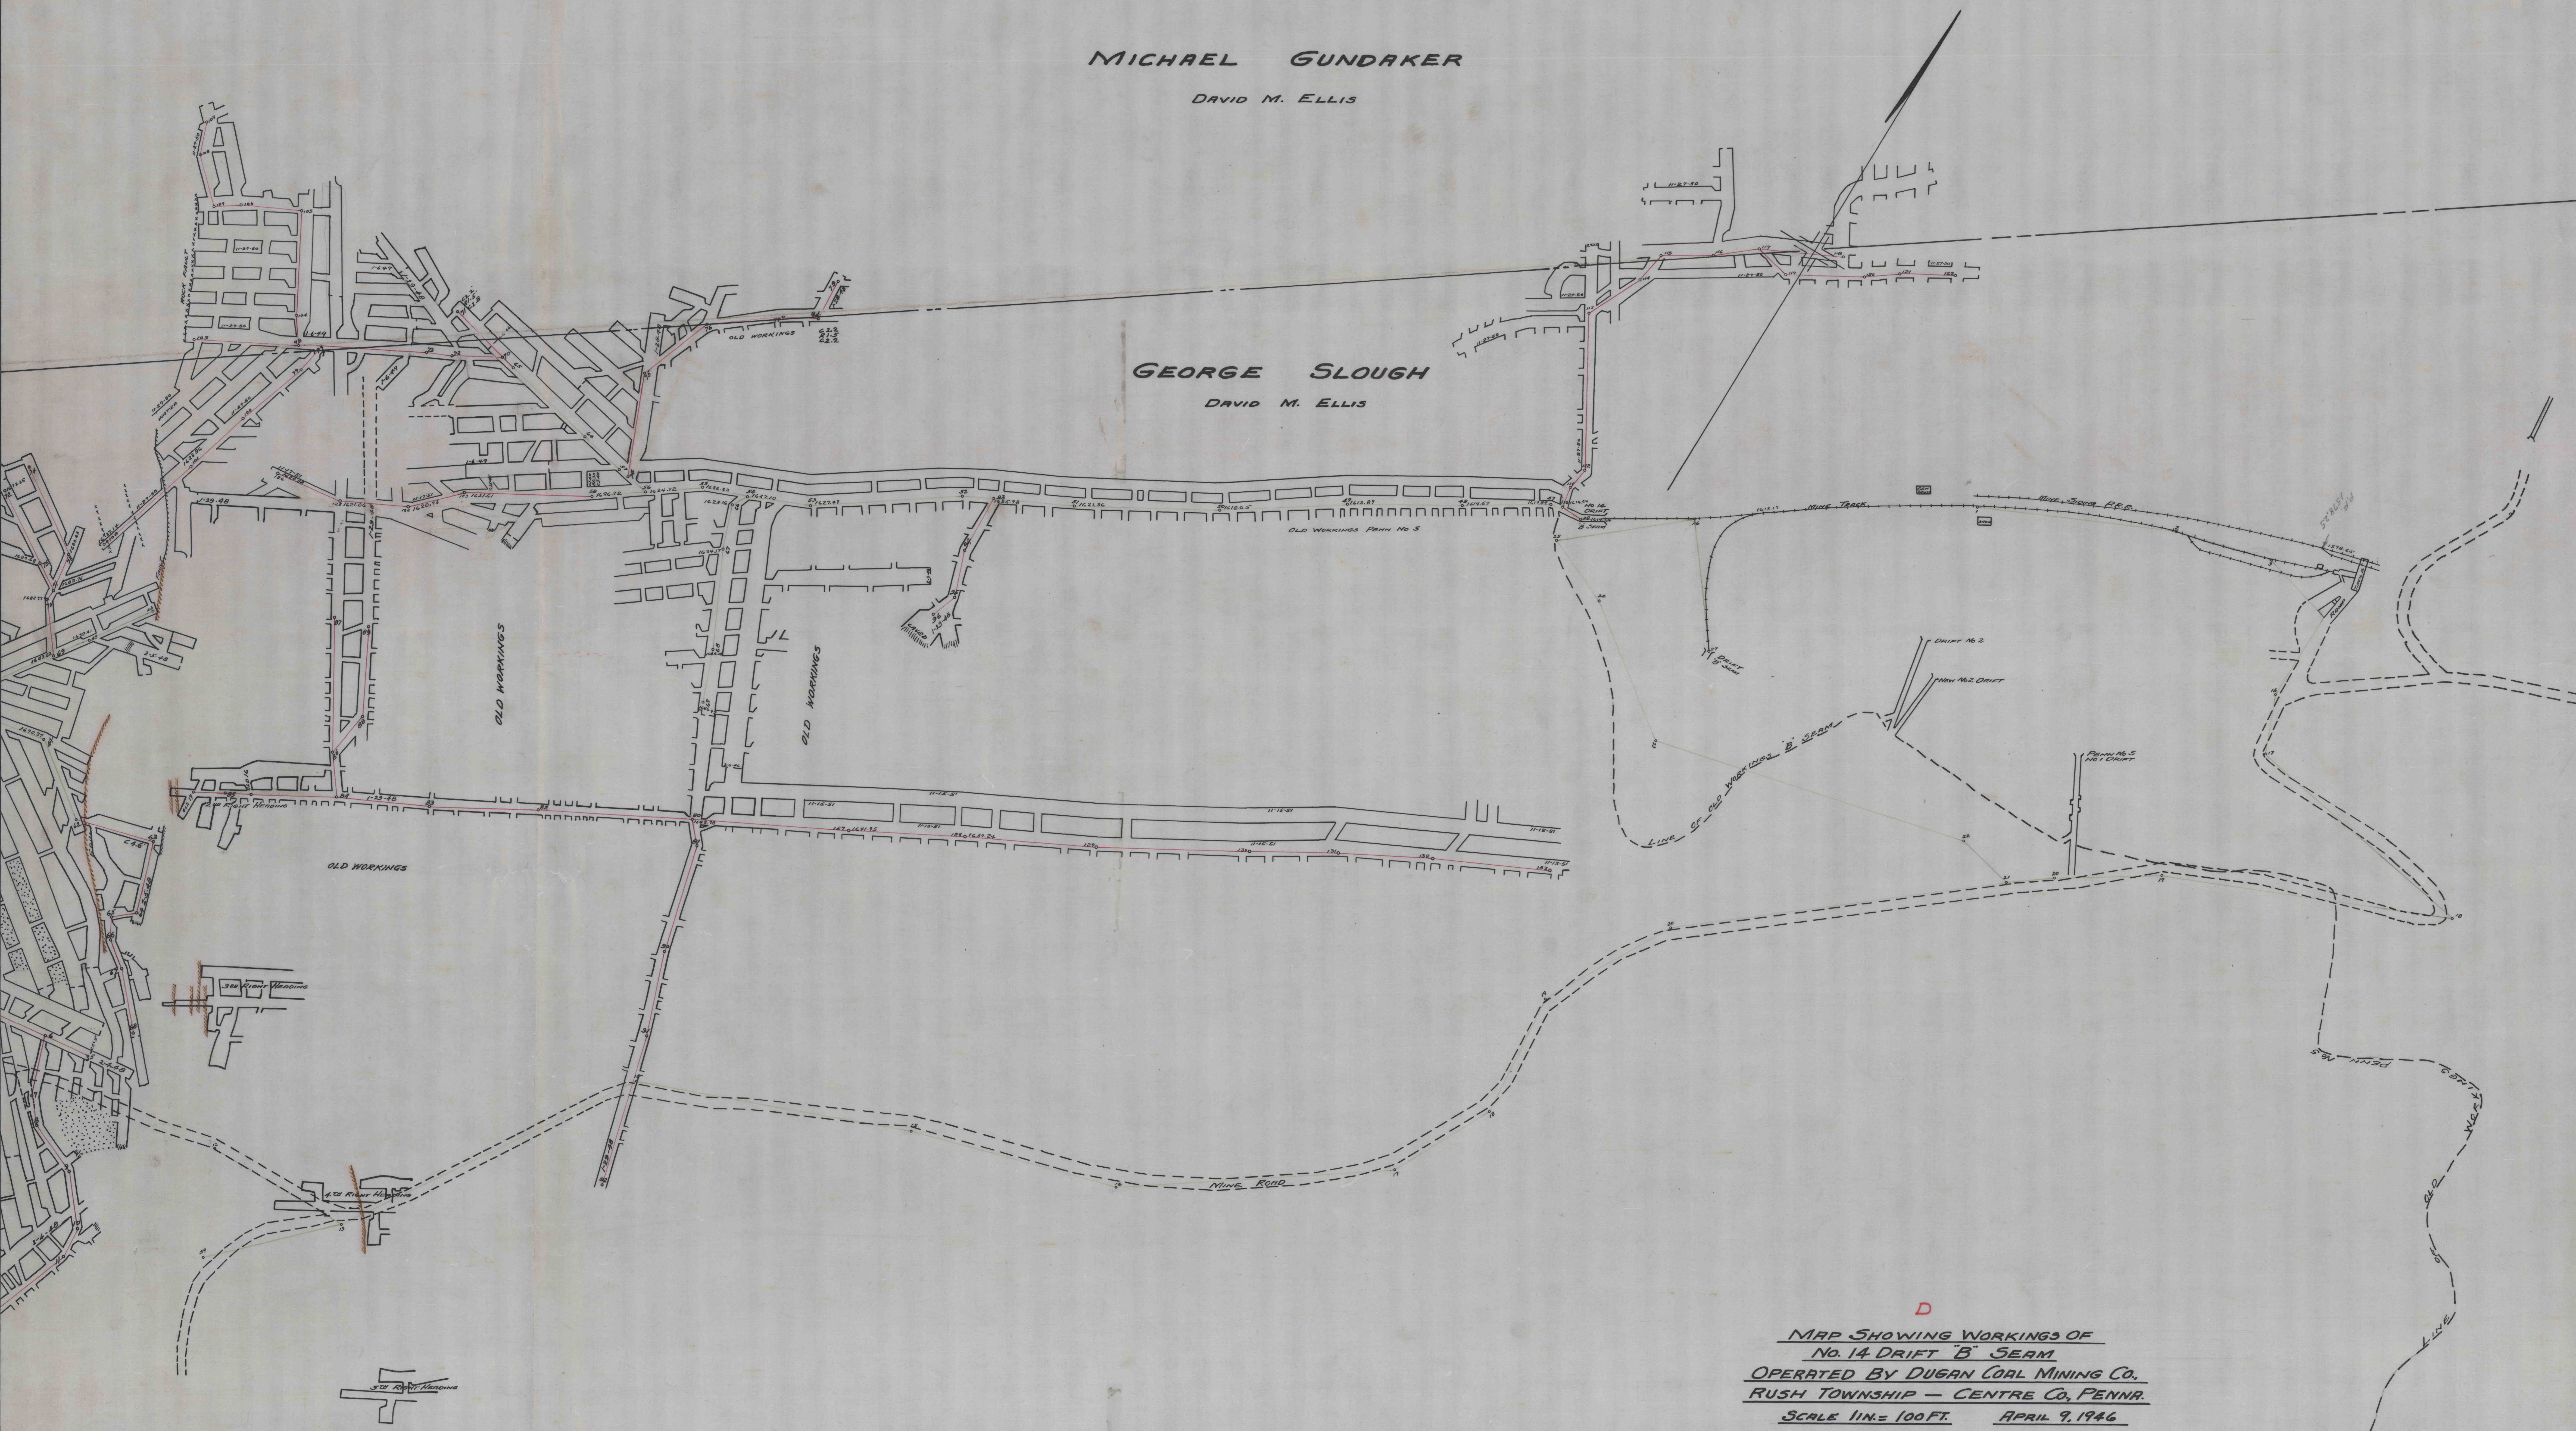

D
 MAP SHOWING WORKINGS OF
 No. 14 DRIFT B SEAM
 OPERATED BY DUGAN COAL MINING CO.
 RUSH TOWNSHIP - CENTRE CO., PENNA.
 SCALE 1 IN. = 100 FT. APRIL 9, 1946
 C.D. 225 BARNES LUCAS
 J. H. MARRAS