

2867

FANNIE SMITH  
NOW  
K. & J. COAL CO. INC.

MD  
— BORON BROTHERS COAL COMPANY —  
— MAP SHOWING —  
— STRIPPINGS ON ROBERT STEWART & —  
— FANNIE SMITH TRACTS —  
— GIRARD TWP. CLEARFIELD CO. PA. —  
— SCALE 1" = 100' — NOV. 12, 1947 —


C.D. 209

R.W. MAINS  
NOW  
K. & J. COAL CO. INC.

ROBERT STEWART  
NOW  
K. & J. COAL CO. INC.

JOHN JURY  
NOW  
K. & J. COAL CO. INC.

NOTE:  
IN YELLOW IS PROPOSED 10.00 ACRES UNDER  
ORIGINAL STRIPPING PERMIT NO. 56-11 THAT THE  
KRISTANSON & JOHNSON COAL CO. INC. WISHES TO  
DELETE & BOND NO. 1583208 RETURNED

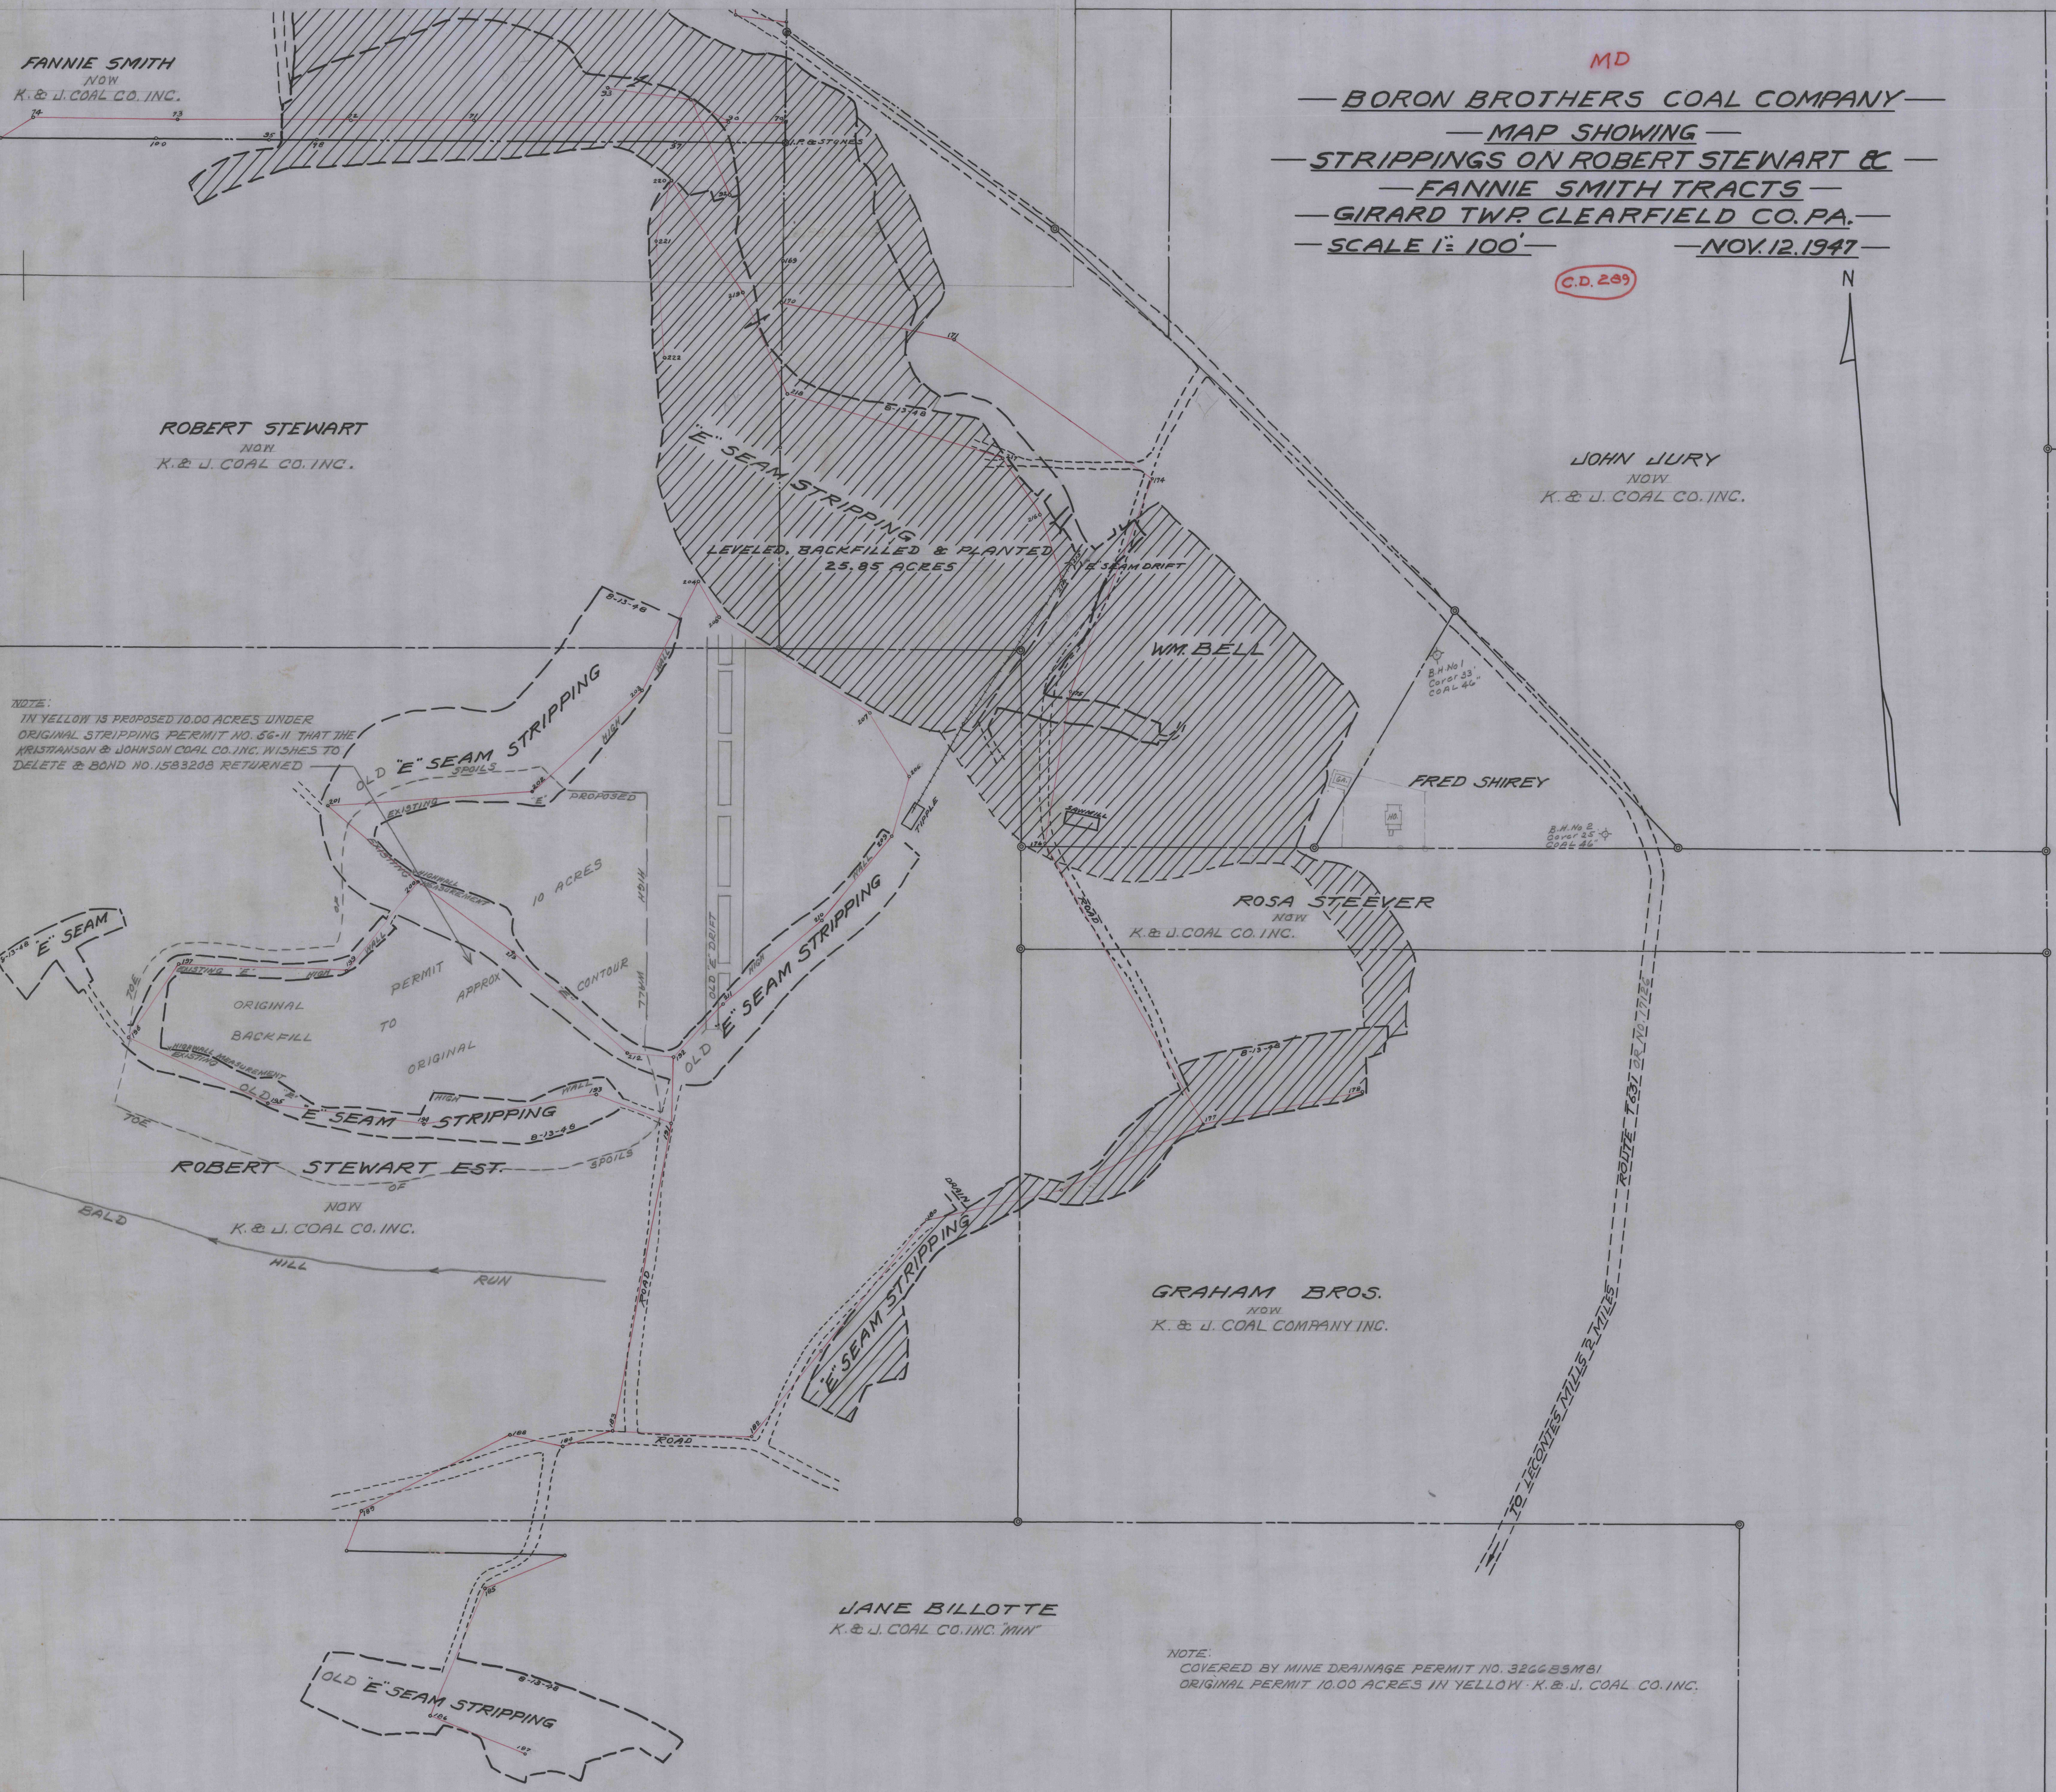

GRAHAM BROS.  
NOW  
K. & J. COAL COMPANY INC.

JANE BILLOTTE  
K. & J. COAL CO. INC. MINN

NOTE:  
COVERED BY MINE DRAINAGE PERMIT NO. 3266 B9M61  
ORIGINAL PERMIT 10.00 ACRES IN YELLOW - K. & J. COAL CO. INC.

GRAHAM BROS.  
NOW  
K. & J. COAL COMPANY INC.