

898c


M

— **BORON BROTHERS COAL COMPANY** —  
 — **MAP SHOWING** —  
 — **STRIPPINGS ON ASHLEY KYLER AND** —  
 — **FANNIE SMITH TRACTS** —  
 — **GIRARD TWP. CLEARFIELD CO. PA.** —  
 — **SCALE 1"=100'** —


**NOV. 12, 1947**  
 Bernard Lucas  
 Thos. F. Morgan

POSTED TO AUG. 3, 1948

C.D. 289

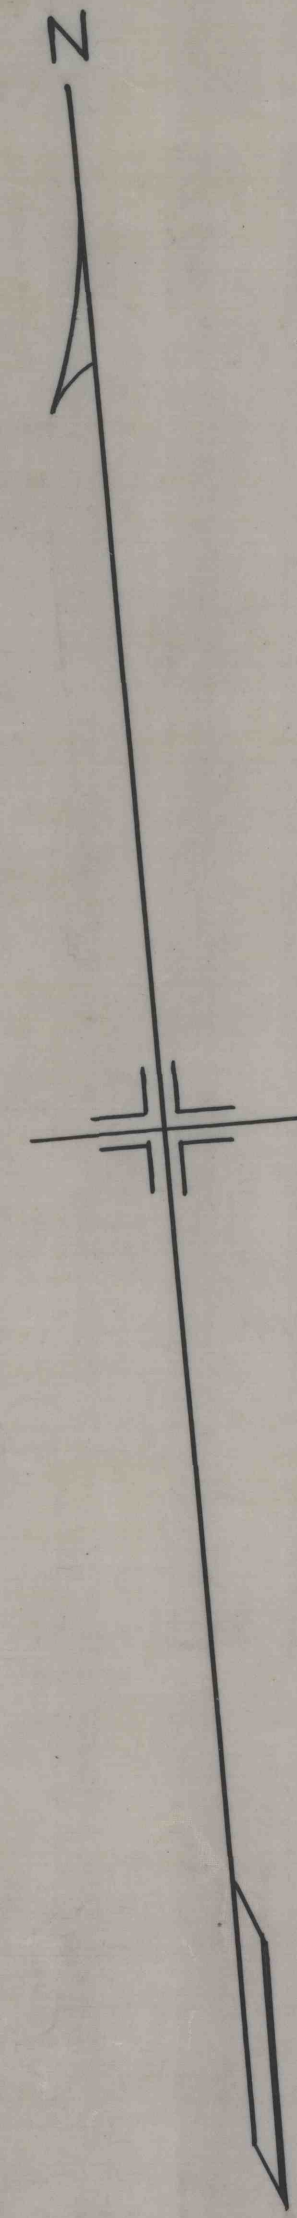

898b

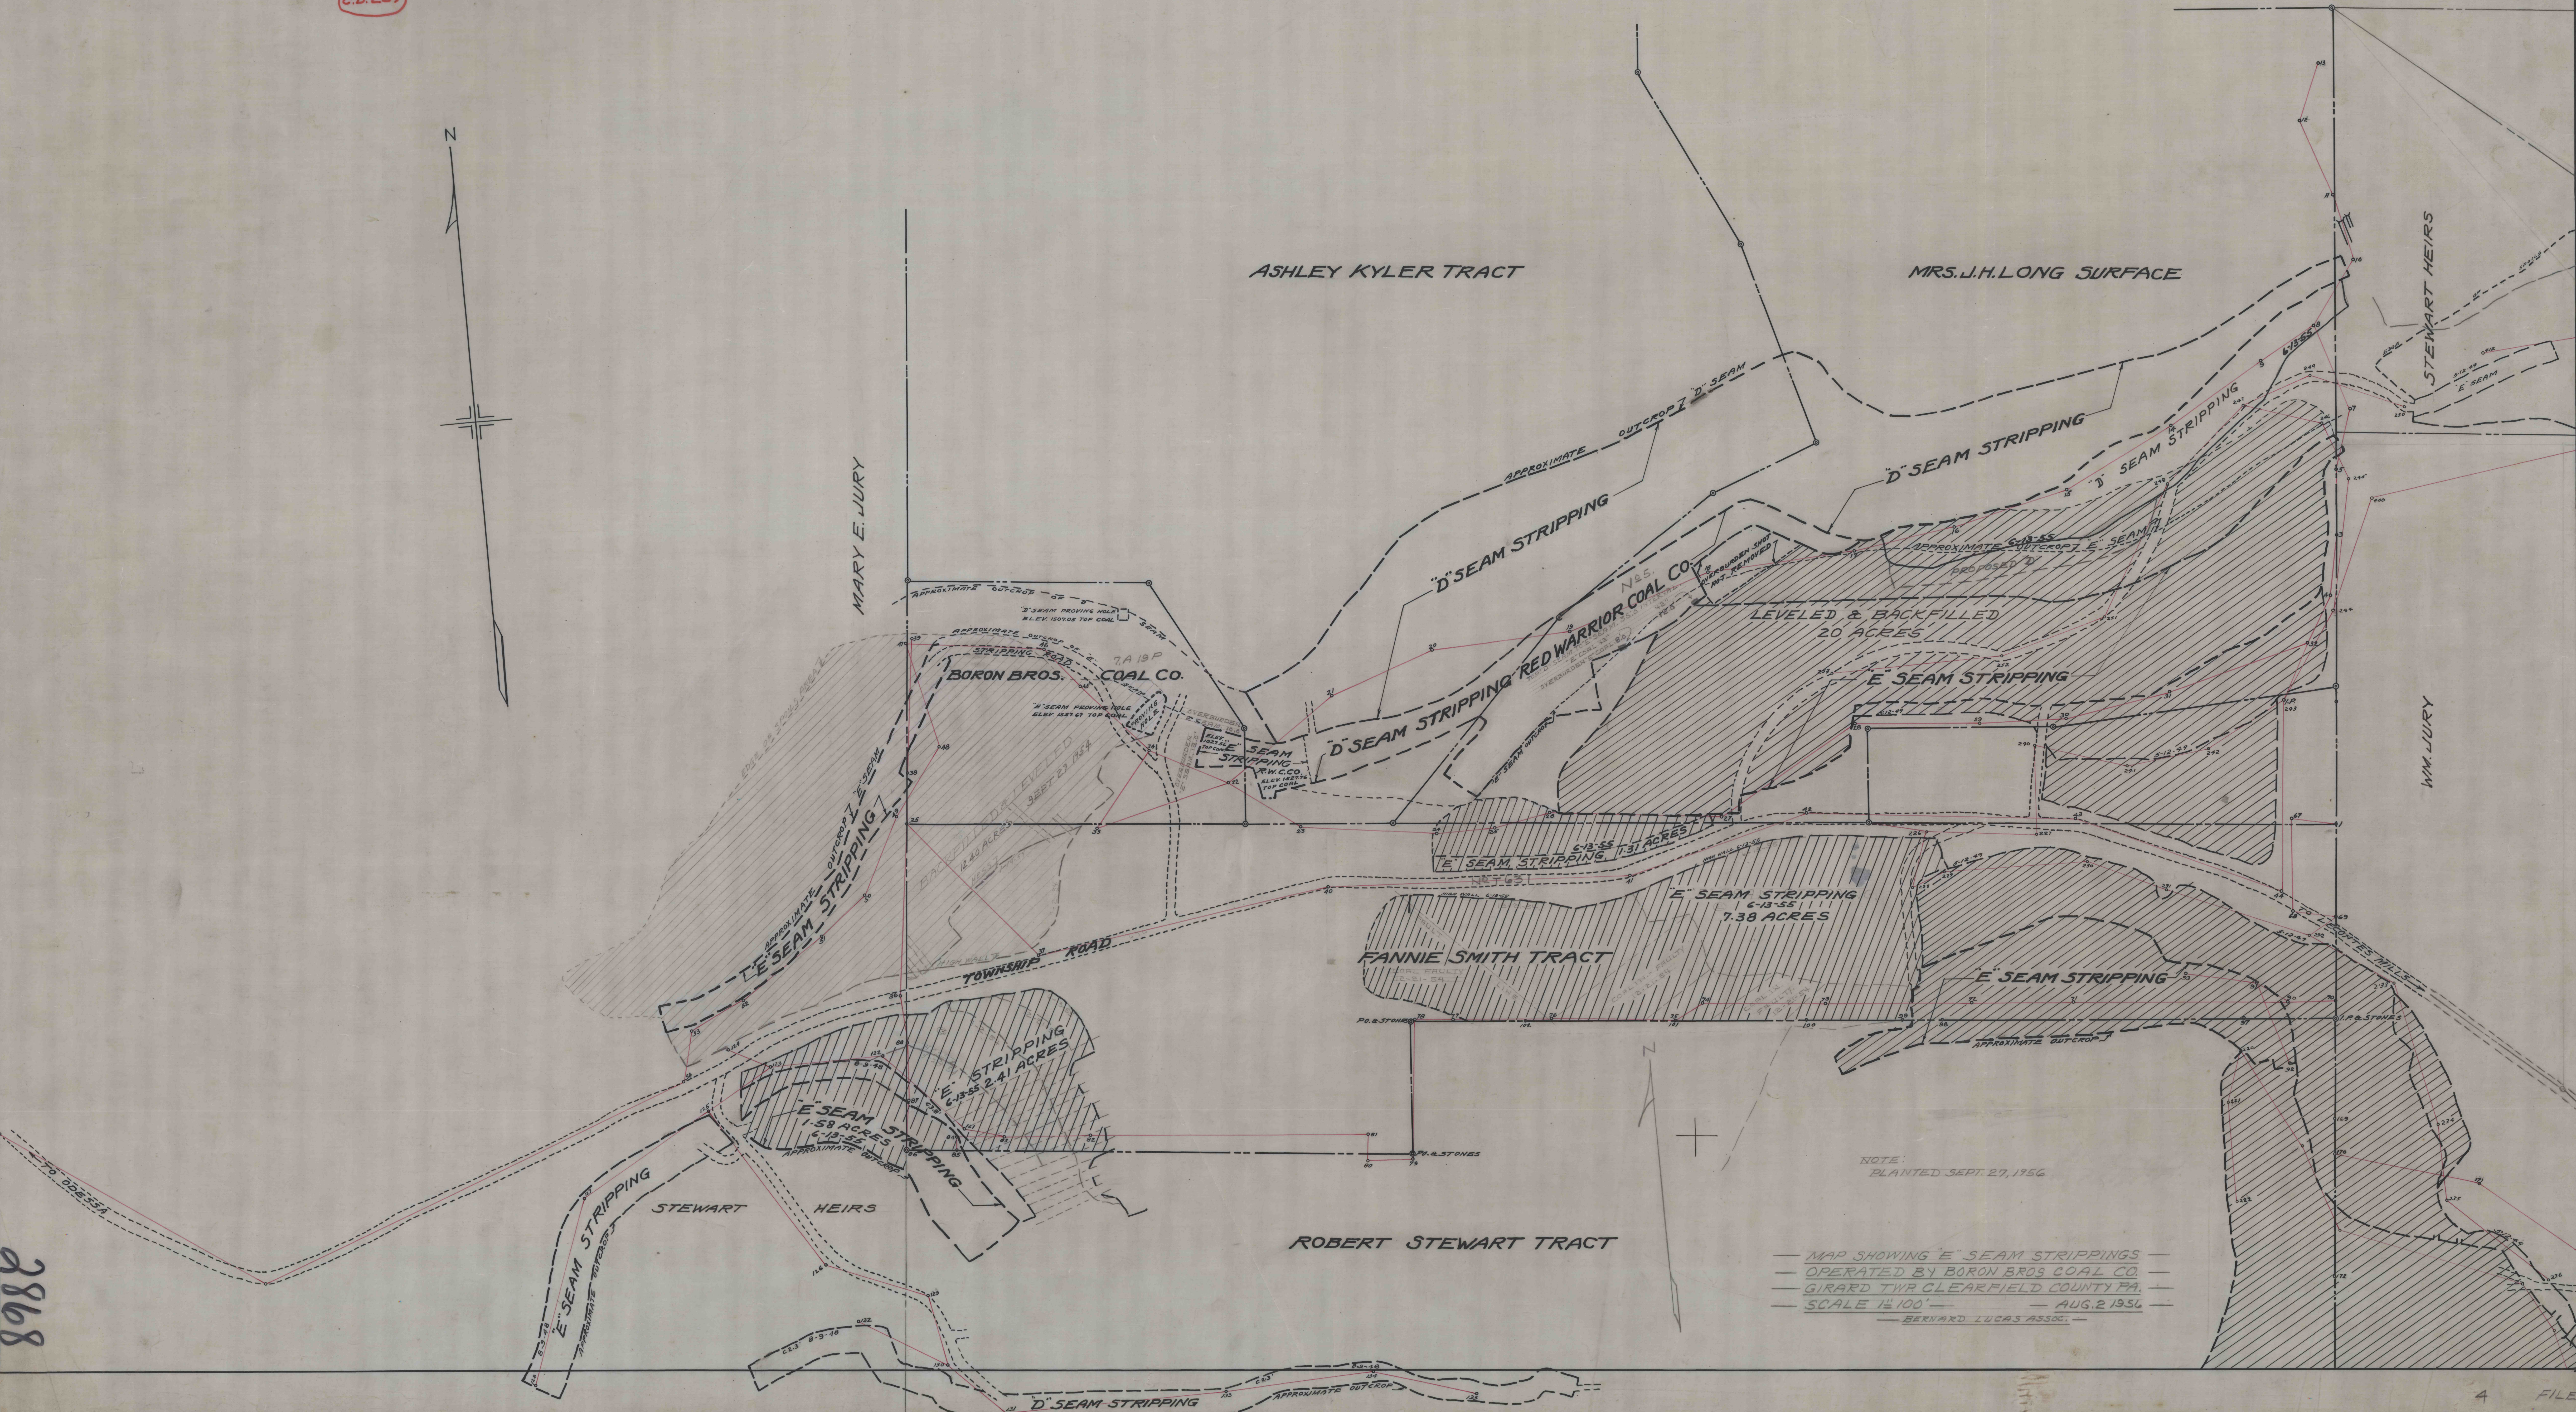

— **MAP SHOWING "E" SEAM STRIPPINGS** —  
 — **OPERATED BY BORON BROS COAL CO.** —  
 — **GIRARD TWP. CLEARFIELD COUNTY PA.** —  
 — **SCALE 1"=100'** — **AUG. 2, 1956** —  
 — **BERNARD LUCAS ASSOC.** —