


2885


2872

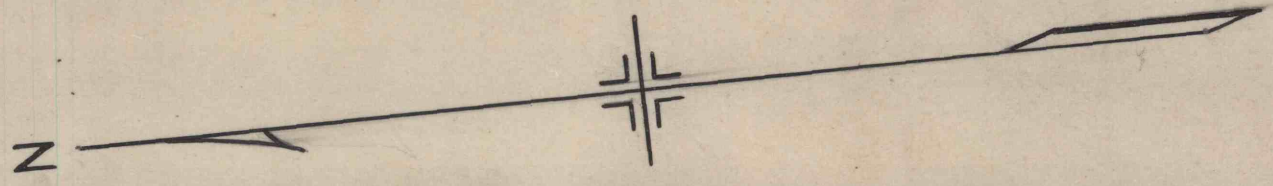

CARR TRACT

GRAHAM BROTHERS TRACT

JOHN JURY

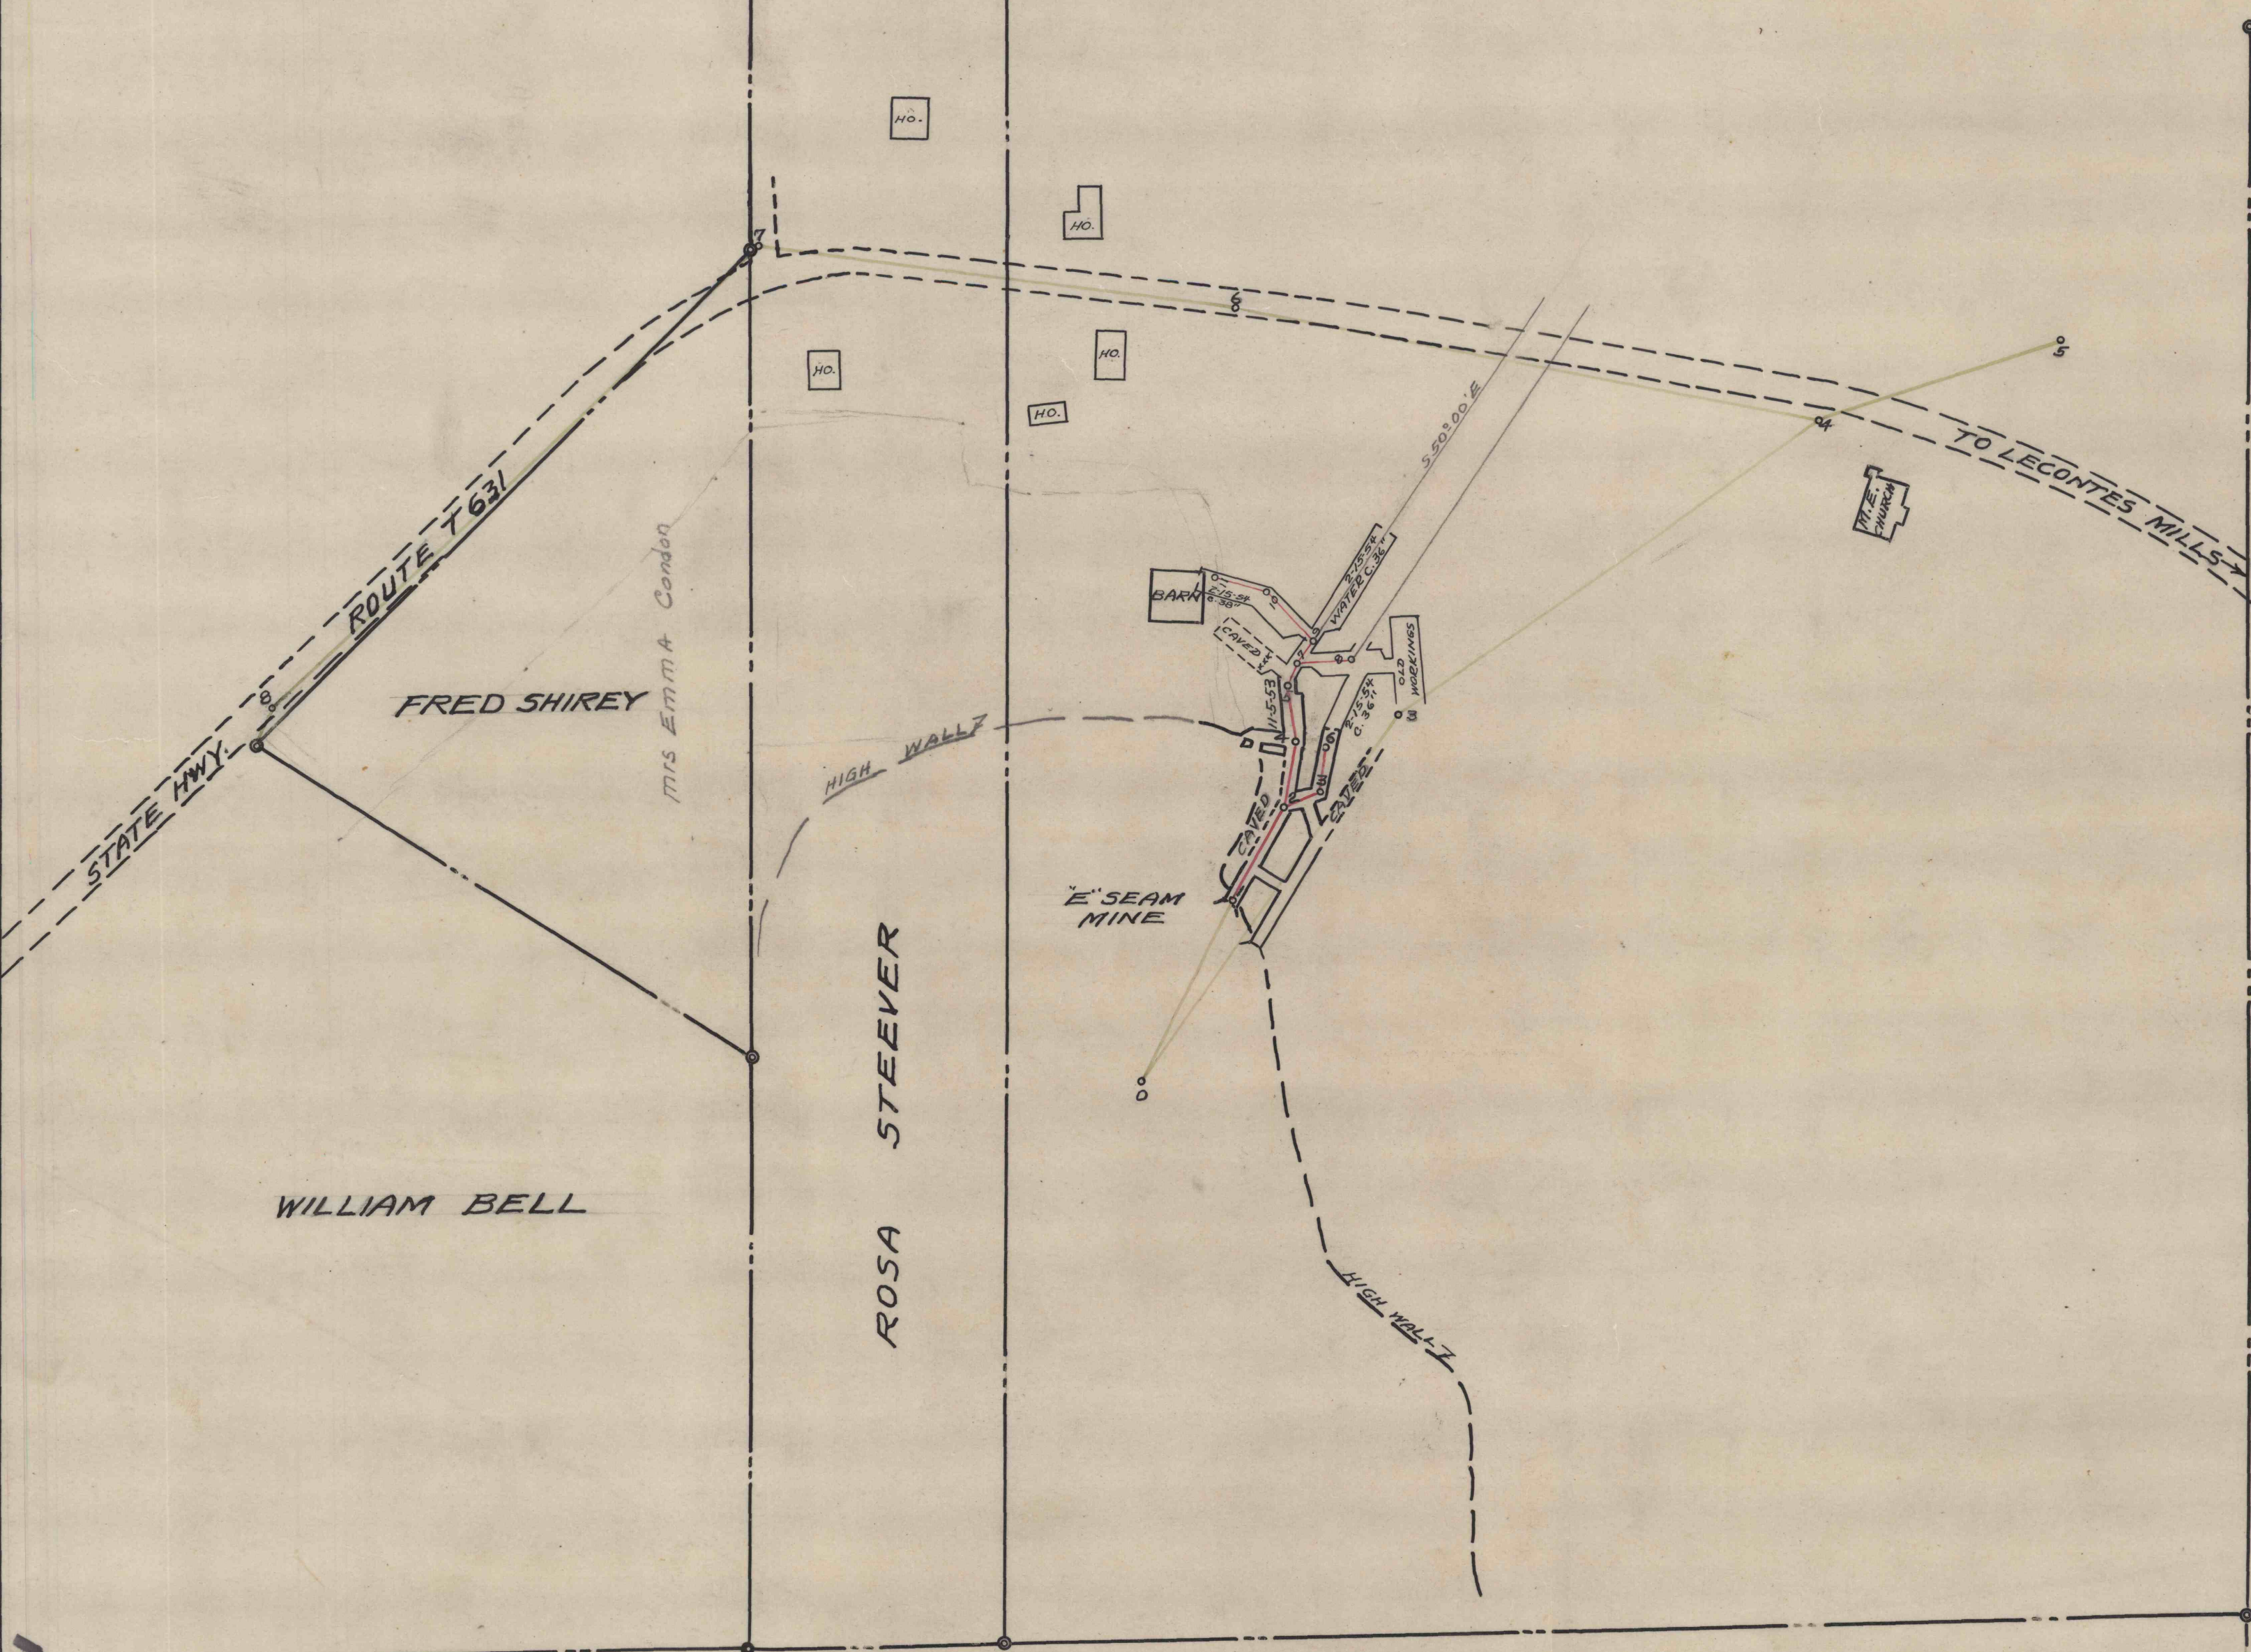

LANE BILLOTTE

DM

BORON BROTHERS COAL CO.  
MAP OF E SEAM MINE  
GIRARD TWP CLEARFIELD COUNTY, PA.  
SCALE 1" = 100' NOV. 10, 1953  
Bernard Lucas ENGR.

C.D. 289