


SHOEMAKER COAL MINING CO.
MAP OF
WILMORE - NO. 1 - MINE
or lands of
CAMBRIA MINING & MANUFACTURING CO.
SONMAN, CAMBRIA CO., PA.

SCALE 1" = 100'

John R. ...
CIVIL & MINING ENGINEERS

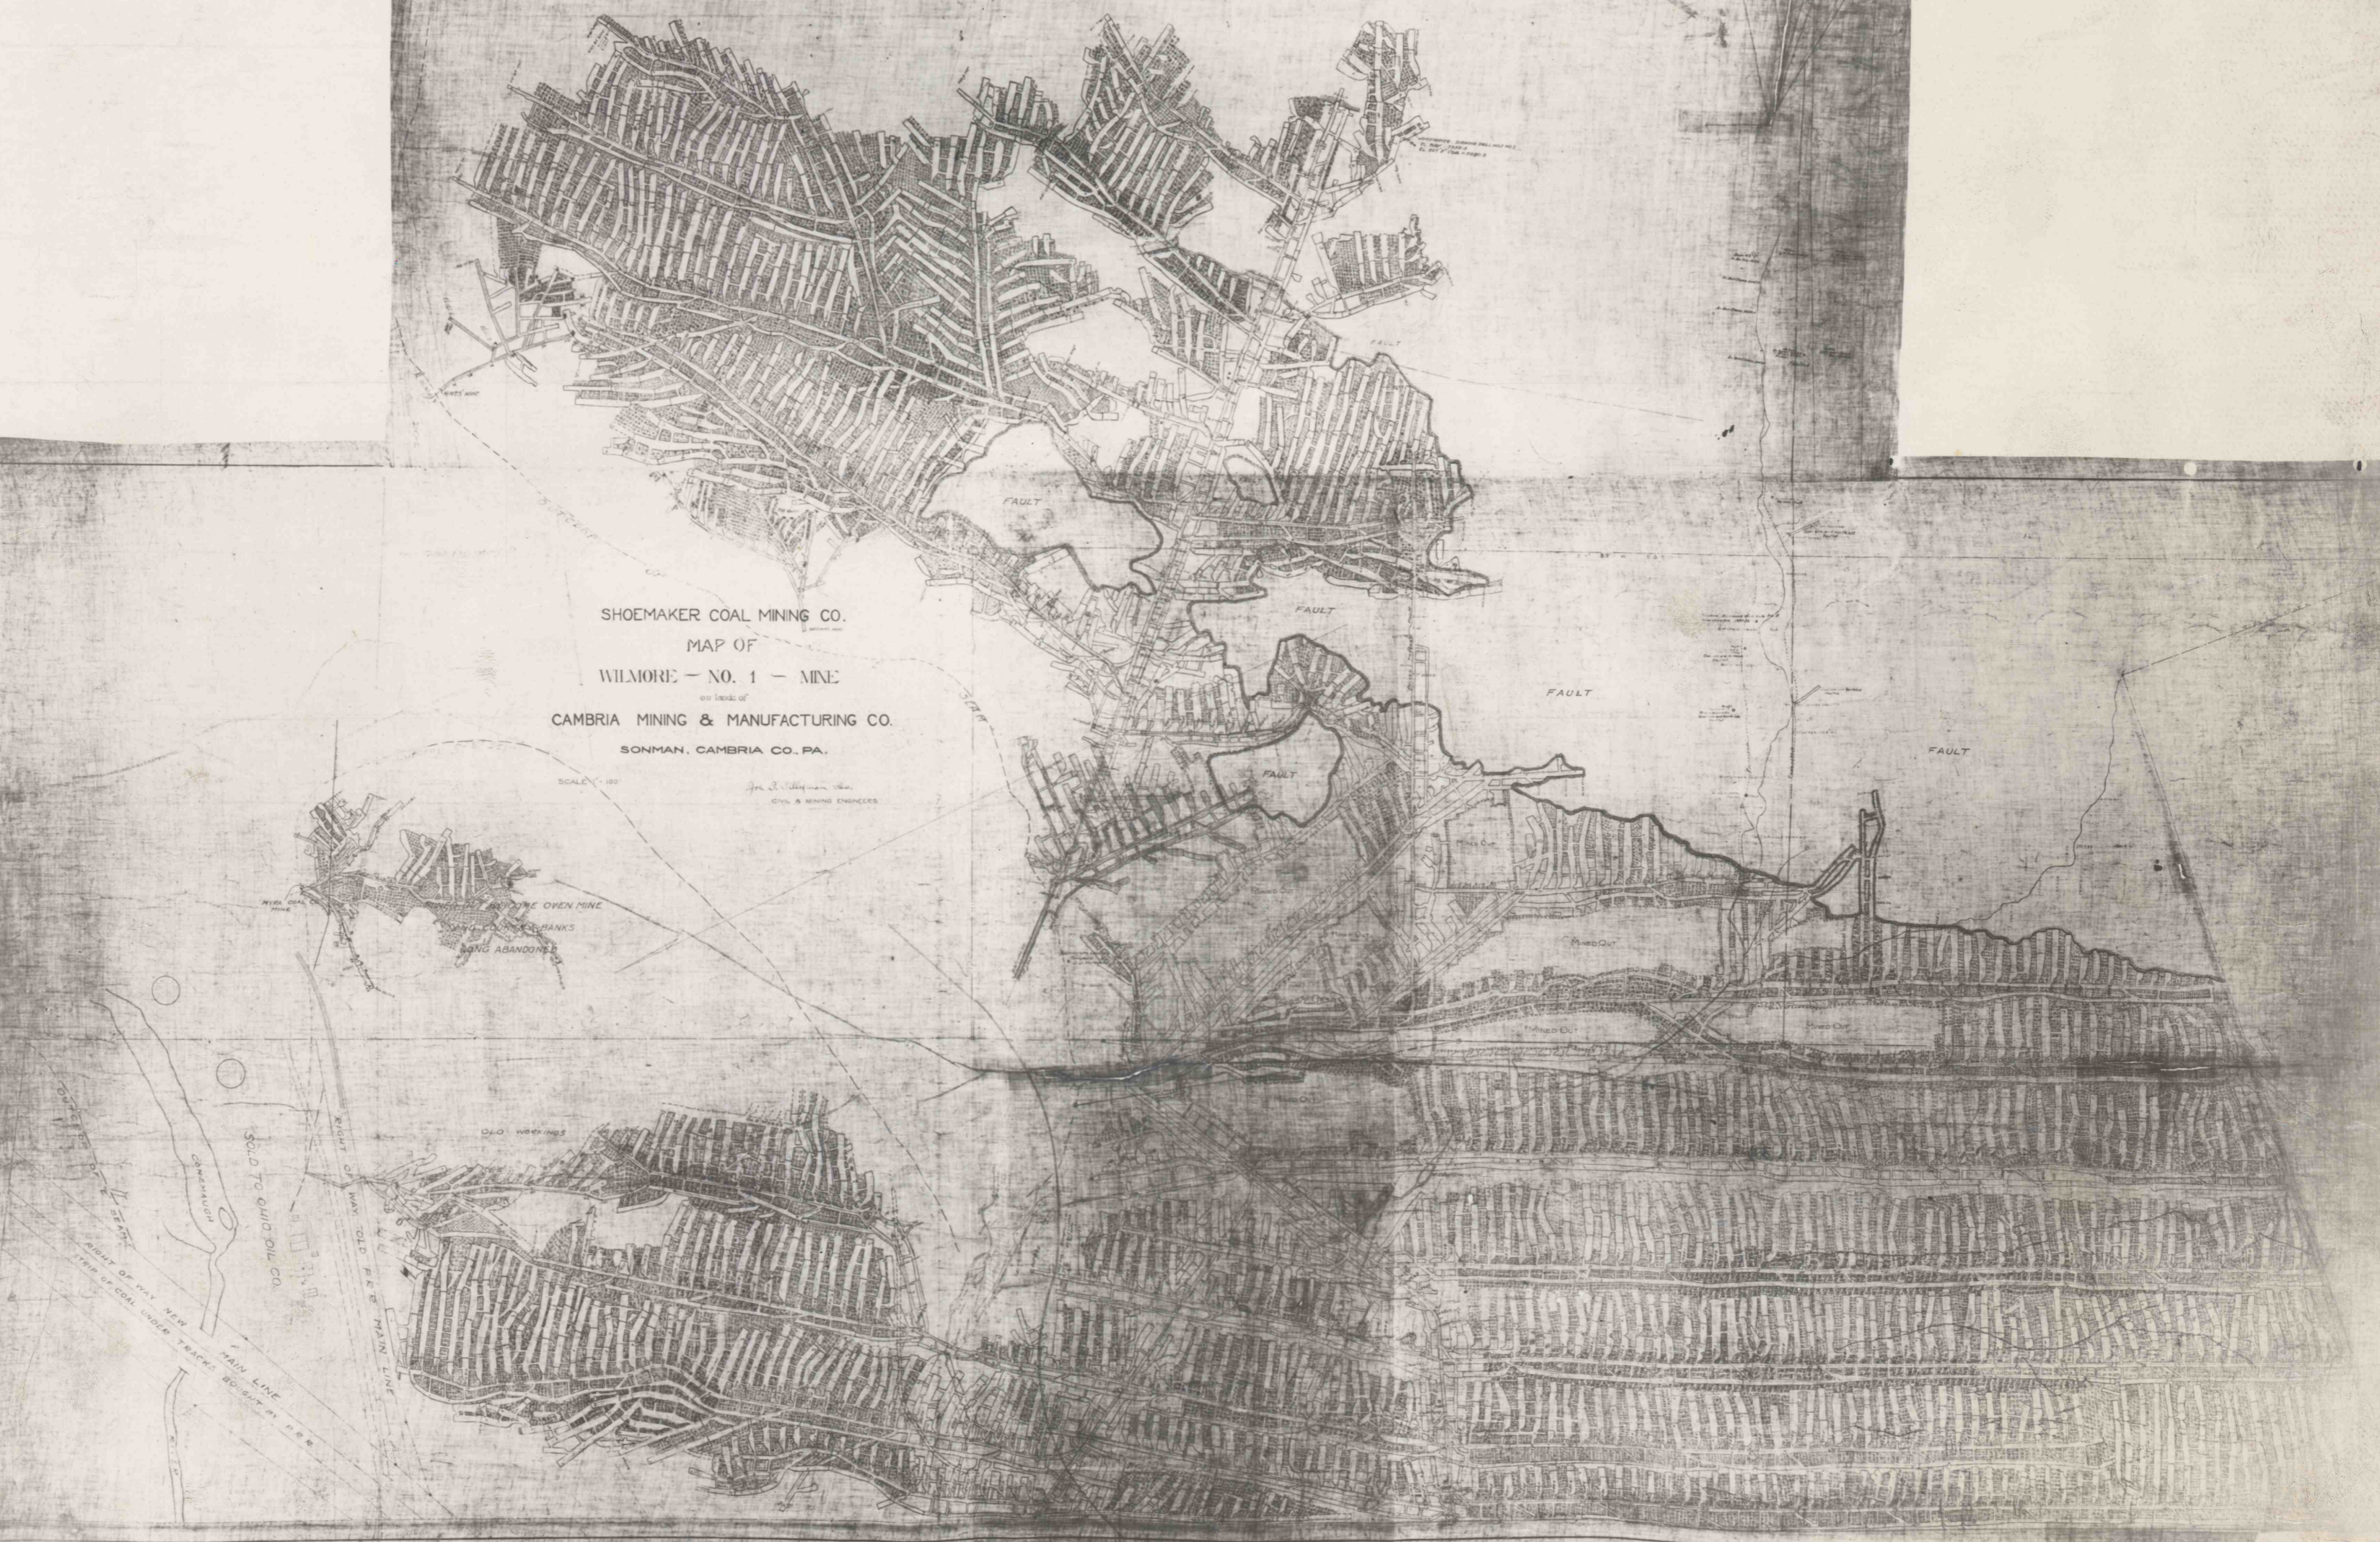

WILMORE COAL MINE
OR LINDSAY OVEN MINE
AND COAL SHANKS
NOW ABANDONED


RIGHT OF WAY OLD P. & E. MAIN LINE

OLD WORKINGS

MAIN LINE

RIGHT OF WAY NEW MAIN LINE

TRIP OF COAL UNDER TRACKS

P. & E.