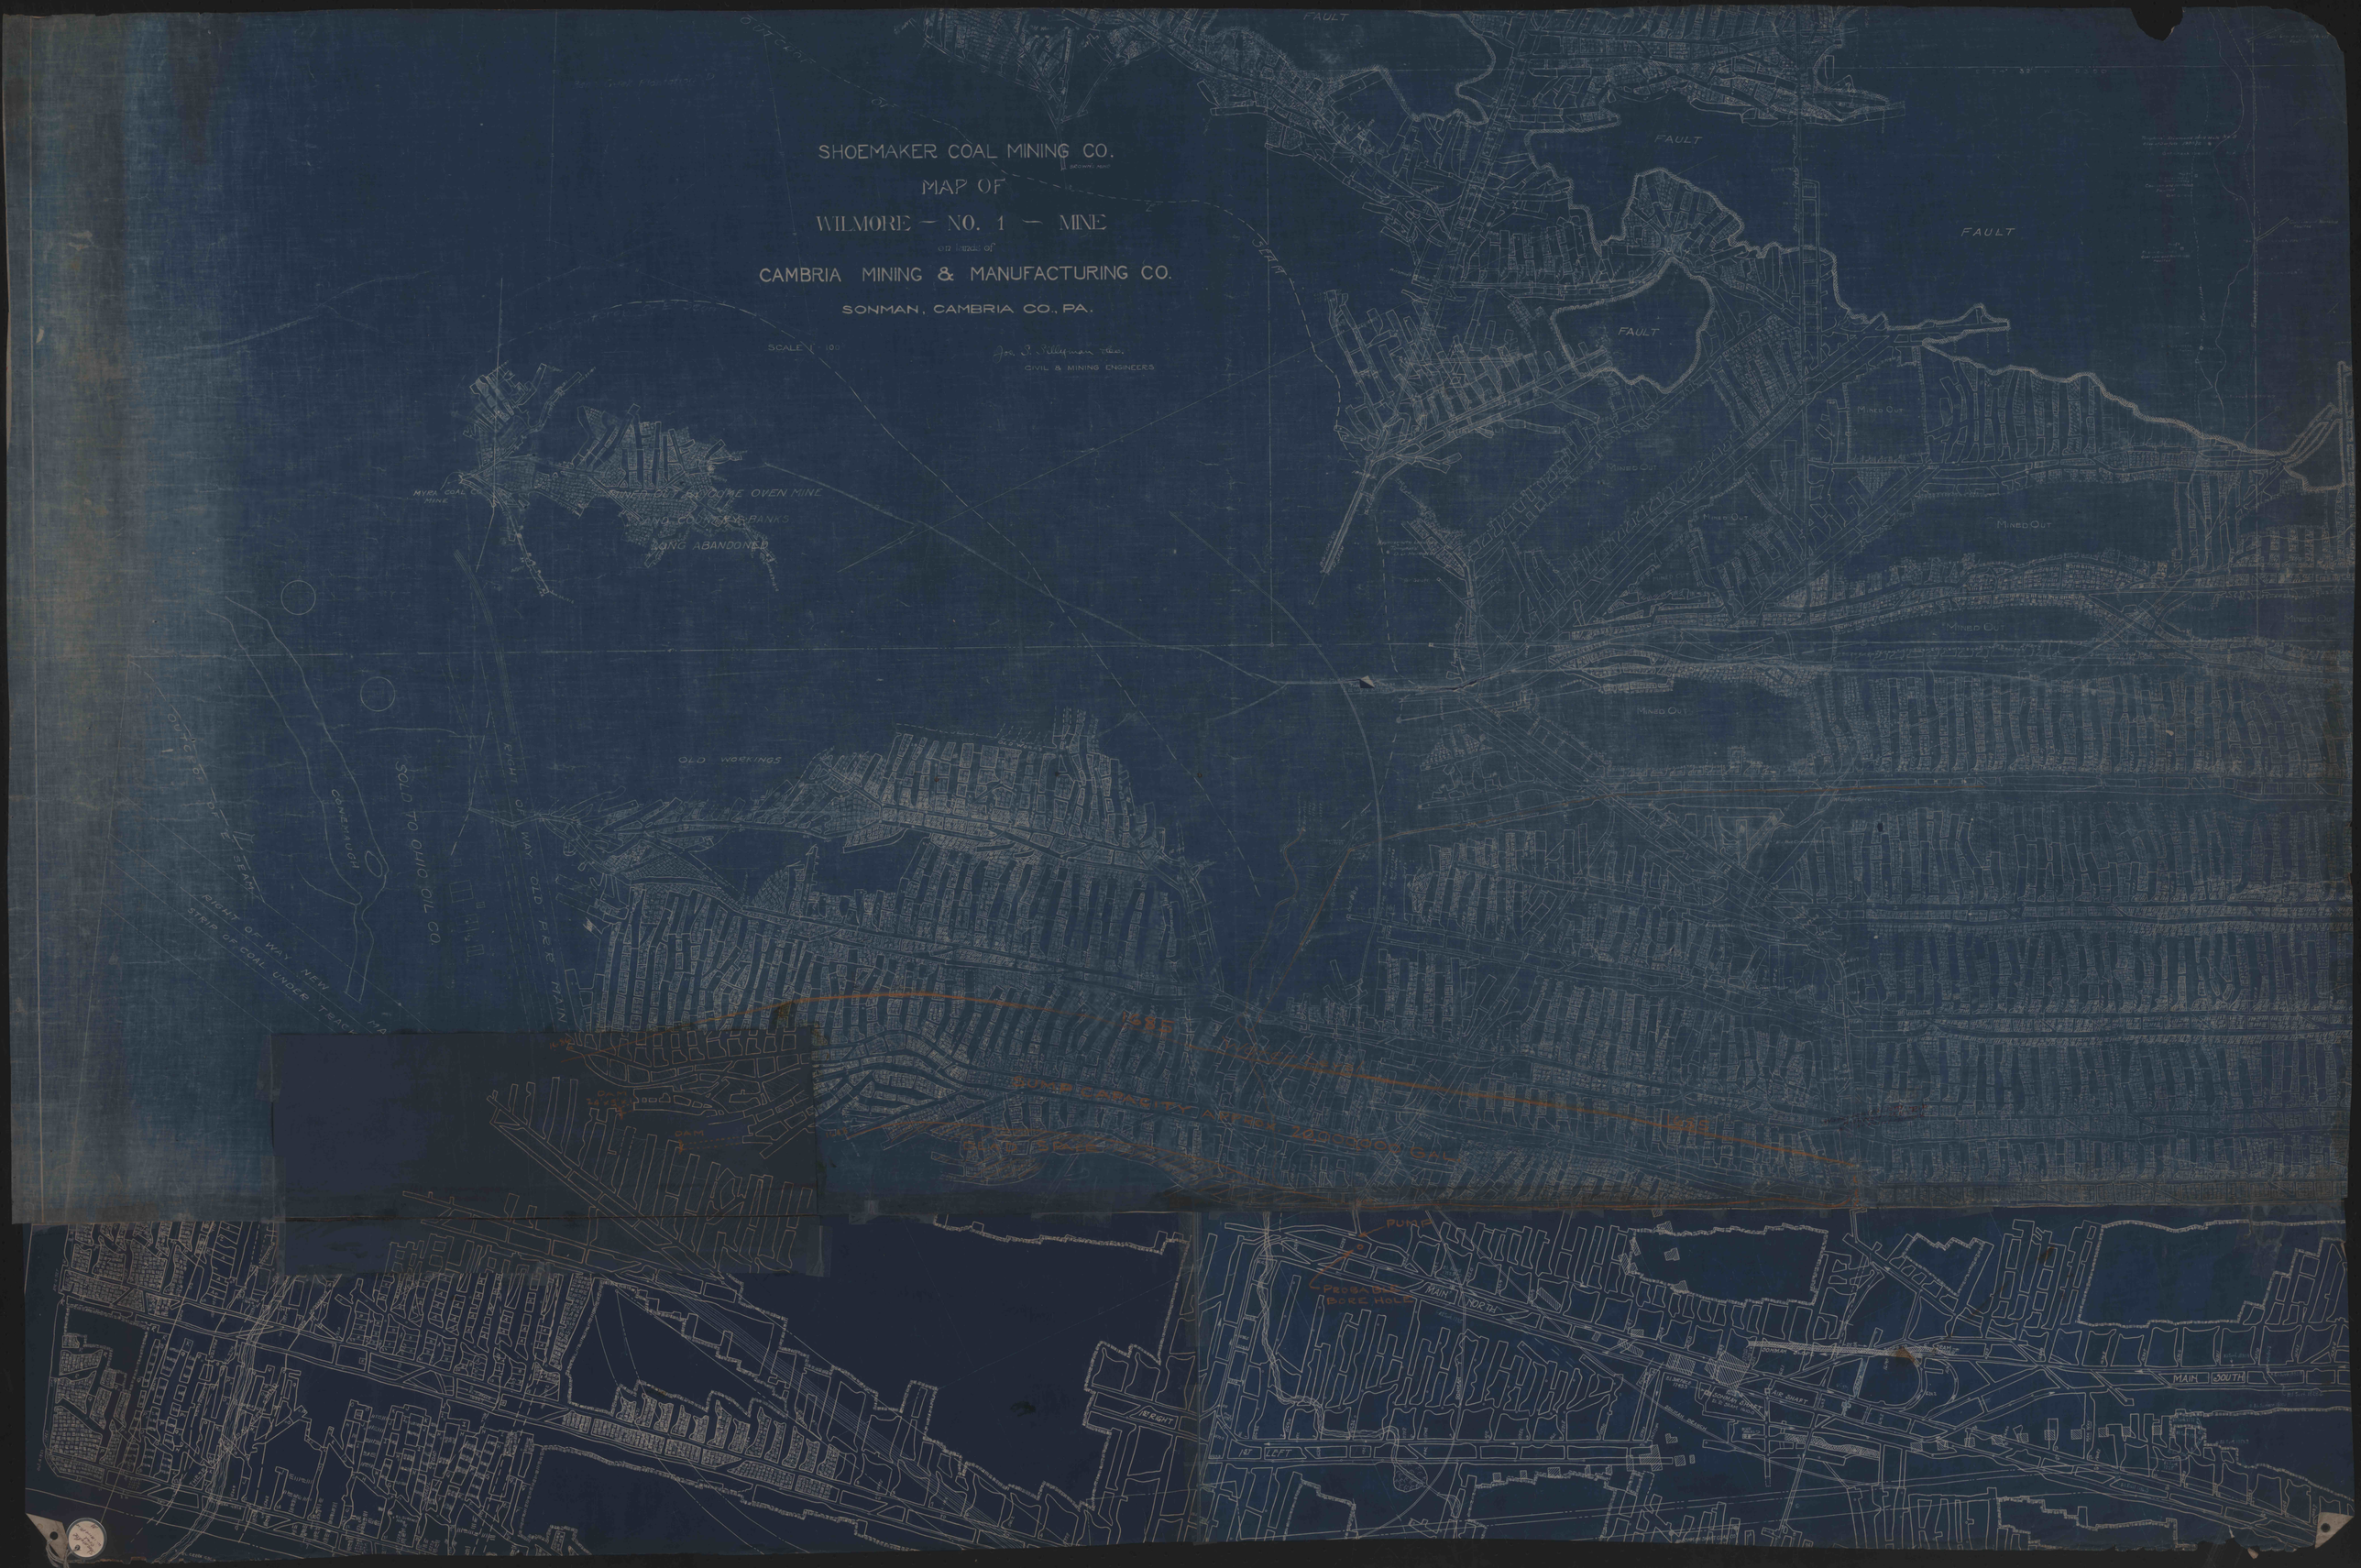
SHOEMAKER COAL MINING CO.
MAP OF
WILMORE — NO. 1 — MINE
on lands of
CAMBRIA MINING & MANUFACTURING CO.
SONMAN, CAMBRIA CO., PA.
SCALE 1" = 100'
Jos. S. Silliman Jr.
CIVIL & MINING ENGINEERS
FAULT
FAULT
FAULT
FAULT
MINED OUT
MINED OUT
MINED OUT
MINED OUT
MINED OUT
MINED OUT
MINED OUT
MINED OUT
MYRA COAL CO. MINE
MINED OUT BY COKE OVEN MINE
LONG ABANDONED
OLD WORKINGS
OUTCROP OF E. SEAM
RIGHT OF WAY NEW MA
STRIP OF COAL UNDER TRACK
CONEMAUGH
OLD TO OHIO OIL CO.
OLD WAY OLD P.R.R. MAIN
DAM
DAM
PUMP
PROBABLE BORE HOLE
MAIN NORTH
MAIN SOUTH
1ST RIGHT
1ST LEFT
SONMAN SHAFT
AIR SHAFT