


4495

834

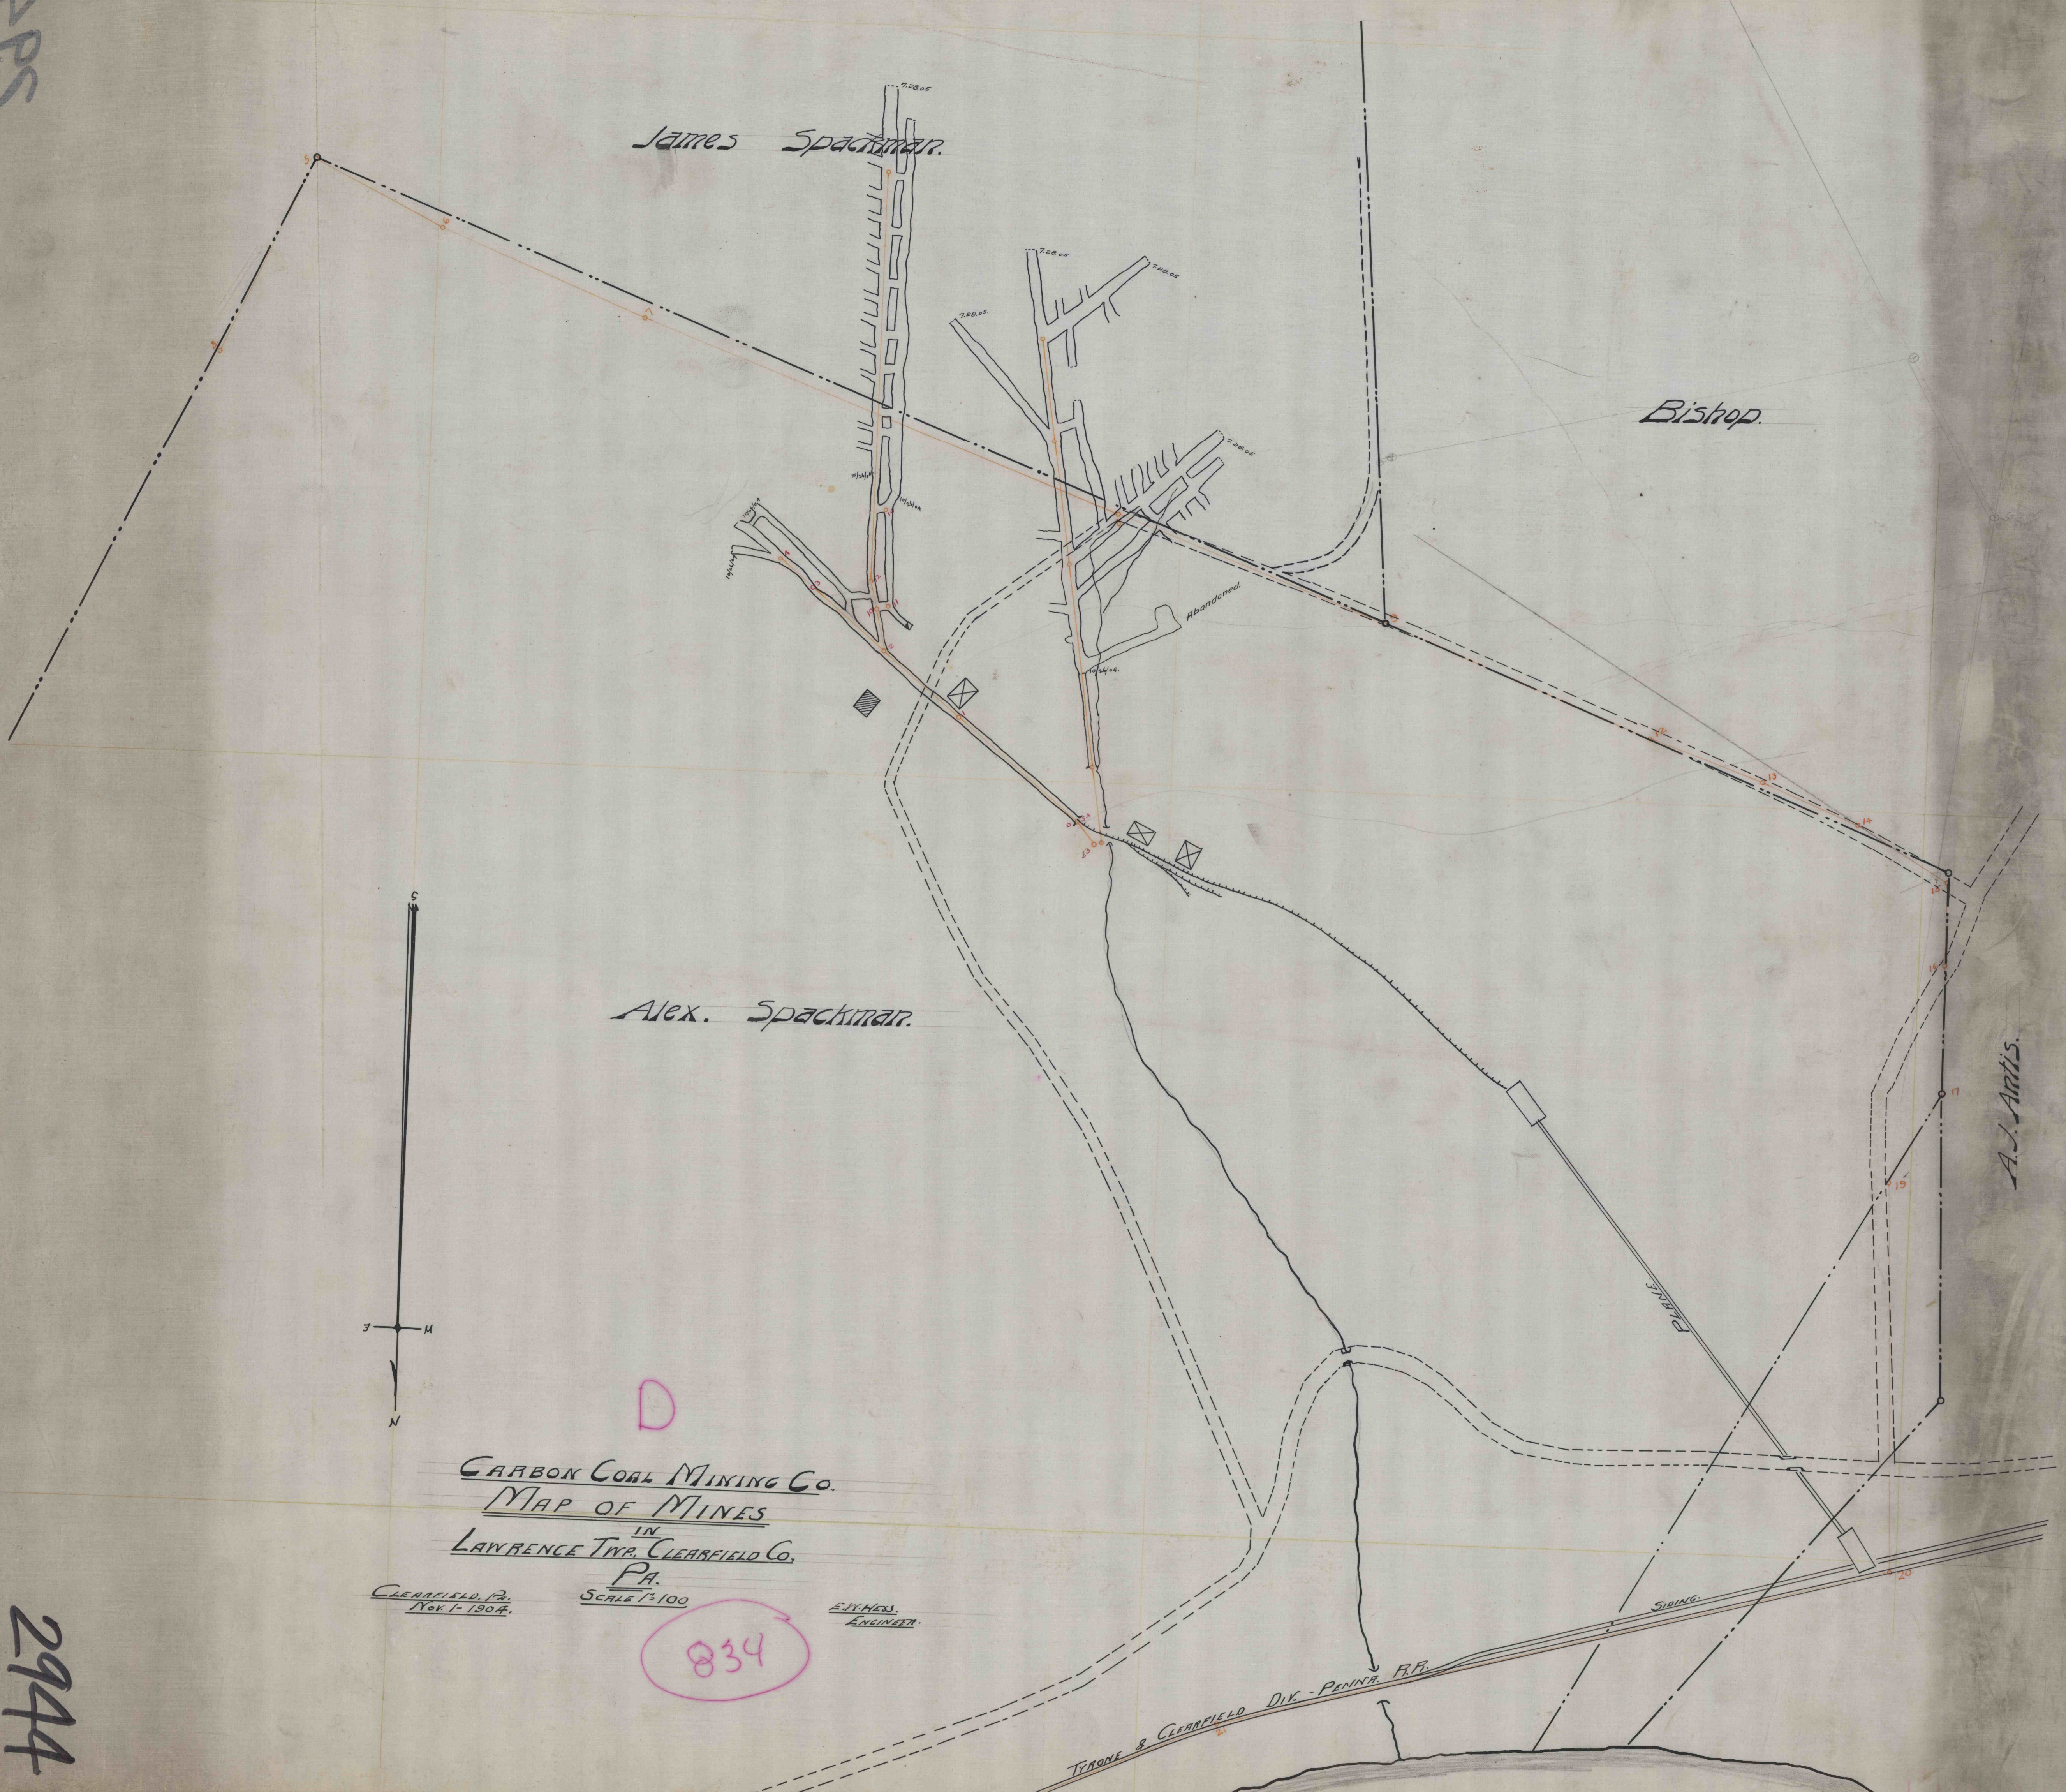

James Spackman.

Bishop.

Alex. Spackman.

A.J. Antis.

Abandoned.

Siding.

TYNDE & CLEARFIELD DIV. - PENNS. R.R.

CARBON COAL MINING CO.  
 MAP OF MINES  
 IN  
 LAWRENCE TWP. CLEARFIELD CO.  
 PA.  
 CLEARFIELD, Pa.  
 Nov. 1, 1904.

SCALE 1" = 100'

E. J. HERS  
ENGINEER.

834

2944

858