


PHILIP MCCracken.

D. A. McCracken.

A. J. Smith.

Notes.

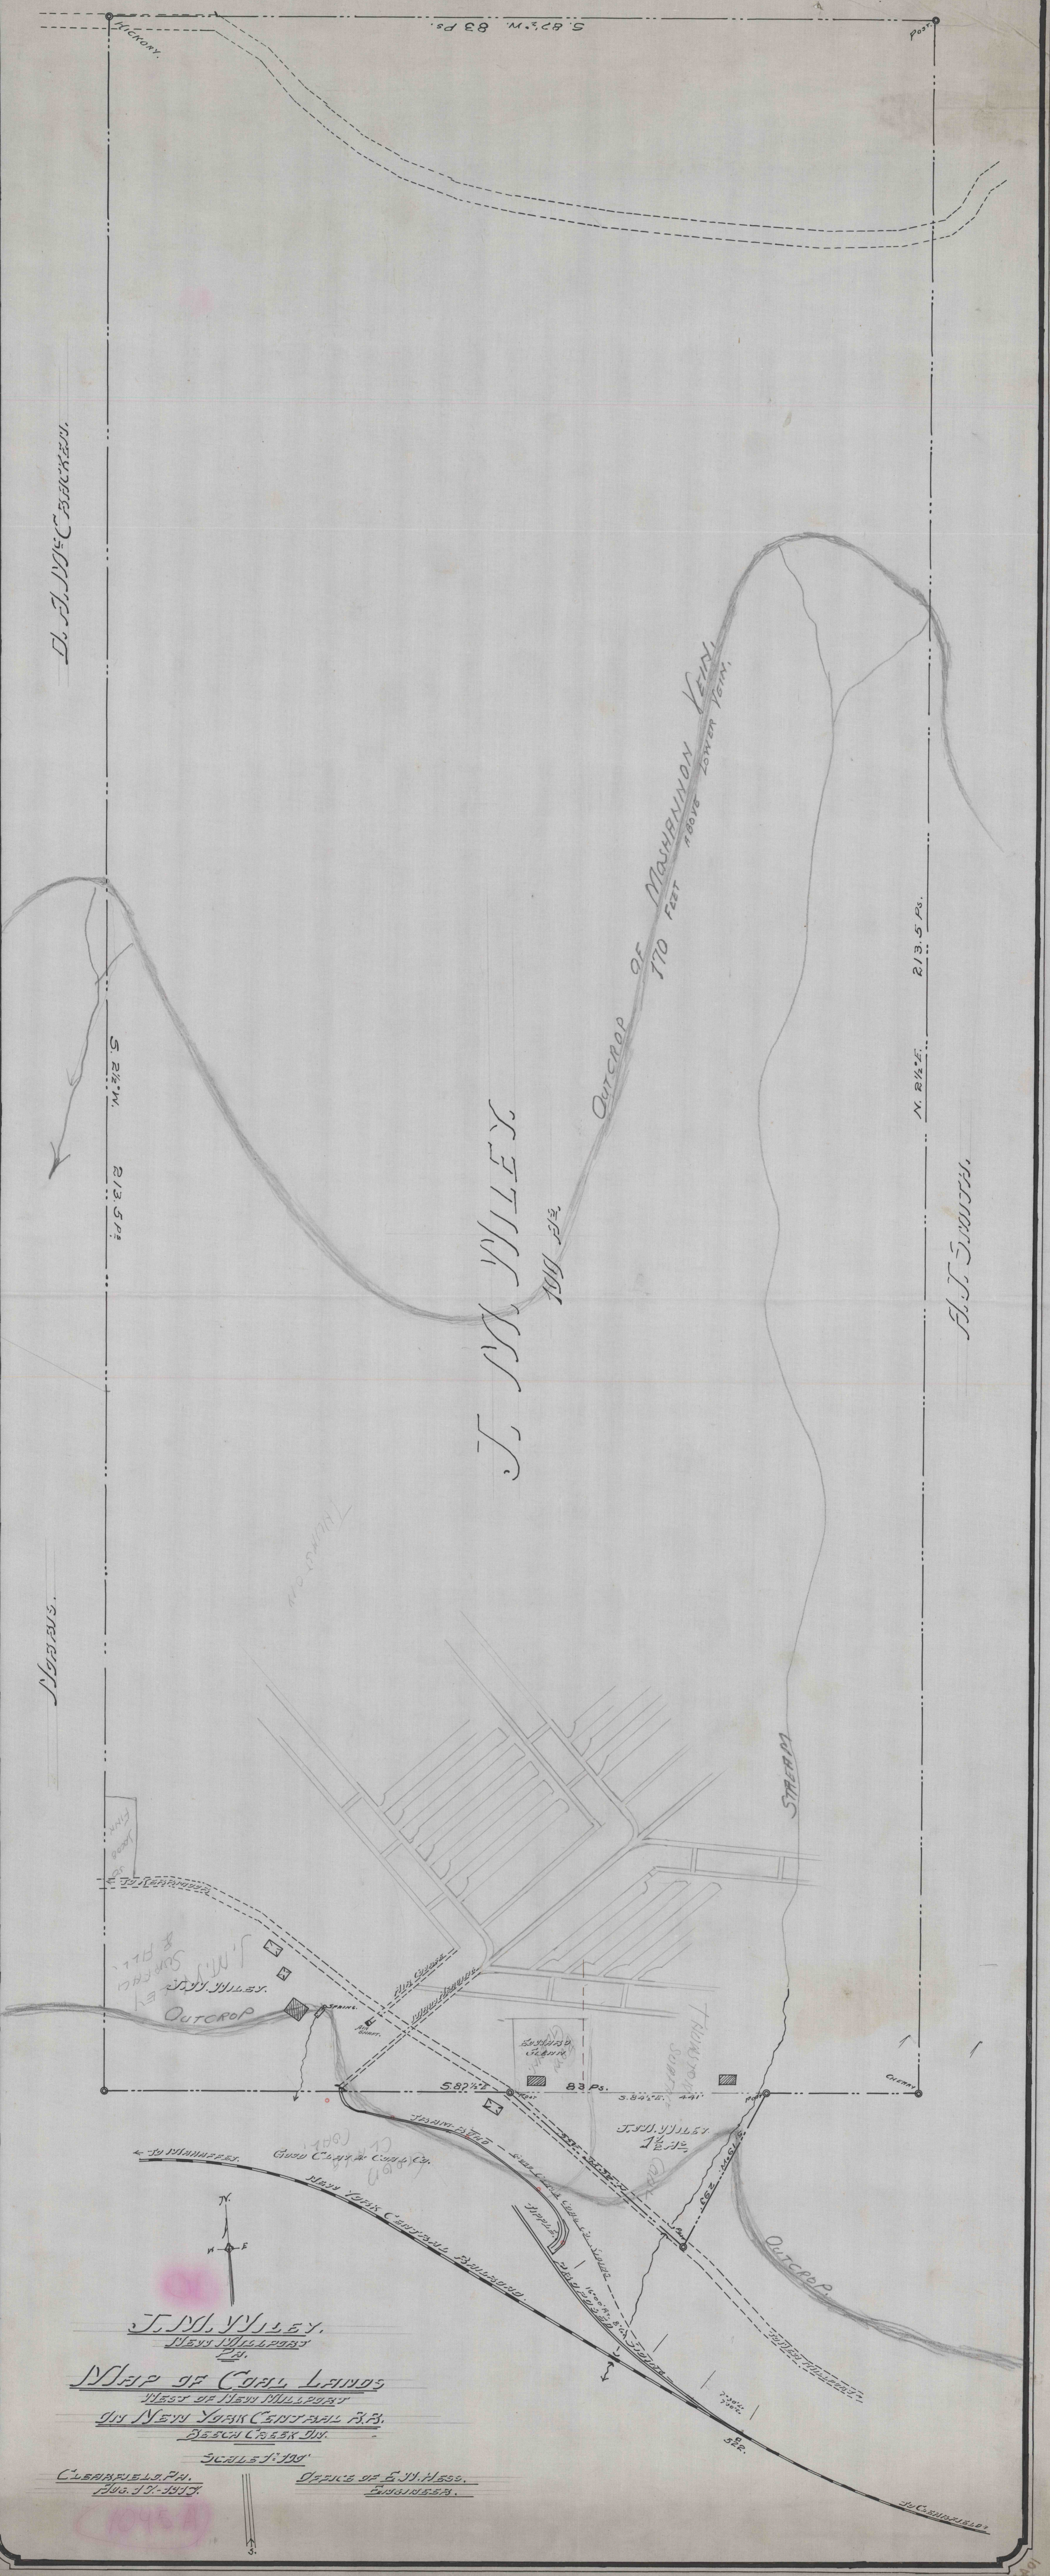

J. M. WILLEY,  
 NEW MILLPORT PA.  
 MAP OF COAL LANDS  
 WEST OF NEW MILLPORT  
 IN NEW YORK CENTRAL R.R.  
 BEACH CREEK DIV.  
 SCALE 1" = 100'

CLEARFIELD PA. OFFICE OF E. J. HESS.  
 AUG. 10. 1903. ENGINEER.

2955