



MAP SHOWING
WORKINGS ON 'B' SEAM
CAMBRIA-MOSHANNON COAL CO.
MOUNTAINDALE, CAMBRIA CO., PA. J.S. SULLYMAN & CO. ENGRS.
SCALE - 1"=100' ALTOONA, PA.
TRACED BY THE OFFICES OF ENY & OP HESS 10-3-41

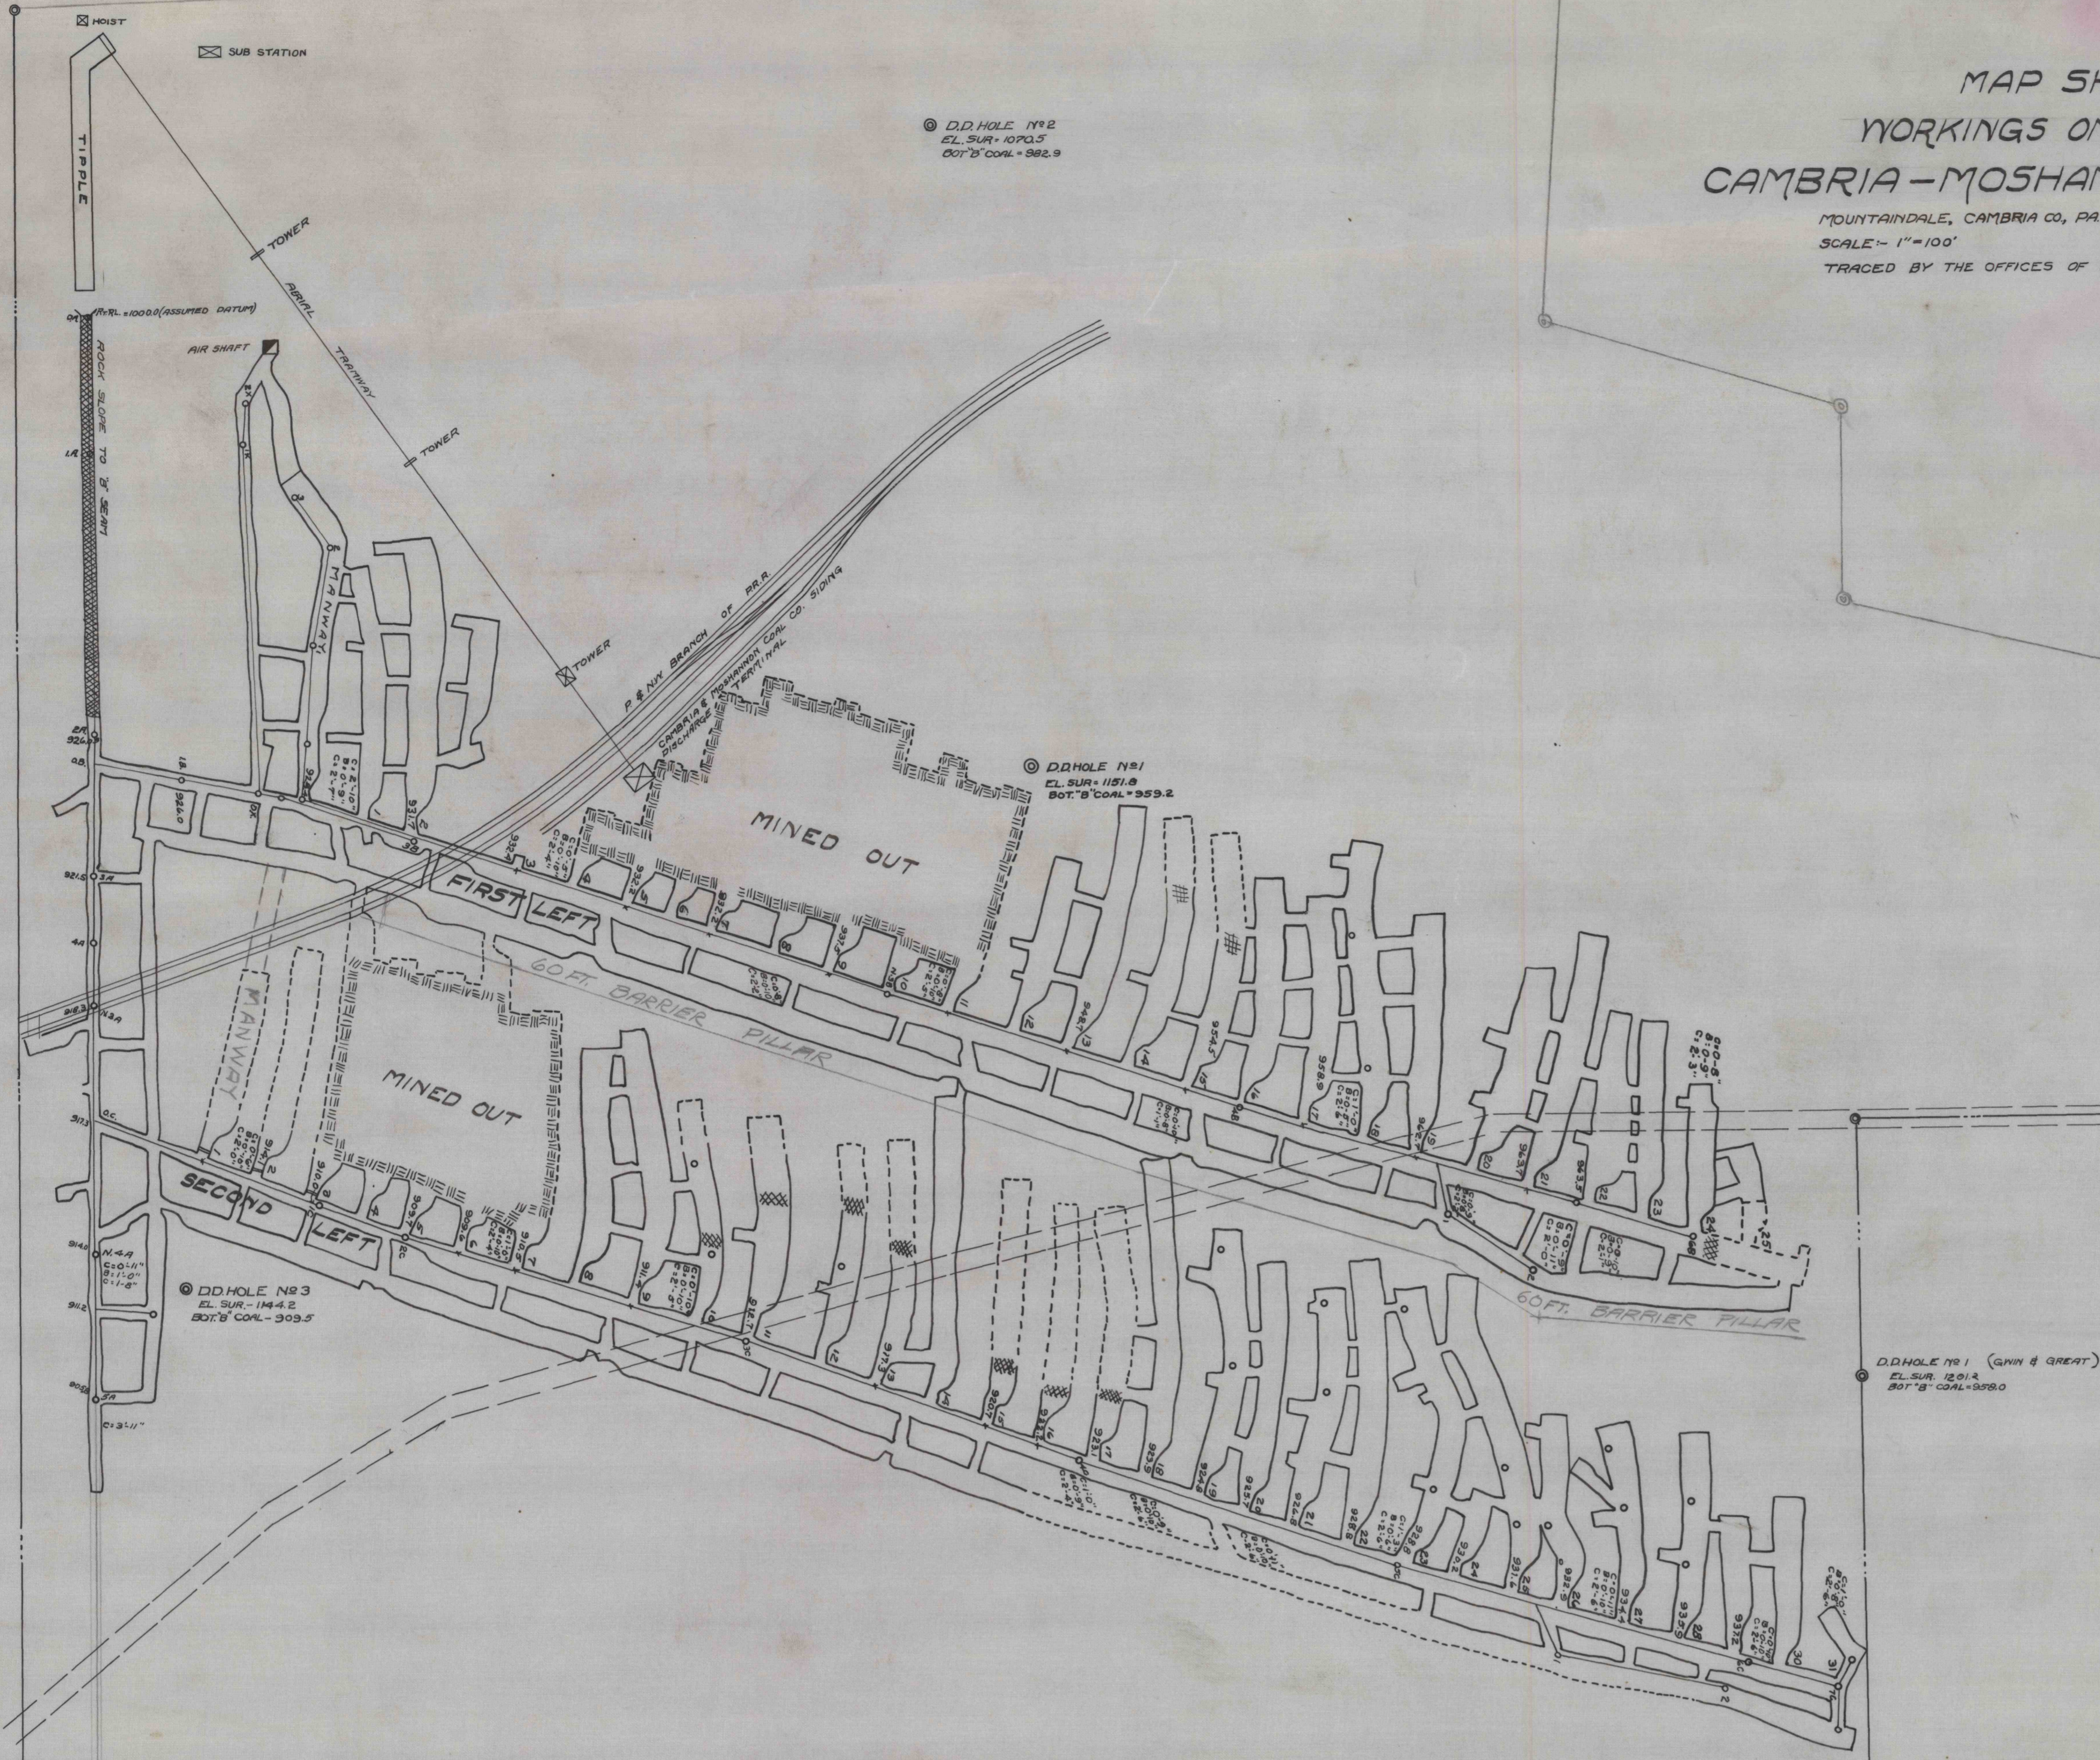

'B' & 'C' COAL

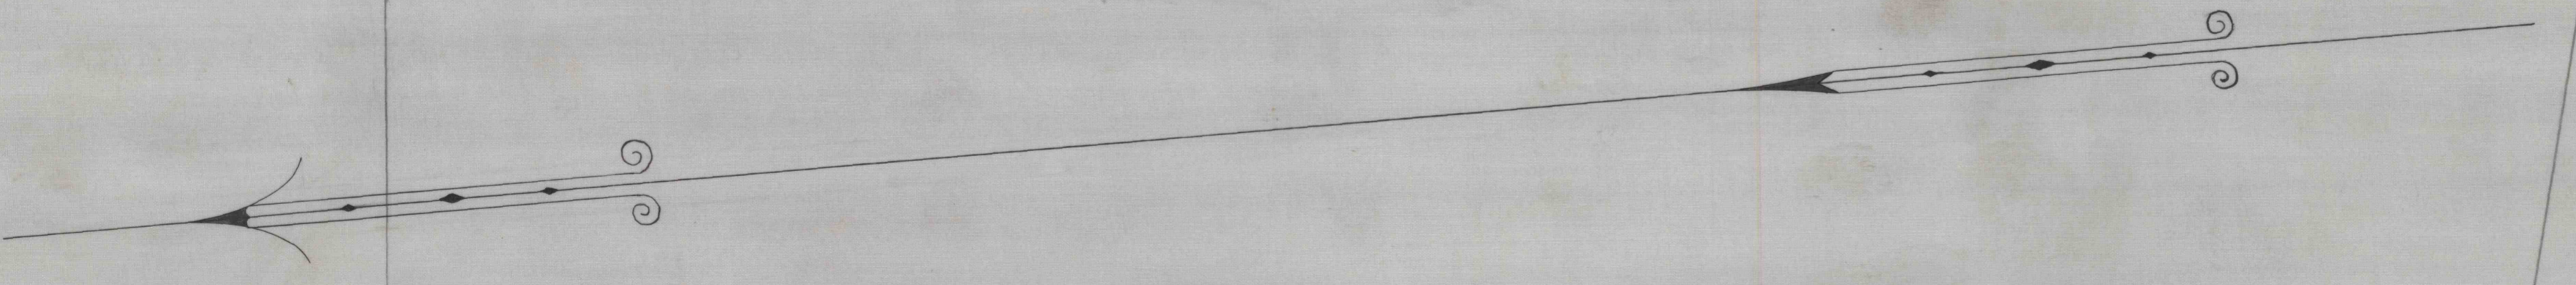

528

2958