


MAPES

2983

JOHN S. WRIGLEY (SURFACE)  
CLEARFIELD CLAY WORKING CO. (COAL)

GRANT SHELLOW (SURFACE)  
KREBS COAL CO. (COAL)  
E VEIN AREA OF WORKABLE COAL 34.5 ACRES

JAMES WRIGLEY

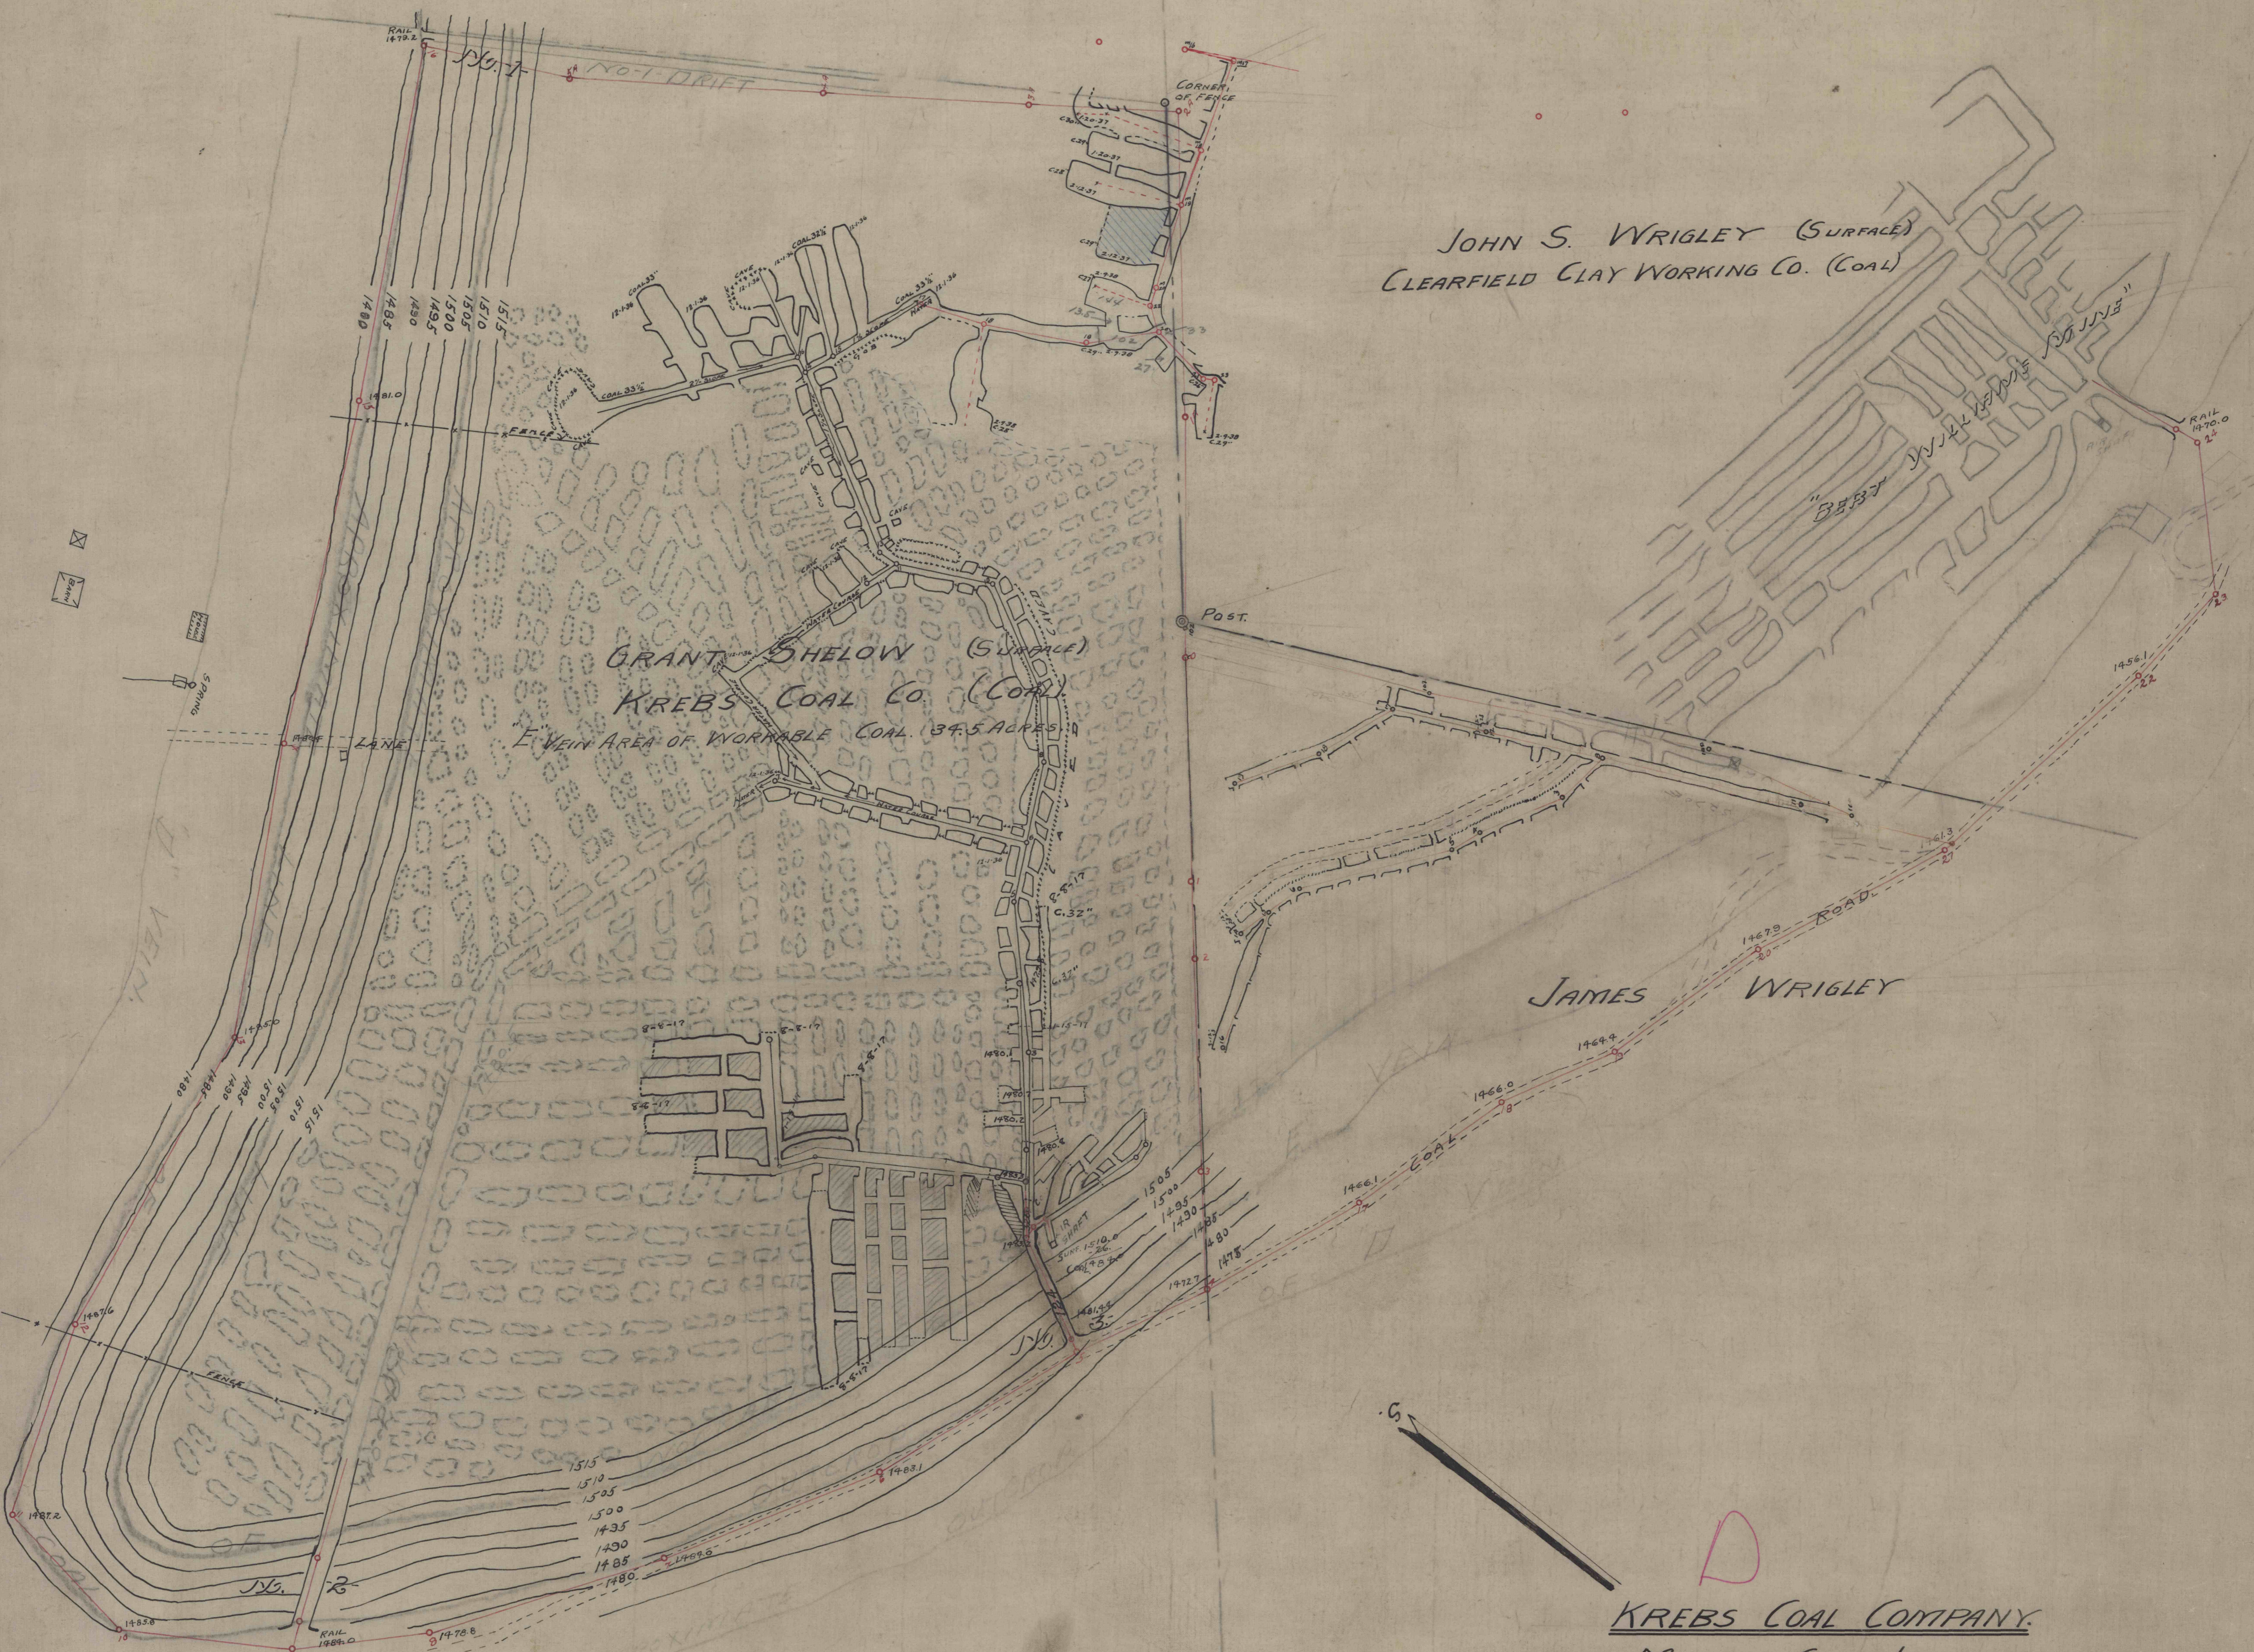

**KREBS COAL COMPANY.**  
**MAP OF COAL LAND**  
**LAWRENCE TWP. CLEARFIELD CO. PA.**  
**SCALE 1"=100'**


CLEARFIELD PA  
JULY-18-1915.

RESURVEY  
JANUARY-15-1917  
AUGUST-18-1917

FEBRUARY-9-1938 - *[Signature]*

OFFICE OF E. W. HESS  
ENGINEER

1052-B

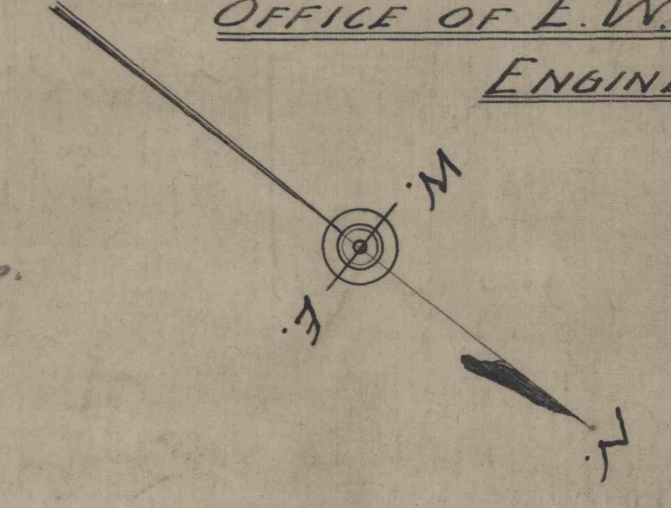

2983