

Shaw & Wilson


Guy & Maud Kyler

Property Lines plotted from Description

S. F. Owens  
31A<sup>2</sup> - 48P.±



S. F. Owens  
55A<sup>2</sup> - 132P.±

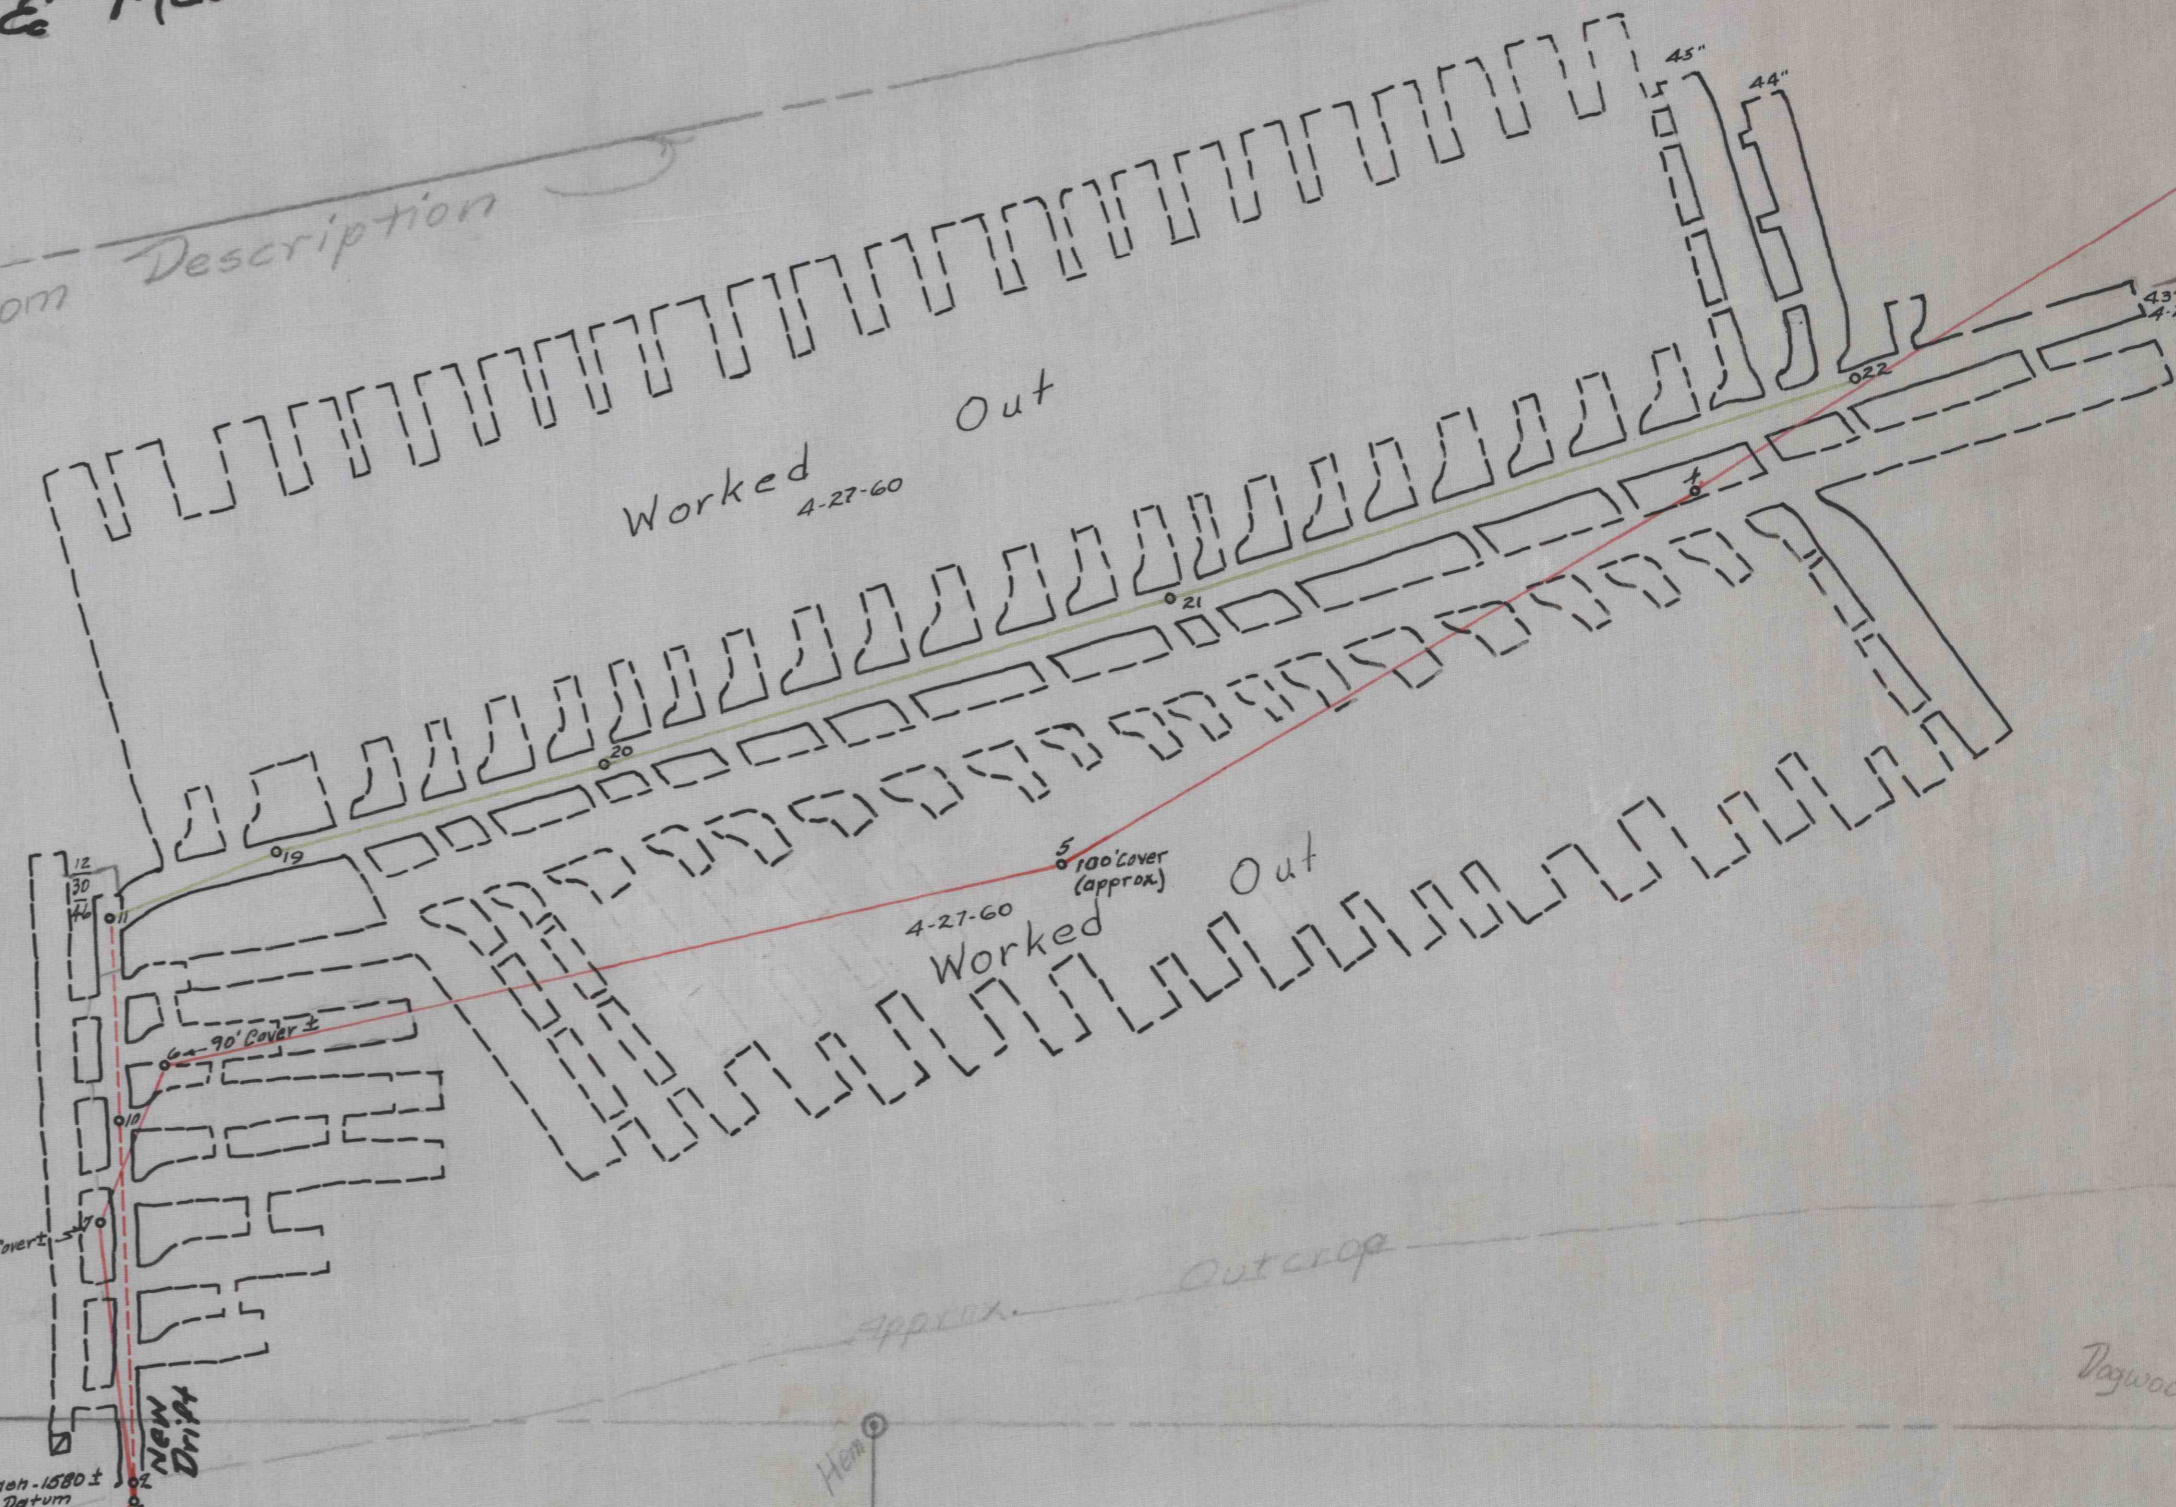

Present Magnetic North  
7.86 H. Azimuth

Map Showing Coal Operations of  
**S. F. Owens**  
 Goshen Twp., Clearfield Co., Pa.  
 SCALE - 1 in. = 100 ft.  
 Dec. 31, 1946 Engineering Offices  
 Clearfield Pa. Yost, Bramfield & Hess.  
 NBYR55P33-59

2989

Carl Kramer

2885

Chas. Livergood Est.

Spanish Dat

MA 140

Property lines plotted from Description

Dogwood