


2996

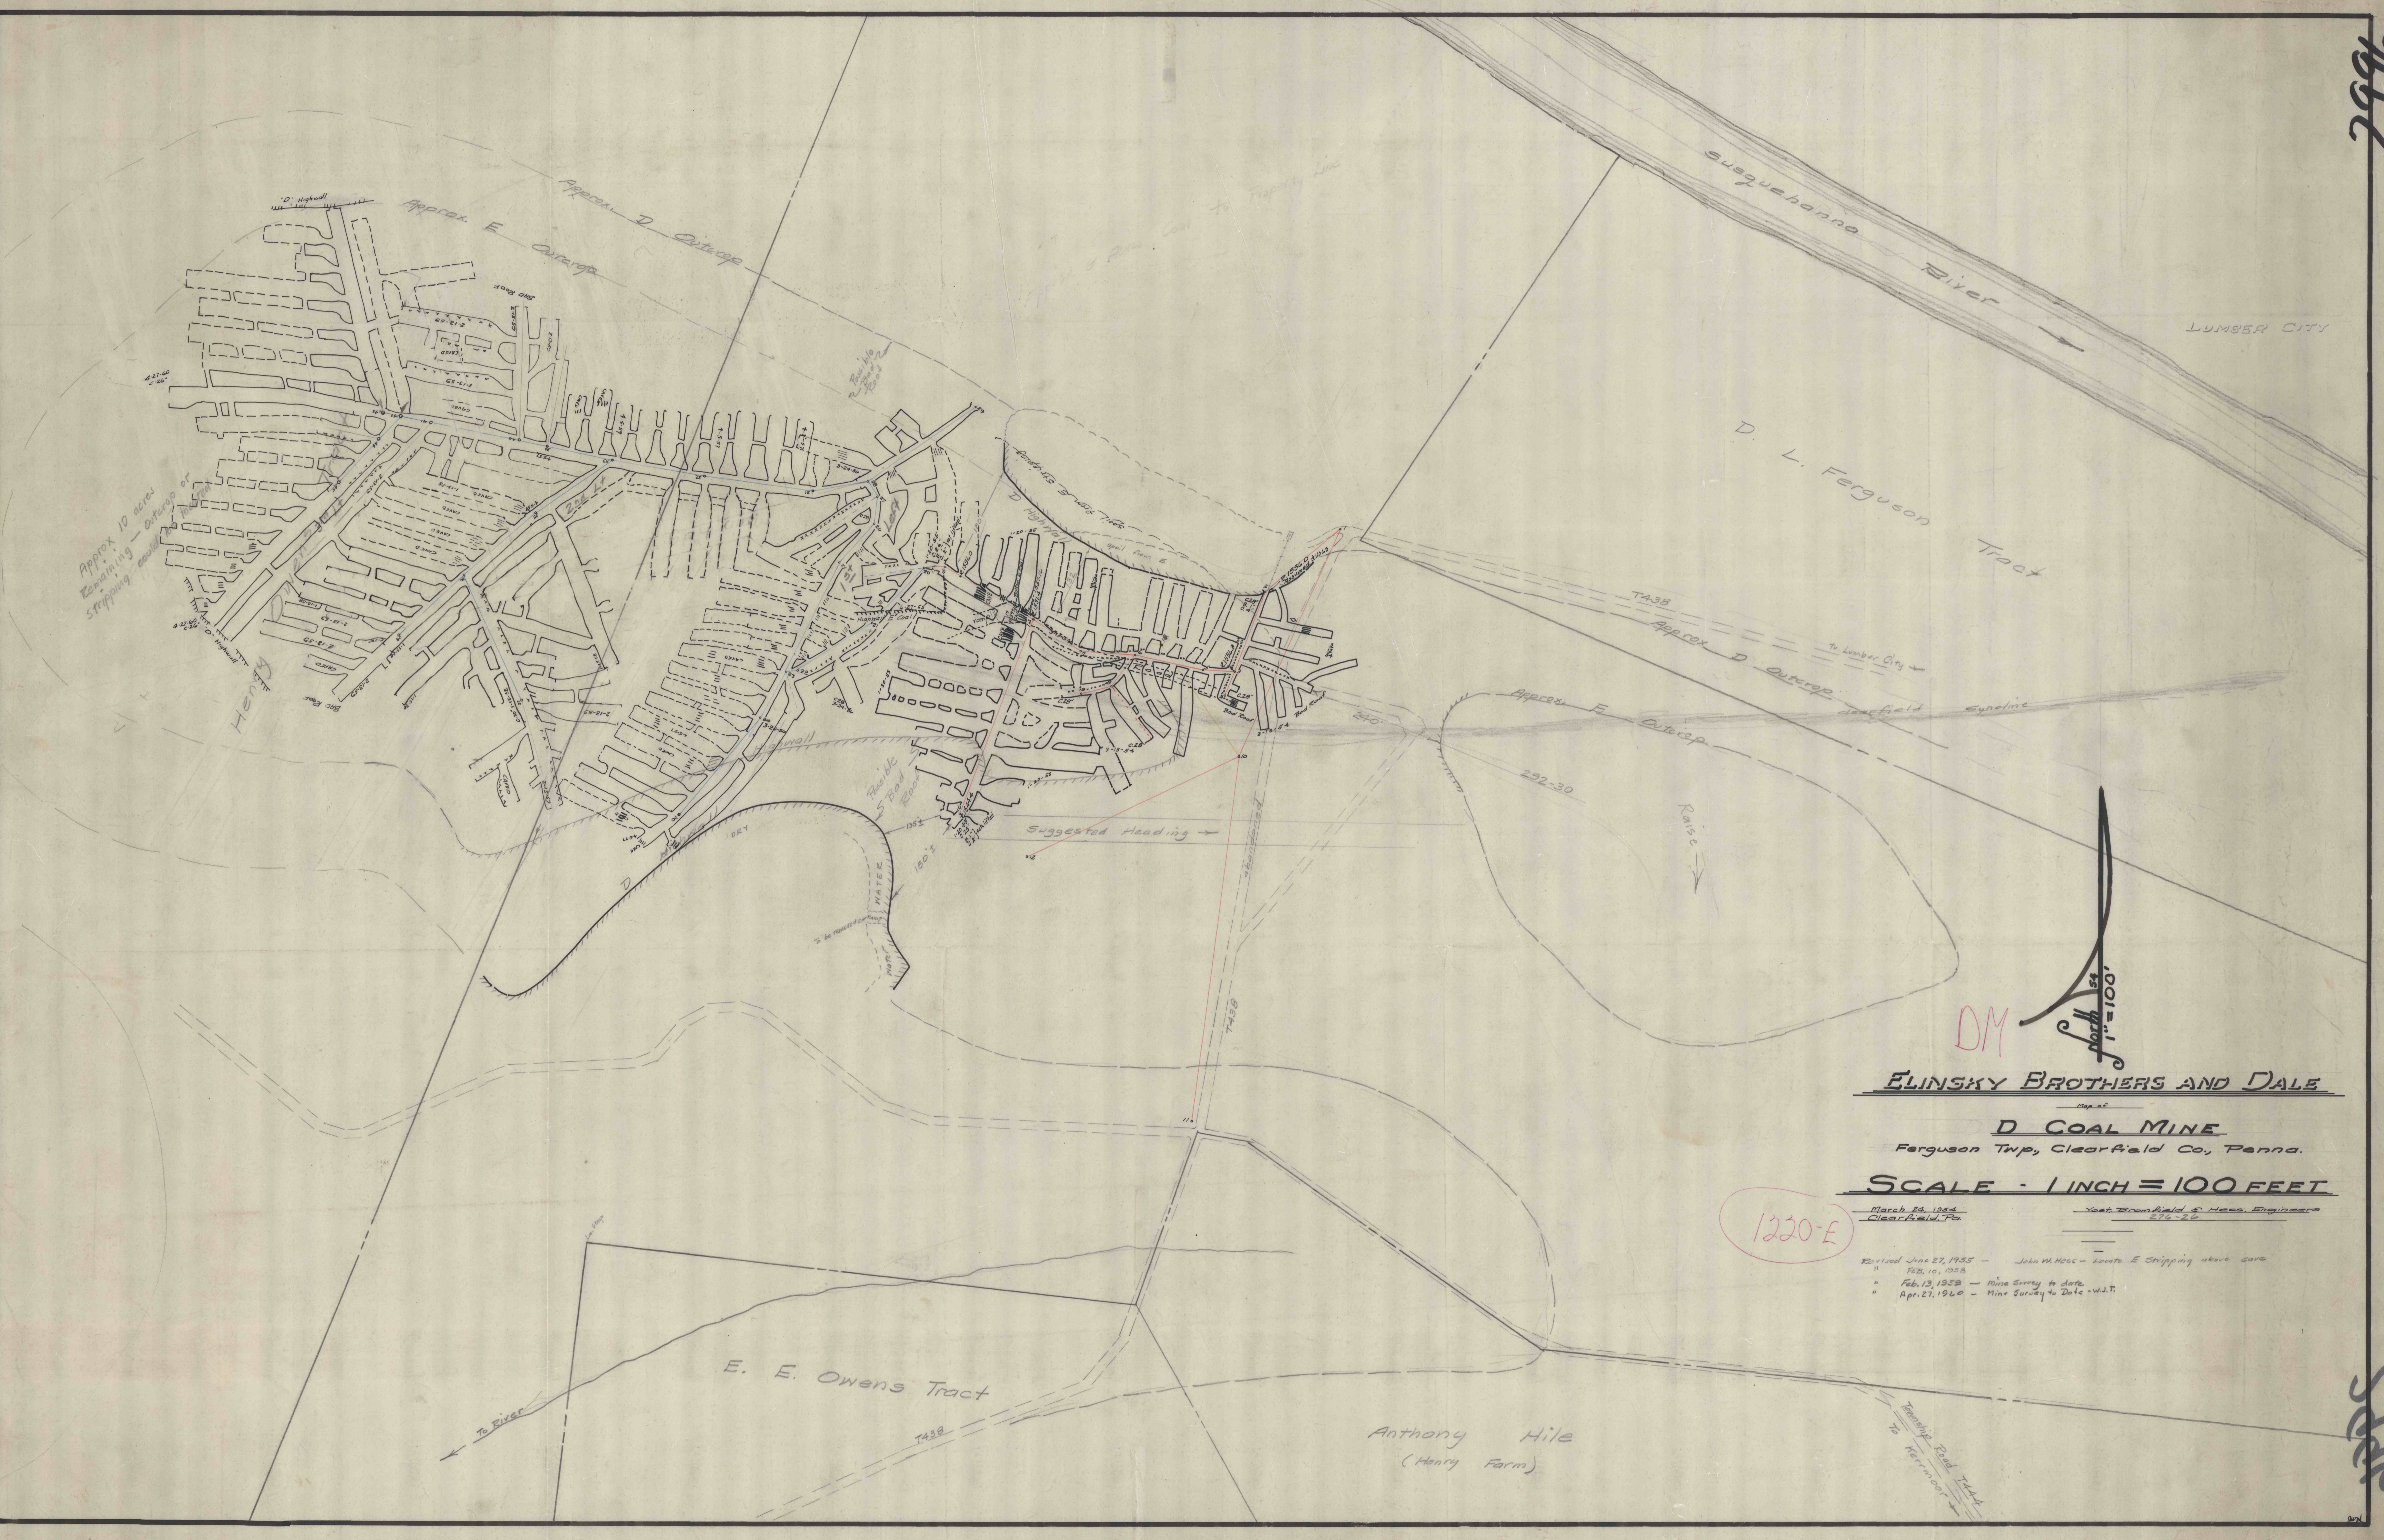

D COAL MINE

Ferguson Twp, Clearfield Co, Penna.

SCALE - 1 INCH = 100 FEET

March 24, 1964 - Clearfield, Pa. East Branchfield & Hess, Engineers 276-26

1220-E

- Revised June 27, 1955 - John W. Hess - Locate E Shipping above cave
- " Feb. 10, 1958
- " Feb. 13, 1959 - Mine Survey to date
- " Apr. 27, 1960 - Mine Survey to Date - W.J.T.

5195